




PLAN AT FOOTING
SCALE 1:50

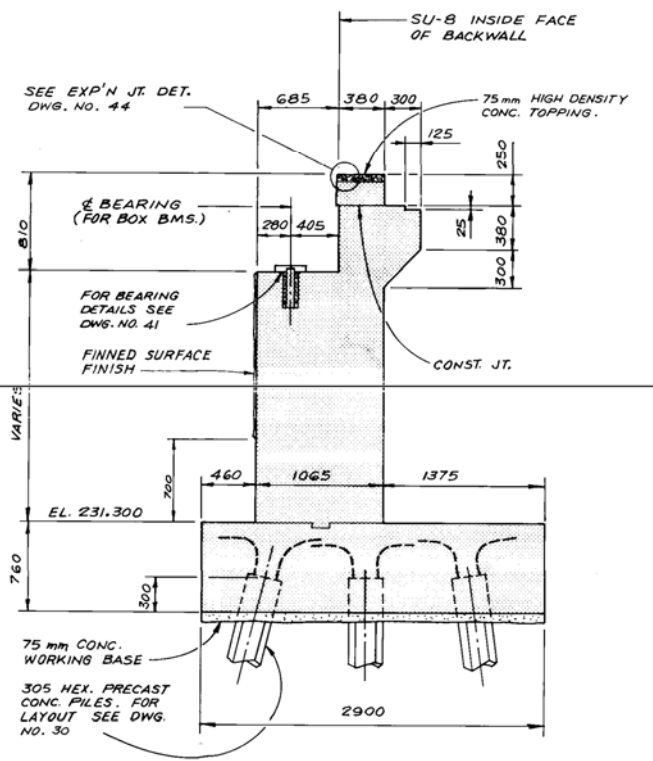

SECTION I
SCALE 1:30

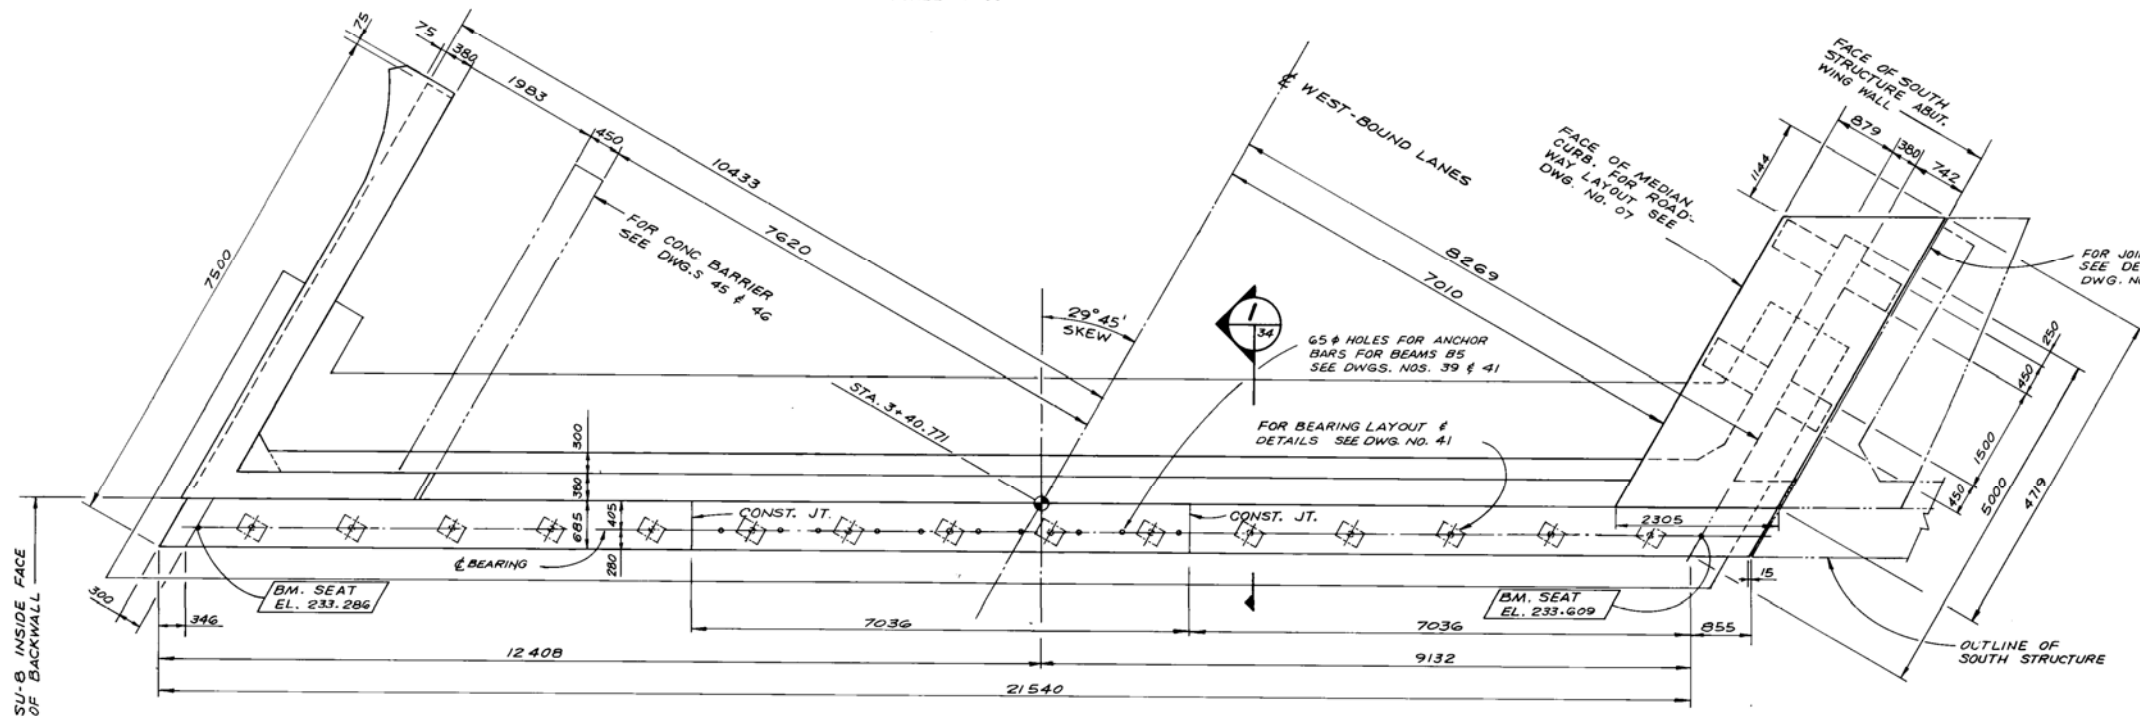

PLAN AT TOP
SCALE 1:50

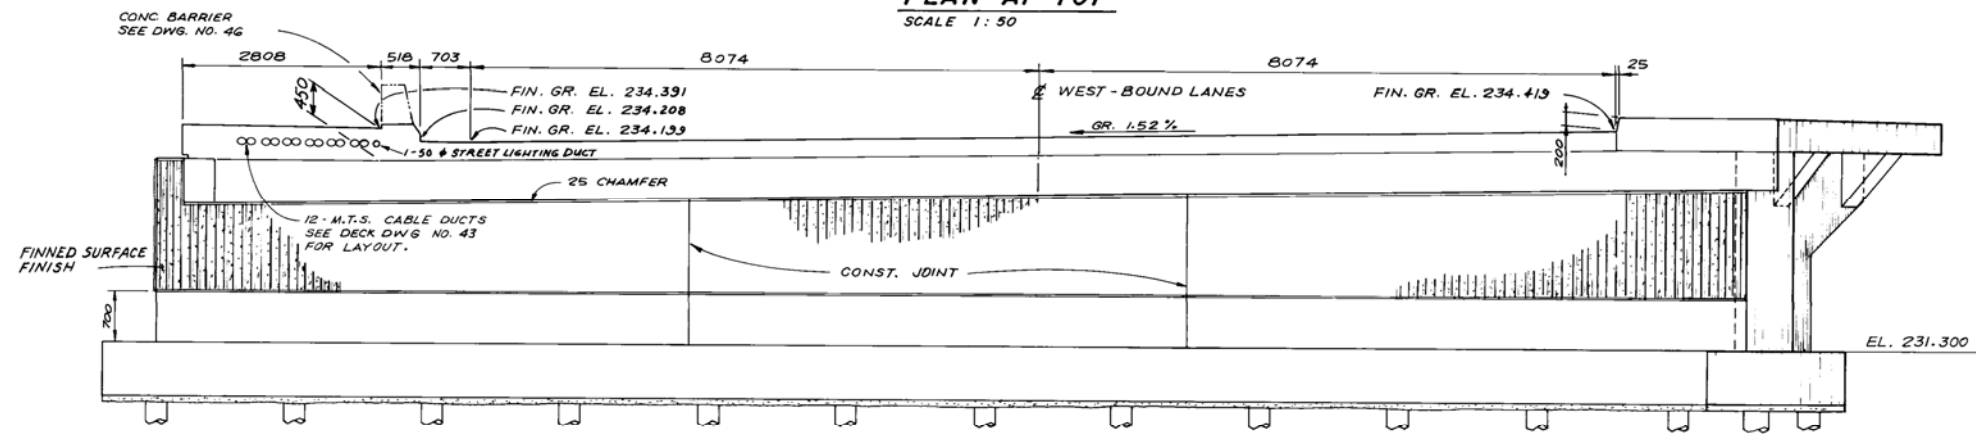

FRONT ELEVATION
SCALE 1:50

AS BUILT
Redline

GENERAL NOTES

1. ALL EXPOSED EDGES SHALL BE CHAMFERED 19mm EXCEPT WHERE SHOWN OTHERWISE.
2. CONCRETE CLEAR COVER TO REINFORCING STEEL SHALL BE: 75 mm FOR FOOTING, 50 mm FOR ALL OTHERS
3. 13mm FLEXCELL SHALL BE PLACED ON VERTICAL FACES OF CURB JOINTS.

NO	REVISIONS	DATE	APP

23/9/80
I. HAM
C.A.D.
23/9/80
I. B.
U.I.V.
23/9/80

DILLON Consulting Engineers & Planners

DESIGNED BY: N.B.U. DRAWN BY: W.P.S.
CHECKED BY: L.D.M. DATE: 80-08-25

APPROVED BY: *[Signature]* DATE: 23/9/80

B-5420

THE CITY OF WINNIPEG
WORKS & OPERATIONS
STREETS & TRANSPORTATION

STURGEON CREEK BRIDGE ON PORTAGE AVENUE
NORTH STRUCTURE EAST ABUTMENT SU-8 CONCRETE

AUTHORIZED BY: *[Signature]* DATE: 1980-08-25
ACCEPTED BY: *[Signature]* DATE: 0-10-80

SCALE: AS NOTED DRAWING NO: B178-80-34