


NOTES:

1. CONFIRMED ASBESTOS CONTAINING MATERIALS IN DUCTWORK INSULATION. REFER TO ASBESTOS ABATEMENT SPECIFICATIONS FOR ABATEMENT PROCEDURES

AS CONSTRUCTED

DATE OCTOBER / 91 BY S.Q.

APPROVED BY

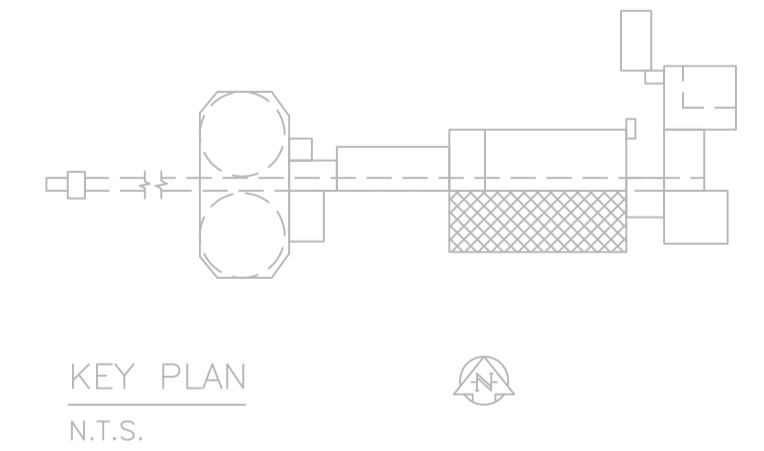

B.M. ELEV.		MaLAREN ENGINEERS INC.	
		WARDROP ENGINEERING INC.	
		ENGINEERING CONSULTANTS	
		DESIGNED BY S. Q.	CHECKED BY
3	ISSUED FOR ADDENDUM 7 - 976-2016	07/17 JBC	
2	ISSUED FOR CONSTRUCTION - 976-2016	04/17 B.C.	
1	AS CONSTRUCTED	10/91 S.Q.	
0	ISSUED FOR TENDER	08/89 S.Q.	
-	ISSUED FOR APPROVAL	06/89 S.Q.	
NO.	REVISIONS	DATE	BY
		DATE	APRIL 7, 1989

ORIGINALLY DESIGNED BY

24 July 2017

PROVINCE OF MANITOBA

F. J. ABSI

Member 36875

REGISTERED PROFESSIONAL ENGINEER

CONSULTANT DRAWING NO. 870012-01-16-M117

THE CITY OF WINNIPEG

WORKS AND OPERATIONS DIVISION

WATERWORKS, WASTE & DISPOSAL DEPARTMENT

SOUTH END WATER POLLUTION CONTROL CENTRE

PRIMARY CLARIFIER No. 3 - MECHANICAL

MAIN FLOOR AND PENTHOUSE PLAN

HEAT, VENT AND DUCTWORK

CITY DRAWING NUMBER

SHEET OF

SEP-271