

NOTES:
 1. CONFIRMED ASBESTOS CONTAINING MATERIALS IN EXTERIOR WALL PLASTER. REFER TO ASBESTOS ABATEMENT SPECIFICATIONS FOR ABATEMENT PROCEDURES.

REMOVE EXISTING COPING FLASHING, COUNTER FLASHING, REMOVE EXISTING WOOD COPING ASSEMBLY INCLUDING ROOFING MEMBRANE TO ACCOMMODATE METAL PANEL AND WOOD COPING ASSEMBLY

REMOVE TYNDAL STONE FACING, INSULATION, AIR BARRIER, ANCHORS AND TIES, AND INSULATION RETAINER FLUSH WITH EXISTING BACK-UP

REMOVE EXISTING COPING FLASHING, COUNTER FLASHING, REMOVE EXISTING WOOD COPING ASSEMBLY INCLUDING ROOFING MEMBRANE TO ACCOMMODATE METAL PANEL AND WOOD COPING ASSEMBLY


REMOVE TYNDAL STONE FACING, INSULATION, AIR BARRIER, ANCHORS AND TIES, AND INSULATION RETAINER FLUSH WITH EXISTING BACK-UP

AS CONSTRUCTED
 DATE SEPTEMBER 1993 BY C.J.A.
 APPROVED BY _____

KEY PLAN
 N.T.S.

NO.	REVISIONS	DATE	BY	DATE	BY
3	ISSUED FOR ADDENDUM 7 - 976-2016	07/17	JBC		
2	ISSUED FOR CONSTRUCTION - 976-2016	04/17	R.Z.		
1	AS CONSTRUCTED	93/09	P.R.B.		
0	ISSUED FOR TENDER	90/07	K.S.		
-	SUBMITTED FOR CITY REVIEW	90/04	K.S.		
-	ISSUED FOR J.V. REVIEW	90/02	K.S.		

ORIGINALLY DESIGNED BY

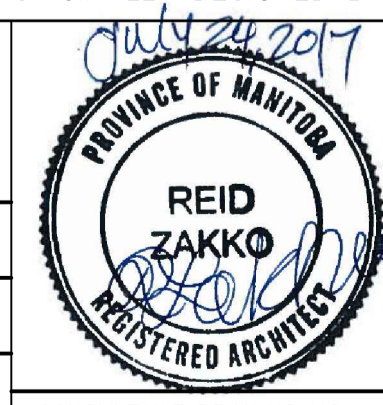

THE CITY OF WINNIPEG
 WORKS AND OPERATIONS DIVISION
 WATERWORKS, WASTE & DISPOSAL DEPARTMENT
 SOUTH END WATER POLLUTION CONTROL CENTRE
 SECONDARY CLARIFIER EXPANSION - ARCHITECTURAL ELEVATIONS

CITY DRAWING NUMBER
 SHEET OF
 SEP-400

CONSULTANT DRAWING NO.
 870012-01-18-S-A103