



INSTRUMENT LOOP DIAGRAM

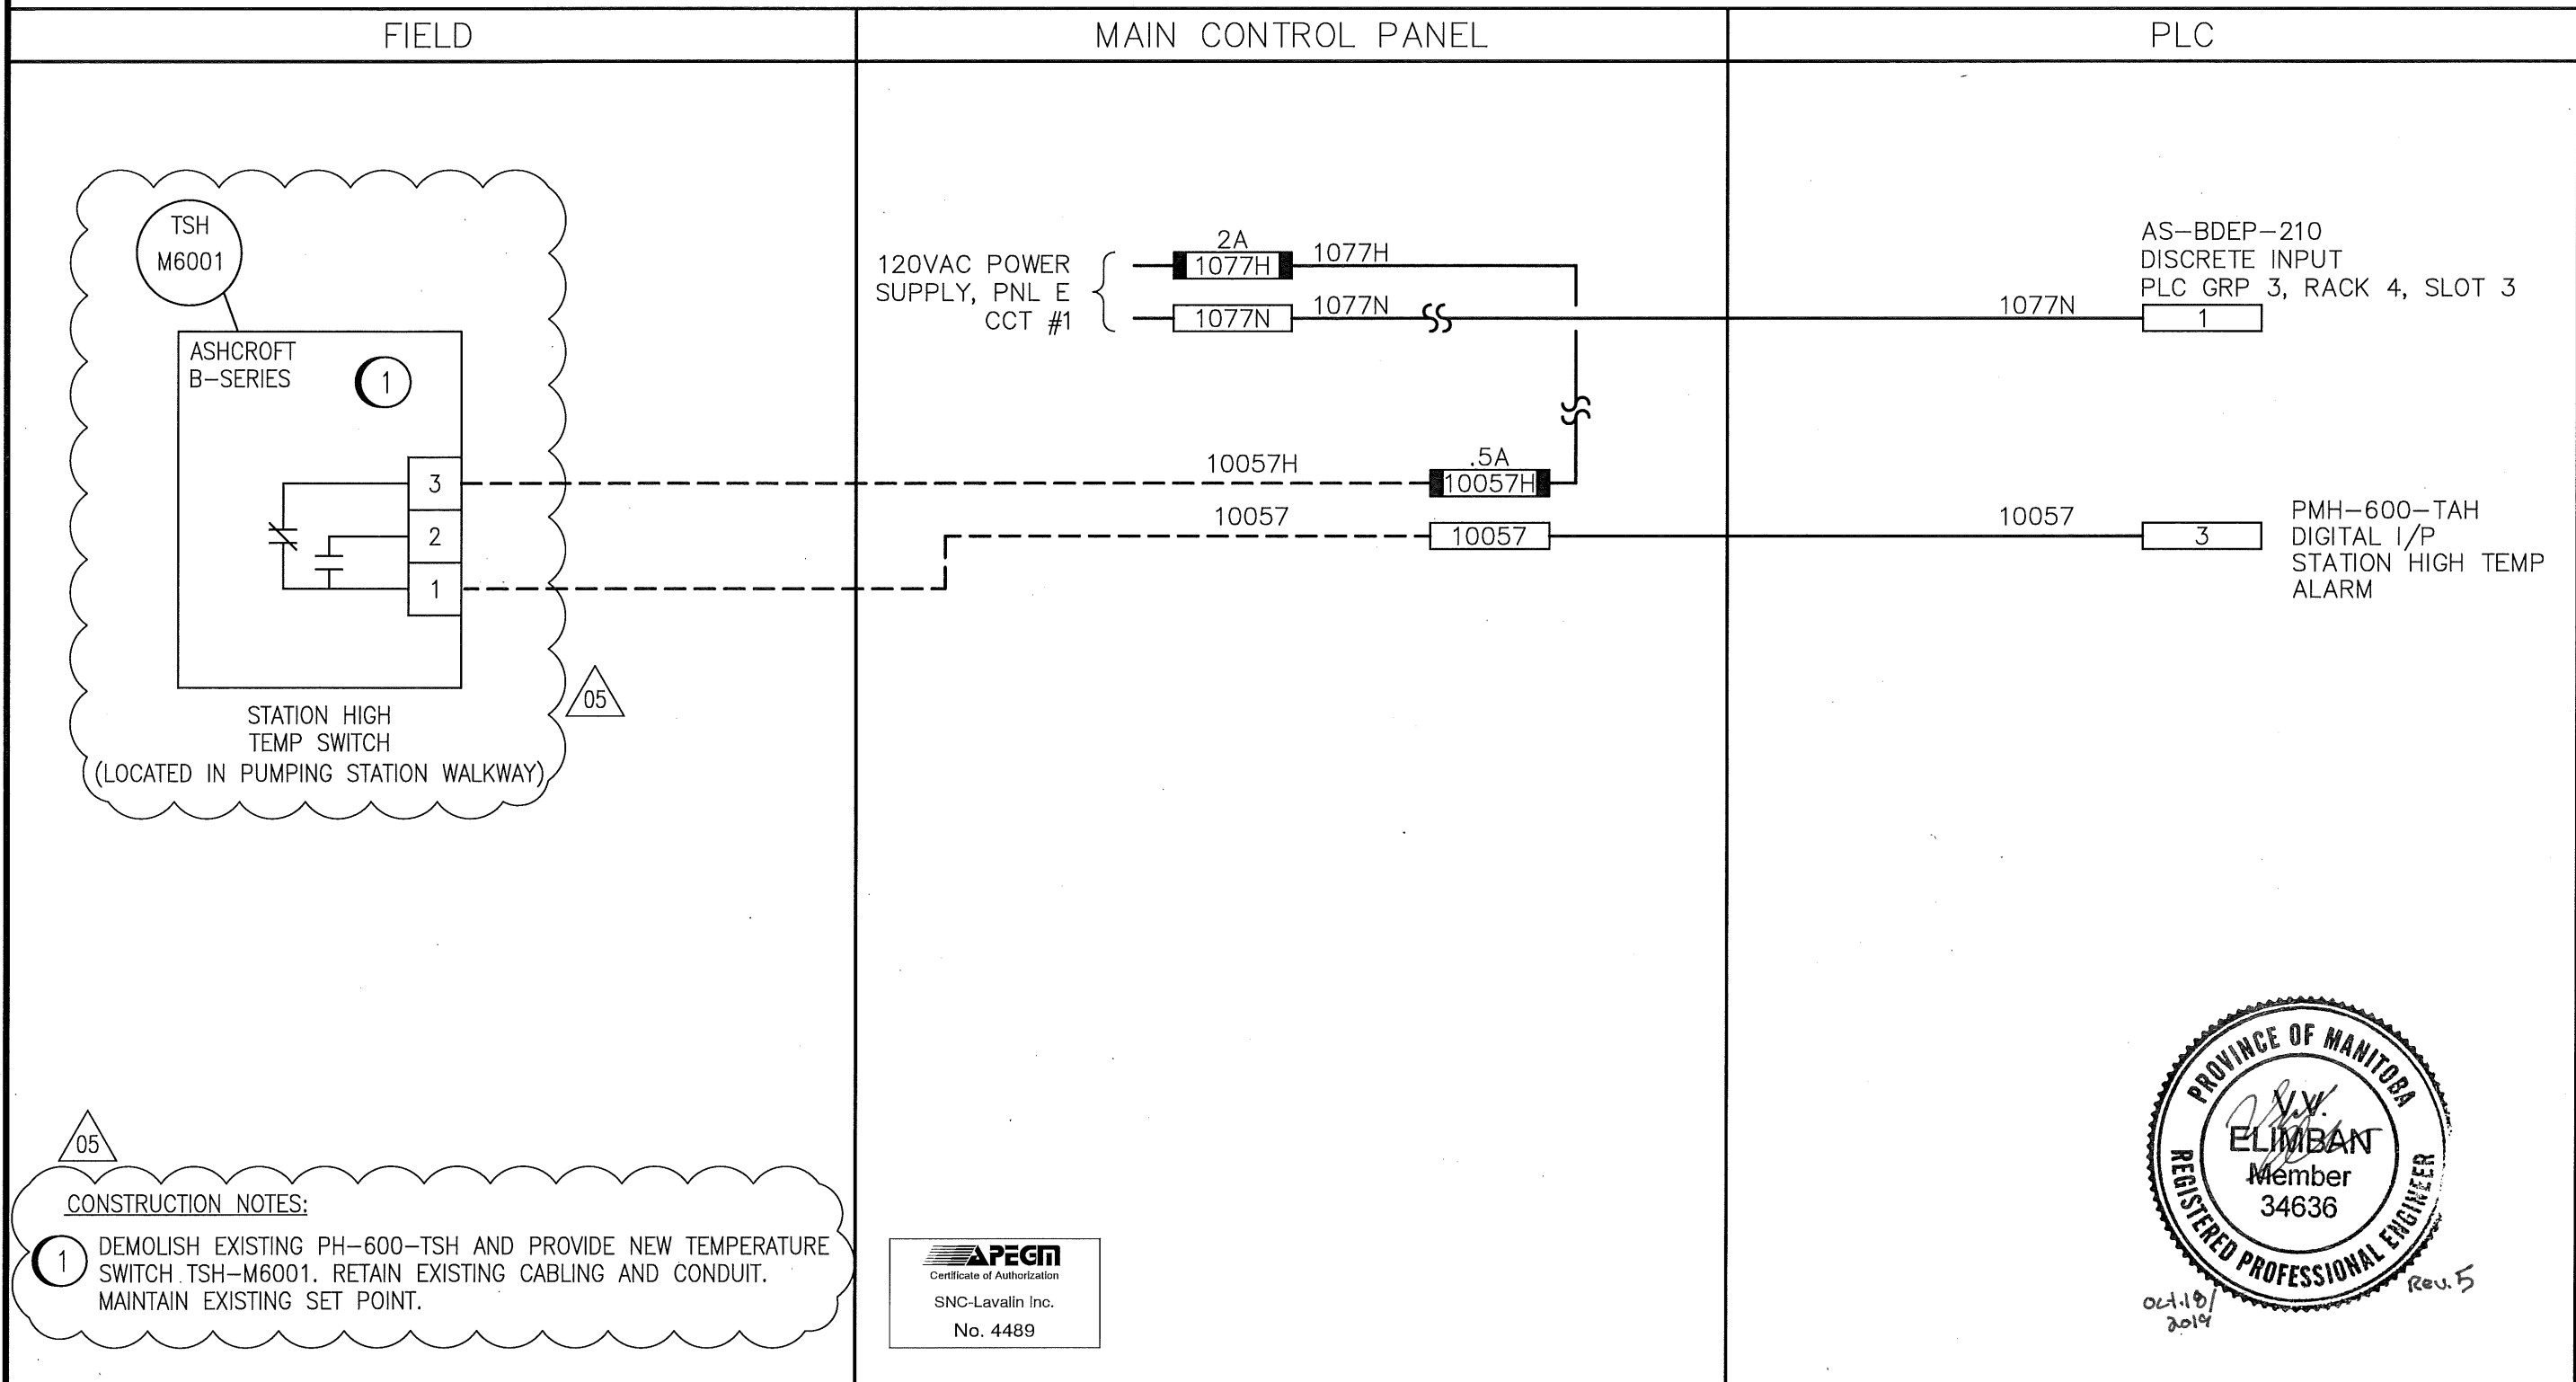

05

CONSTRUCTION NOTES:

1 DEMOLISH EXISTING PH-600-TSH AND PROVIDE NEW TEMPERATURE SWITCH TSH-M6001. RETAIN EXISTING CABLING AND CONDUIT. MAINTAIN EXISTING SET POINT.

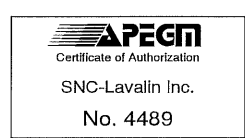

NOTE:
1. CONTACTS OPERATE IN FAILSAFE MODE.

ASSOCIATED REFERENCE DRAWINGS:
1-0640M-A0048

05

				JOB NO. 3153			
				FILENAME D2231			
19.10.15	5	ISSUED FOR TENDER AND CONSTRUCTION	VE	97.02.03	3	RCPL RECORD DRAWING	PS
				94.07.04	2	AS BUILT	PL
98.10.30	4	REVISED RECORD DWG.	TM	93.12.14	1	RE-ISSUED FOR CONST.	PL
DATE		REVISION	APP.	DATE		REVISION	APP.

THE CITY OF WINNIPEG

REGIONAL WATER SUPPLY SYSTEM
SUPERVISORY CONTROL AND DATA ACQUISITION

McPHILLIPS PUMPING STATION – MCP
STATION HIGH TEMP SWITCH

SCALE	
DATE	94.07.04
DES	PL DWN LGB
CKD	DN APP LK
DRAWING NO.	D-2231