


- CONSTRUCTION NOTES:**
- ALL WORK AND MATERIALS TO BE IN ACCORDANCE WITH LATEST REVISION OF THE CITY OF WINNIPEG STANDARD CONSTRUCTION SPECIFICATIONS.
 - LEGAL PLAN AND UNDERGROUND INFORMATION FROM CITY OF WINNIPEG LBIS. CONTRACTOR TO VERIFY ALL UNDERGROUNDS IN THE FIELD.
 - CONTRACTOR TO TAKE PRECAUTIONARY STEPS TO AVOID DAMAGE FROM CONSTRUCTION ACTIVITIES TO TREES WITHIN THE LIMITS OF CONSTRUCTION.
 - LOCATION OF EXISTING SERVICES TO BE CONFIRMED IN THE FIELD BY THE CONTRACTOR.
 - INSTALL CB LEADS AT MIN 1% SLOPE OR AS DIRECTED BY THE CONTRACT ADMINISTRATOR.

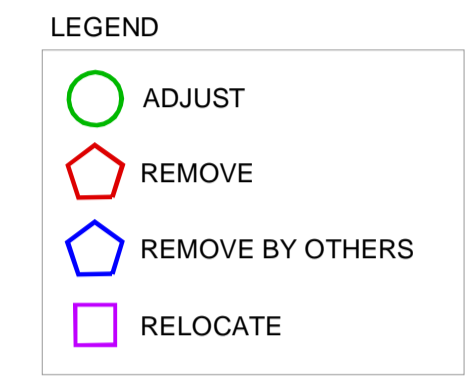

BORE HOLE LOCATIONS

TEST HOLE ID	NORTHING	EASTING
05	5523317.023	635337.995

- ABBREVIATIONS:**
- CONC CONCRETE ROADWAY
 - ASP ASPHALT ROADWAY
 - ASP OVLY ASPHALT OVERLAY ROADWAY
 - GRAN GRANULAR ROADWAY
 - PVS PAVING STONE/BRICK
 - CSW CONCRETE SIDEWALK
 - ASW ASPHALT SIDEWALK
 - GSW GRANULAR SIDEWALK
 - TYP TYPICAL
 - EX EXISTING
 - MH MANHOLE
 - WV WATER VALVE
 - EL ELEVATION
 - CB CATCH BASIN
 - CP CATCH PIT
 - CI CURB INLET
 - CL CONTROL LINE


METRIC

WHOLE NUMBERS INDICATE MILLIMETRES
DECIMALIZED NUMBERS INDICATE METRES

WARNING

IF POWER EQUIPMENT OR EXPLOSIVES ARE TO BE USED FOR EXCAVATION ON THIS PROJECT THE CONTRACTOR MUST:

- NOTIFY THE GAS COMPANY OF THE PROPOSED LOCATION OF EXCAVATION.
- TAKE PRECAUTION TO AVOID DAMAGE TO GAS COMPANY INSTALLATIONS SEE PROVINCIAL REGULATION 210/72 FOR DETAILS.
- OBTAIN EXCAVATION PERMITS PRIOR TO CONSTRUCTION.

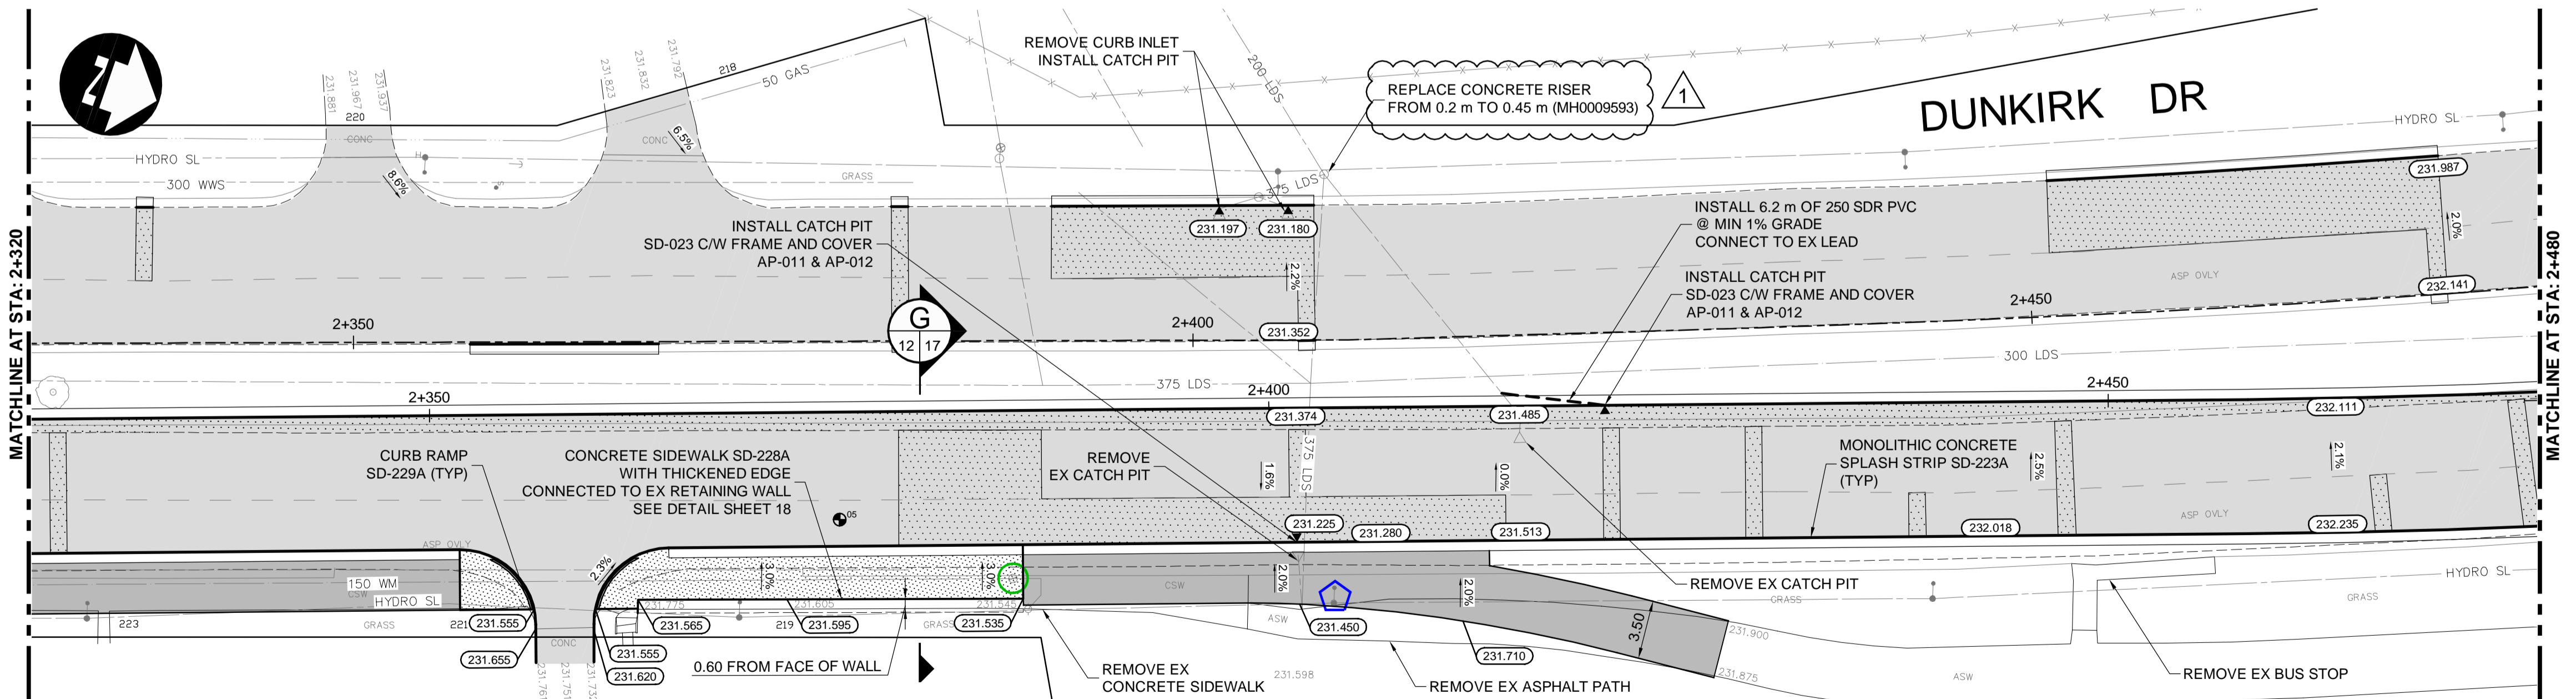

APEGM
Certificate of Authorization
Dillon Consulting Limited (MB)
No. 1789 Date: 20/12/03

EXISTING	LEGEND-PLAN	PROPOSED	EXISTING	LEGEND-PLAN	PROPOSED	EXISTING	LEGEND-PROFILE	PROPOSED
	HYDRANT			CONCRETE			WATERMAIN	
	VALVE			ASPHALT			LAND DRAINAGE SEWER	
	MANHOLE			SIDEWALK			WASTE WATER SEWER	
	CATCH BASIN			PAVING STONES			HYDRANT	
	CATCH PIT			PAVEMENT REPAIR FABRIC			VALVE	
	WATERMAIN			PROPERTY LINE			PROFILE	
	LAND DRAINAGE SEWER			ELEVATION			NORTH/WEST GUTTER	
	WASTE WATER SEWER			TRAFFIC SIGNAL			SOUTH/EAST GUTTER	
	HYDRO			SURVEY BAR			NORTH/WEST DITCH	
	M.T.S.			CURB RAMP			SOUTH/EAST DITCH	
	GAS			DETECTABLE TILE				

UNDERGROUND STRUCTURES
UGS APPROVED - NOVEMBER 20, 2020

B.M. ELEV.	DESIGNED BY	DATE	BY	DATE
	RTP/PMW			
	PMW			
	TCS			
	DBW			
	DBW			

LOCATION OF UNDERGROUND STRUCTURES AS SHOWN ARE BASED ON THE BEST INFORMATION AVAILABLE. BUT NO GUARANTEE IS GIVEN THAT ALL EXISTING UTILITIES ARE SHOWN OR THAT THE GIVEN LOCATIONS ARE EXACT. CONFIRMATION OF EXISTENCE AND EXACT LOCATION OF ALL SERVICES MUST BE OBTAINED FROM THE INDIVIDUAL UTILITIES BEFORE PROCEEDING WITH CONSTRUCTION.

NO.	REVISIONS	DATE	BY	DATE
1	ISSUED FOR ADDENDUM #2	20/12/16	DBW	
0	ISSUED FOR TENDER	20/12/03	DBW	

DESIGNED BY: RTP/PMW
DRAWN BY: PMW
CHECKED BY: TCS
APPROVED BY: DBW
HOR. SCALE: 1:250
VERTICAL: 1:10

DILLON CONSULTING

RELEASED FOR CONSTRUCTION

DATE: _____

THE CITY OF WINNIPEG
PUBLIC WORKS DEPARTMENT

Winnipeg

2021-2023 REGIONAL PAVEMENT RENEWAL PROJECT
DUNKIRK DRIVE REHABILITATION
ST MARY'S ROAD TO FERMOR AVENUE

CITY DRAWING NUMBER: P-3537-2021-12
SHEET 12 OF 28
CONSULTANT DRAWING NUMBER: _____

PLANNING PROJECT NUMBER: 20-2434
CONSULTANT PROJECT NUMBER: 20-2434

PLAN PROFILE (STA 2+320 TO 2+480)

C:\w_working_directory\projects_2020_40\p\18155\202434-DUN-CT-CON-PLAN-PROFILE.dwg