


1057 LOGAN


ANIMAL SERVICES BUILDING
1057 LOGAN AVENUE

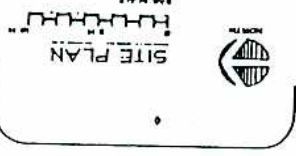

2,318 SQ FT

WARNOCK STREET

7,124 SQ FT

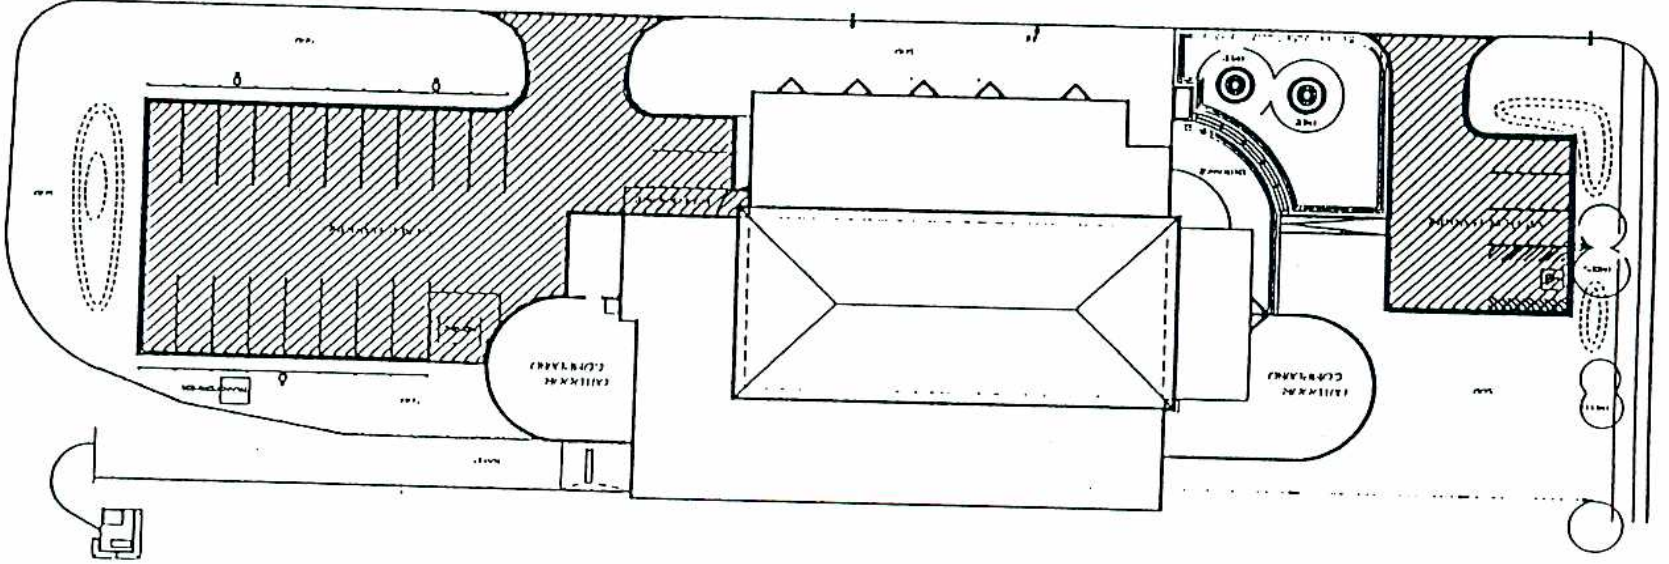

AS BUILT

ANIMAL SERVICES BUILDING
1057 LOGAN AVENUE

Professional seal of a registered professional, likely an architect or engineer, with the name 'J. R. ...' and the number '1057'.