



SEP 425
file # SU10232


REF. of DRAWING No.
DETAILS

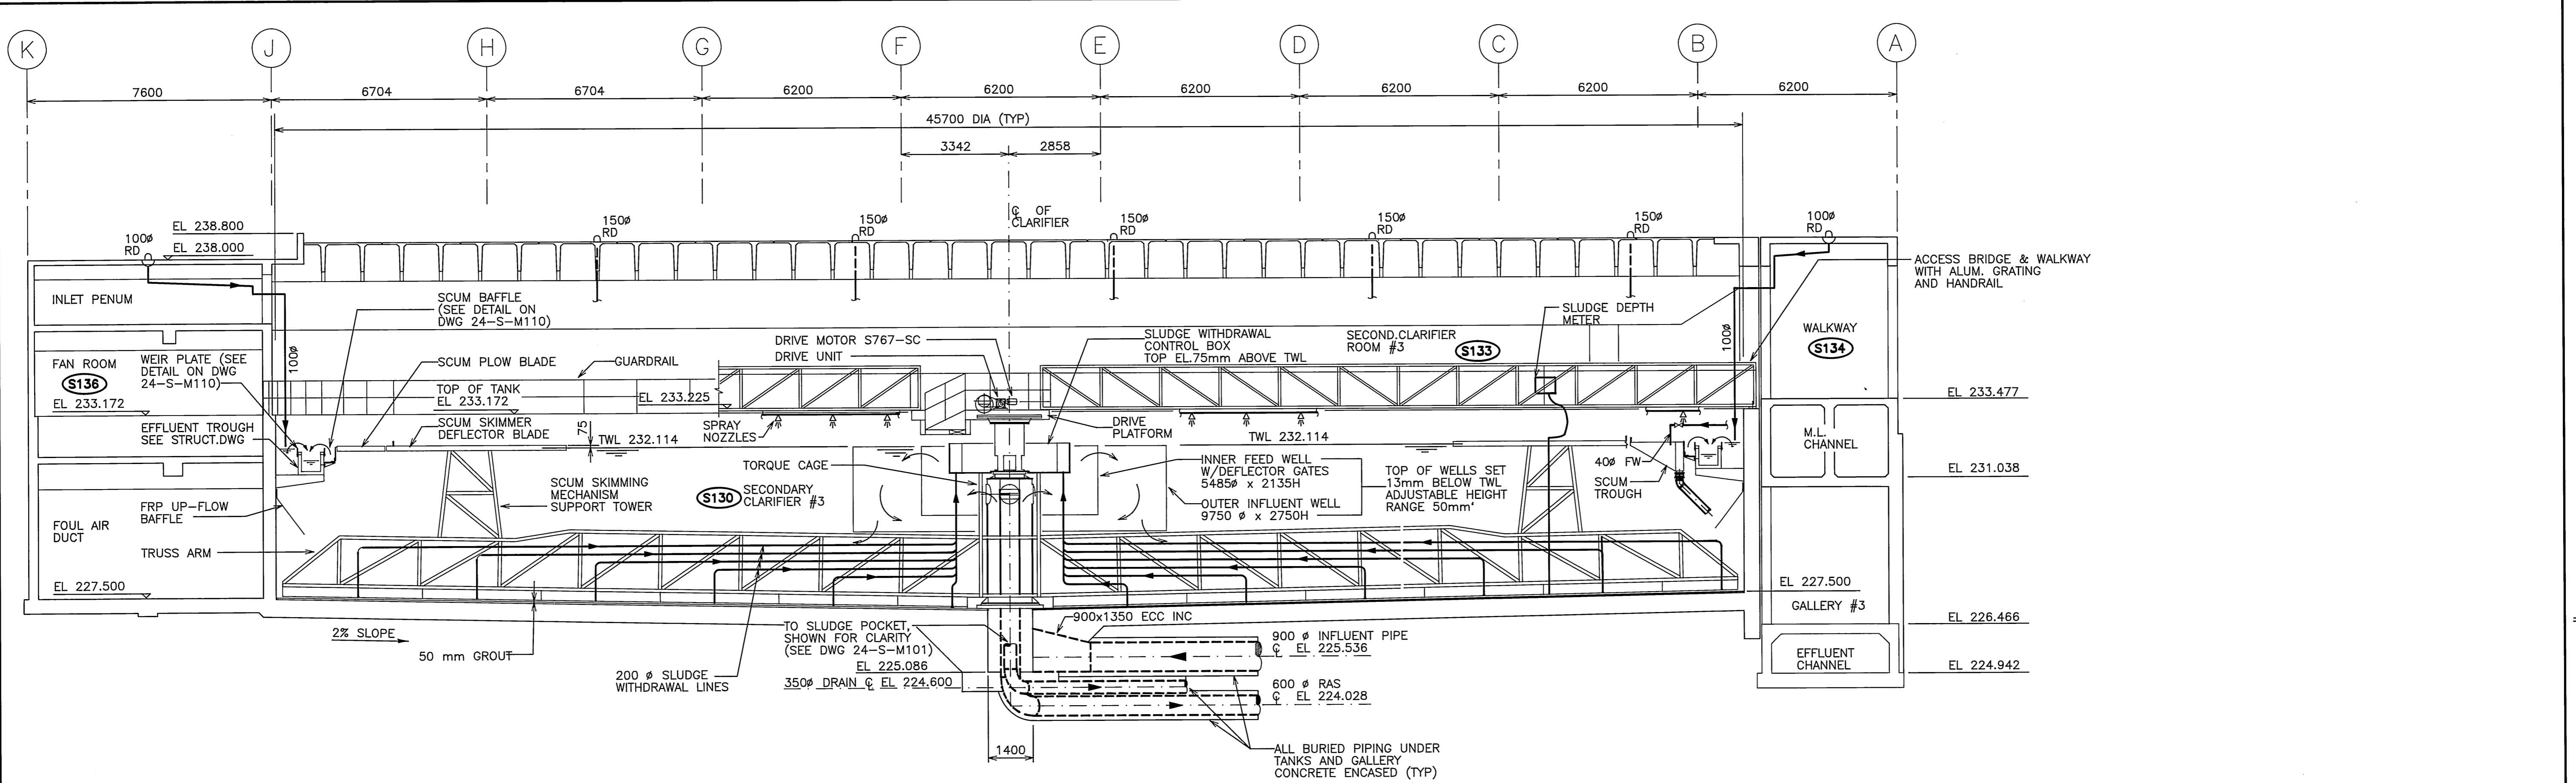


1 SECTION
M101 M103 1:100

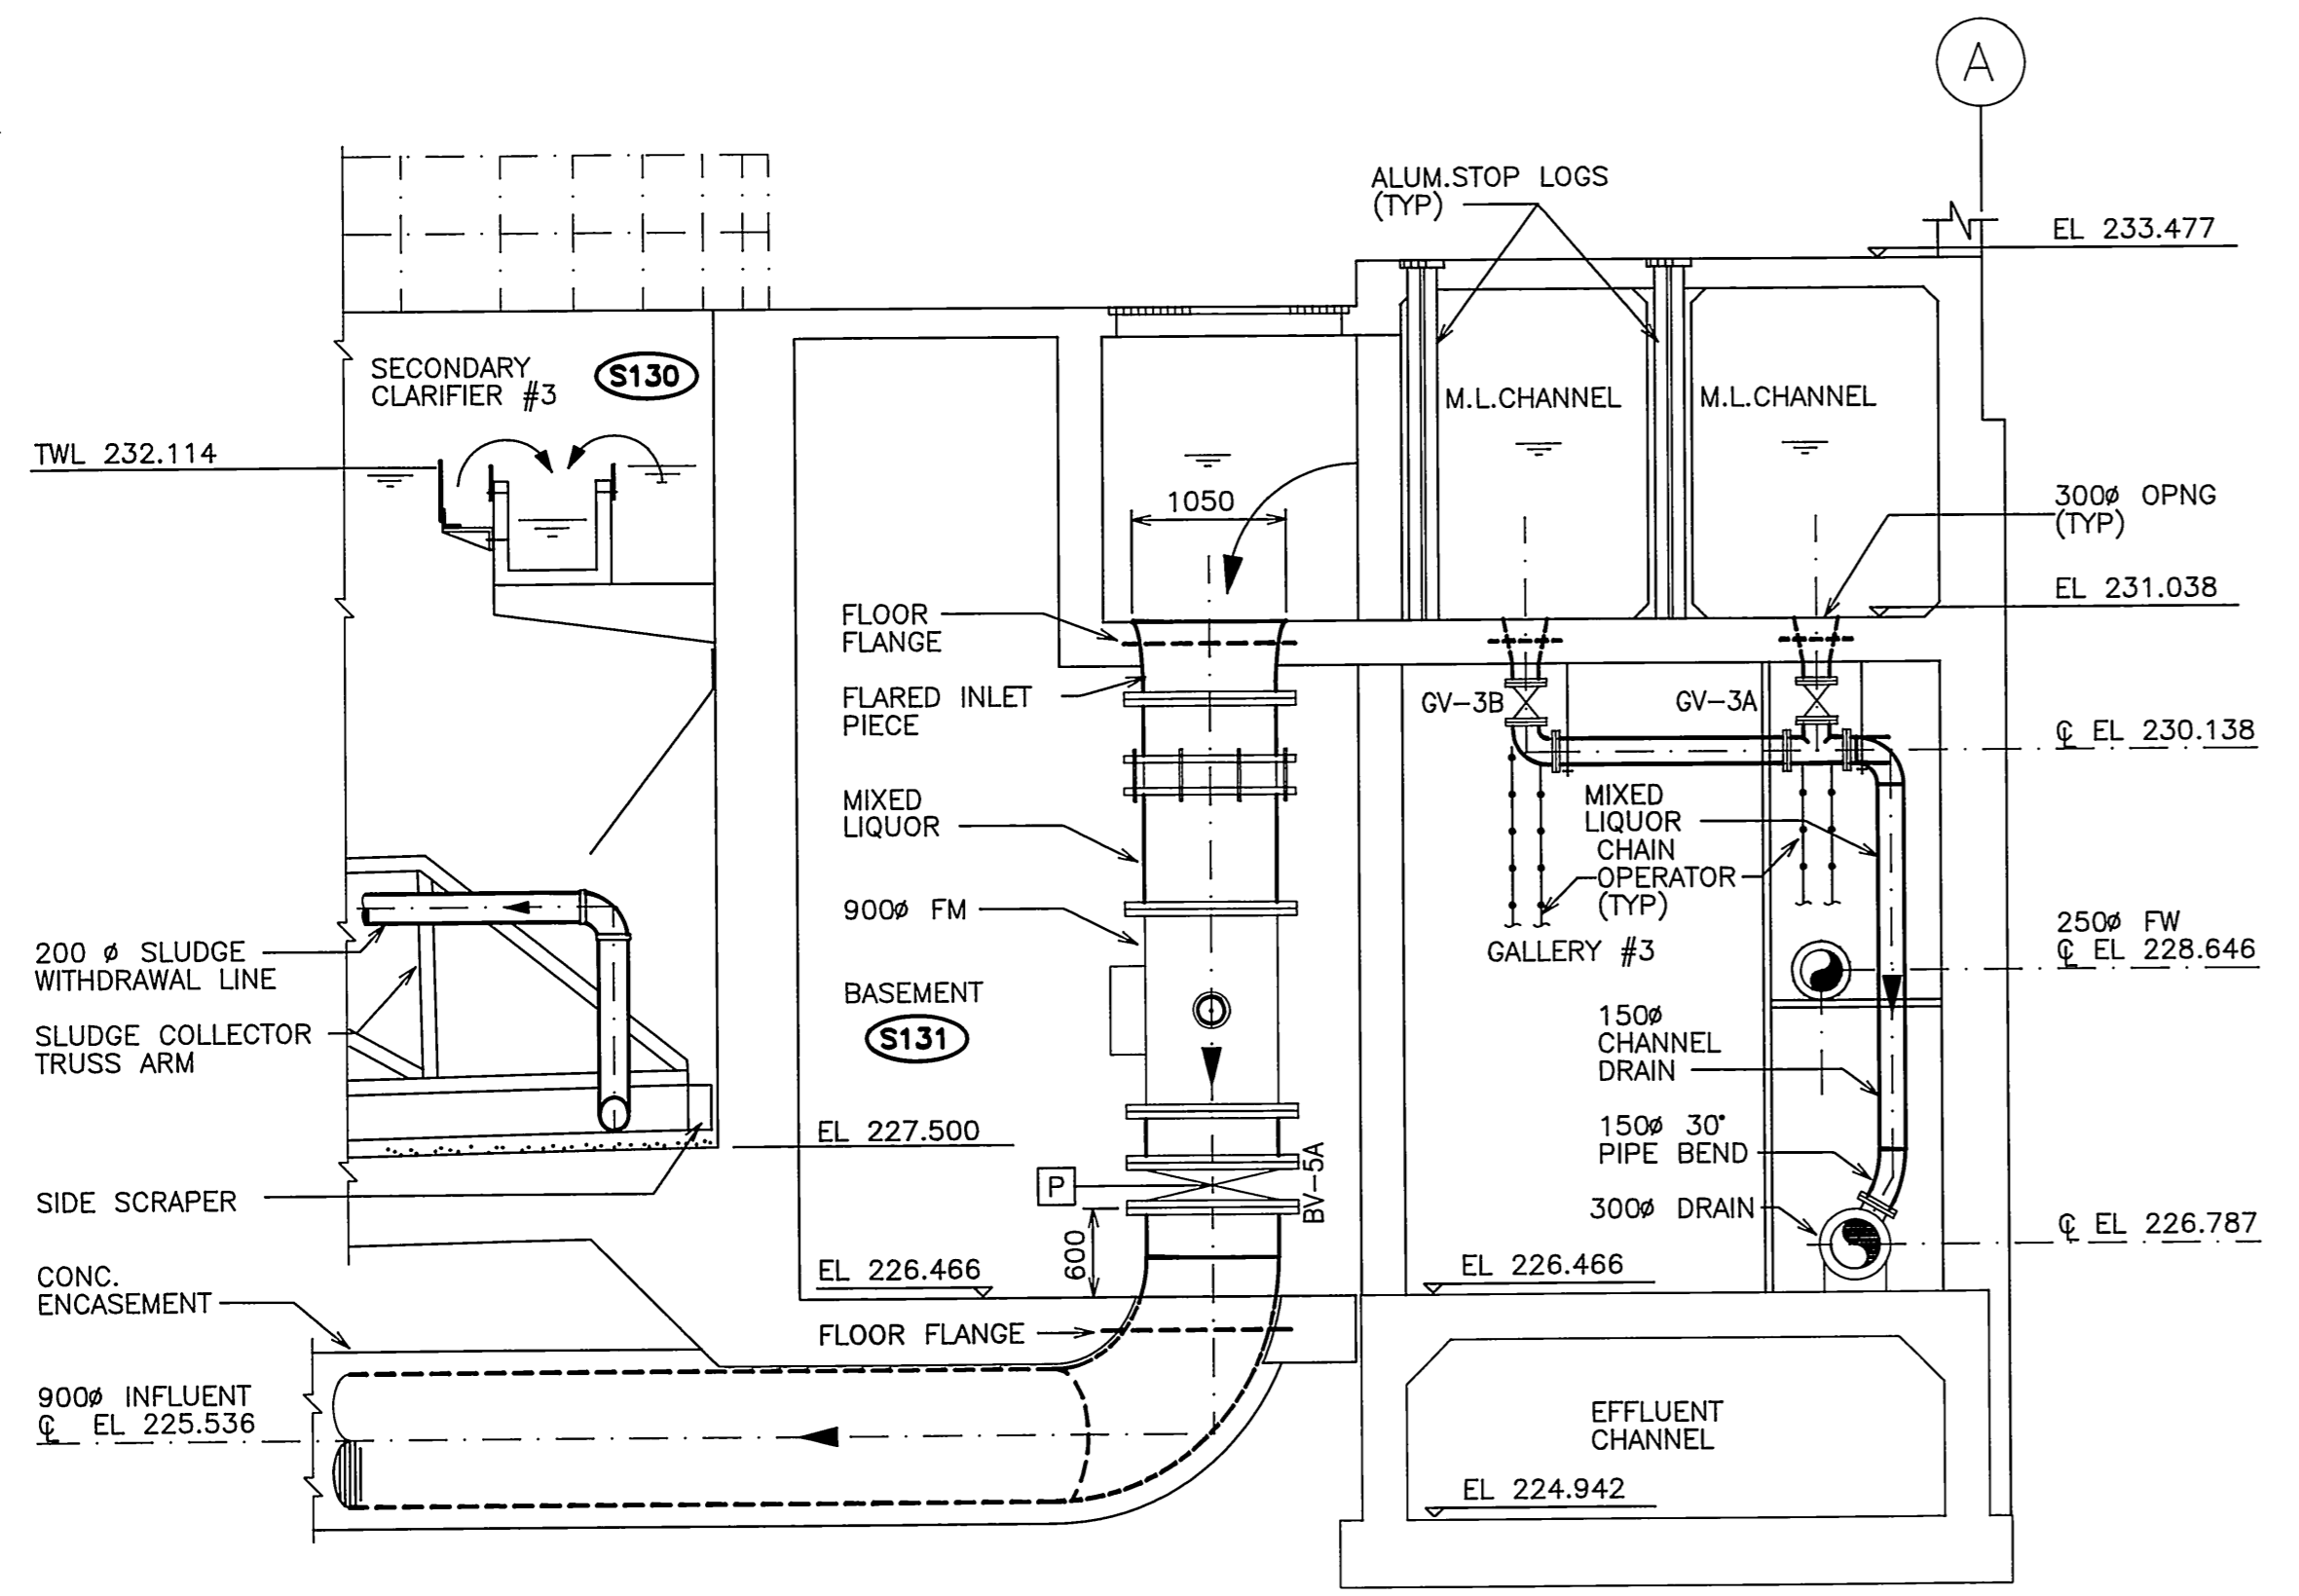

2 SECTION
M101 M103 1:50

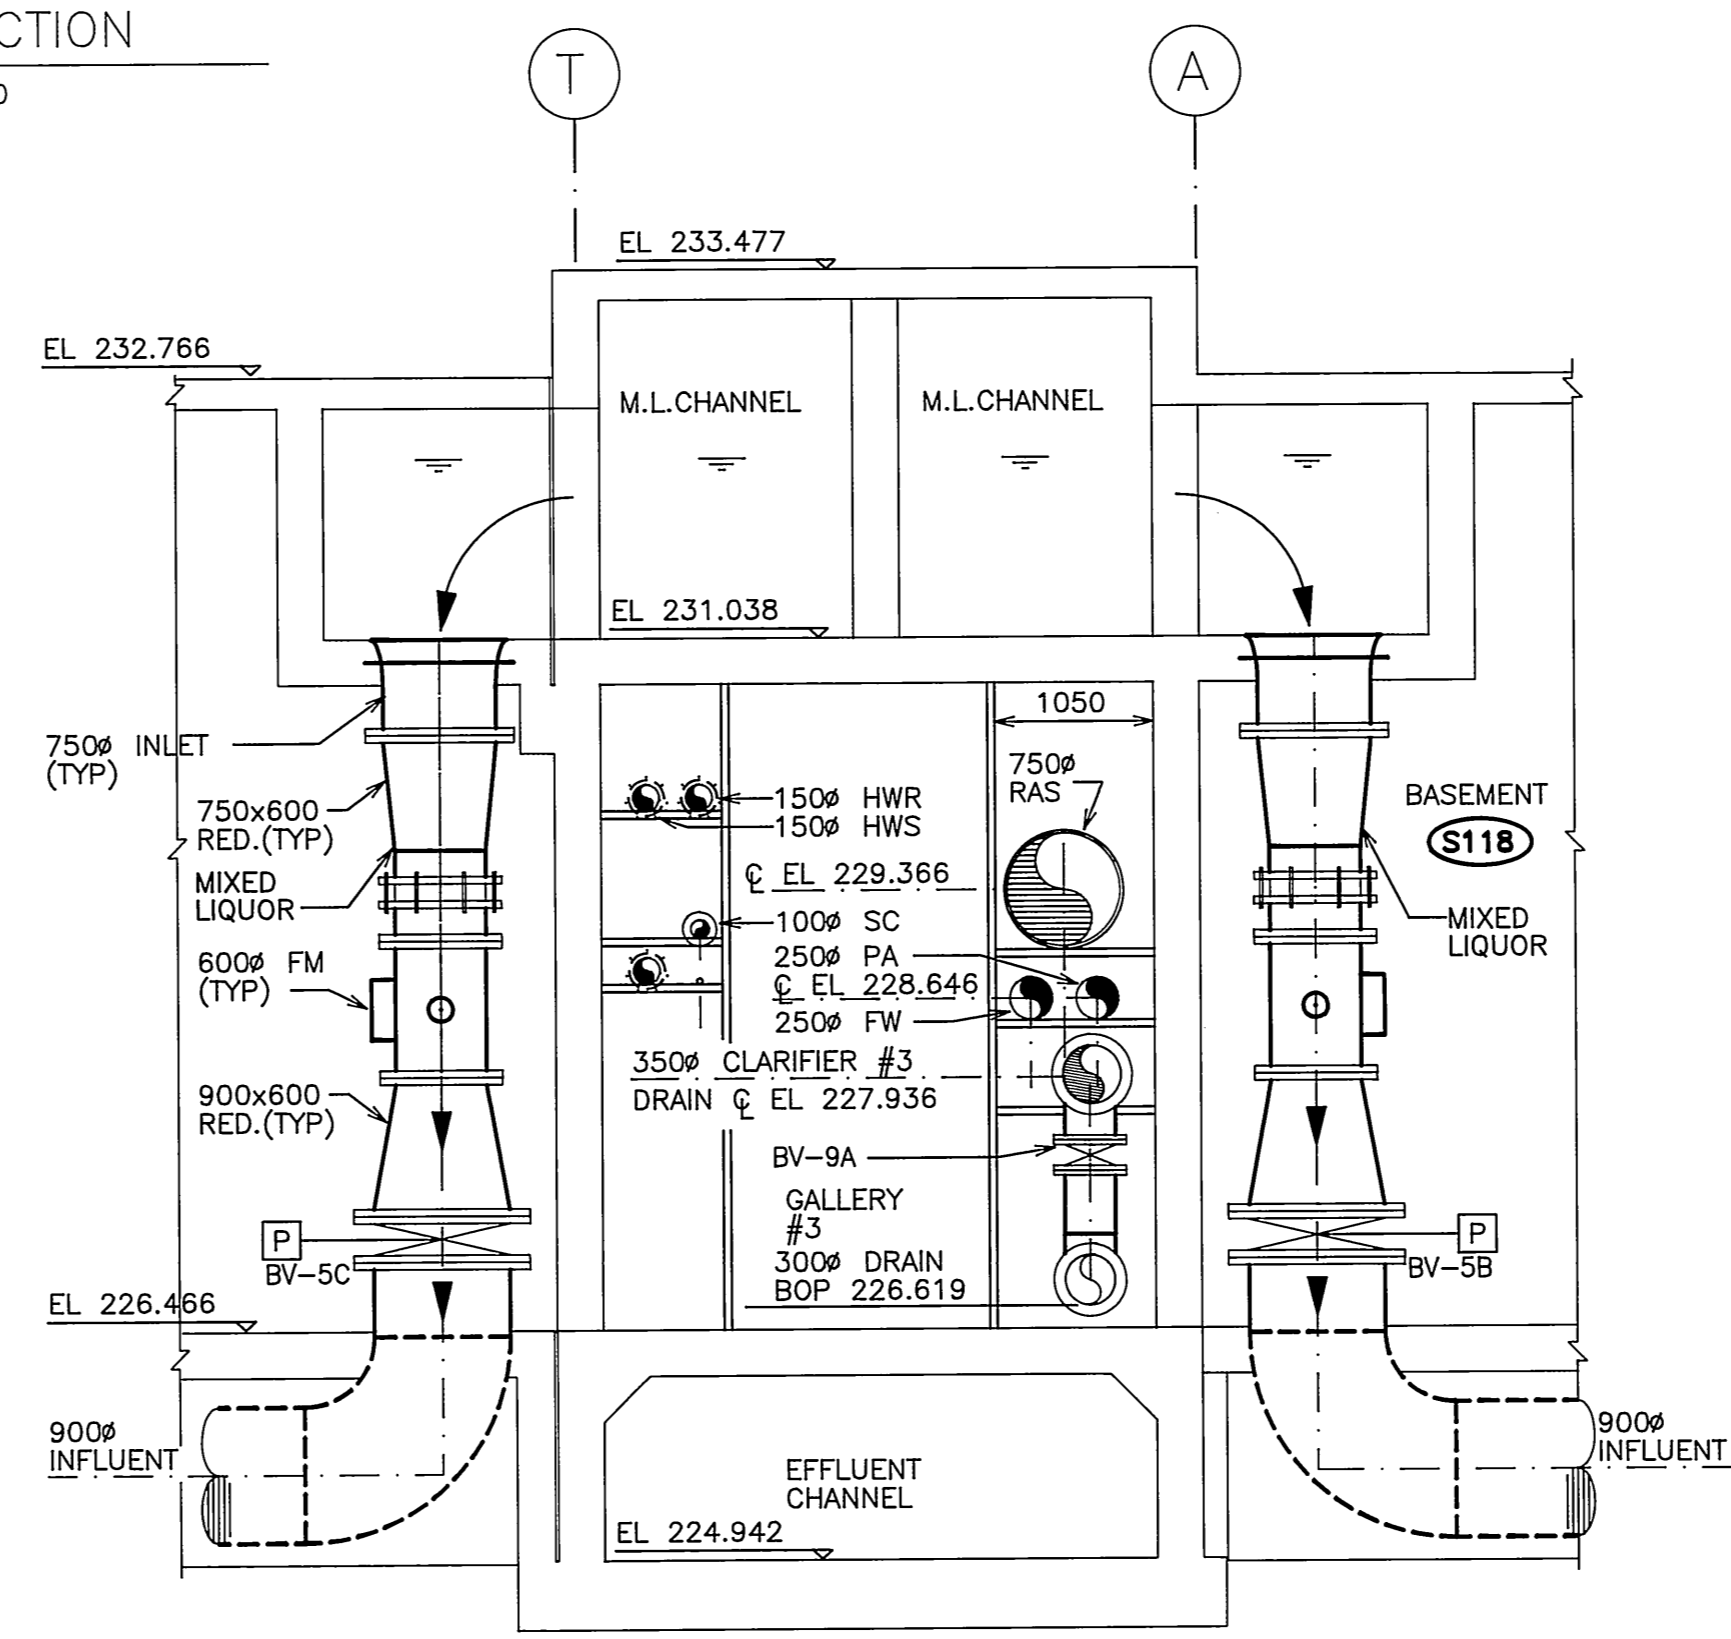

3 SECTION
M104 M103 1:50

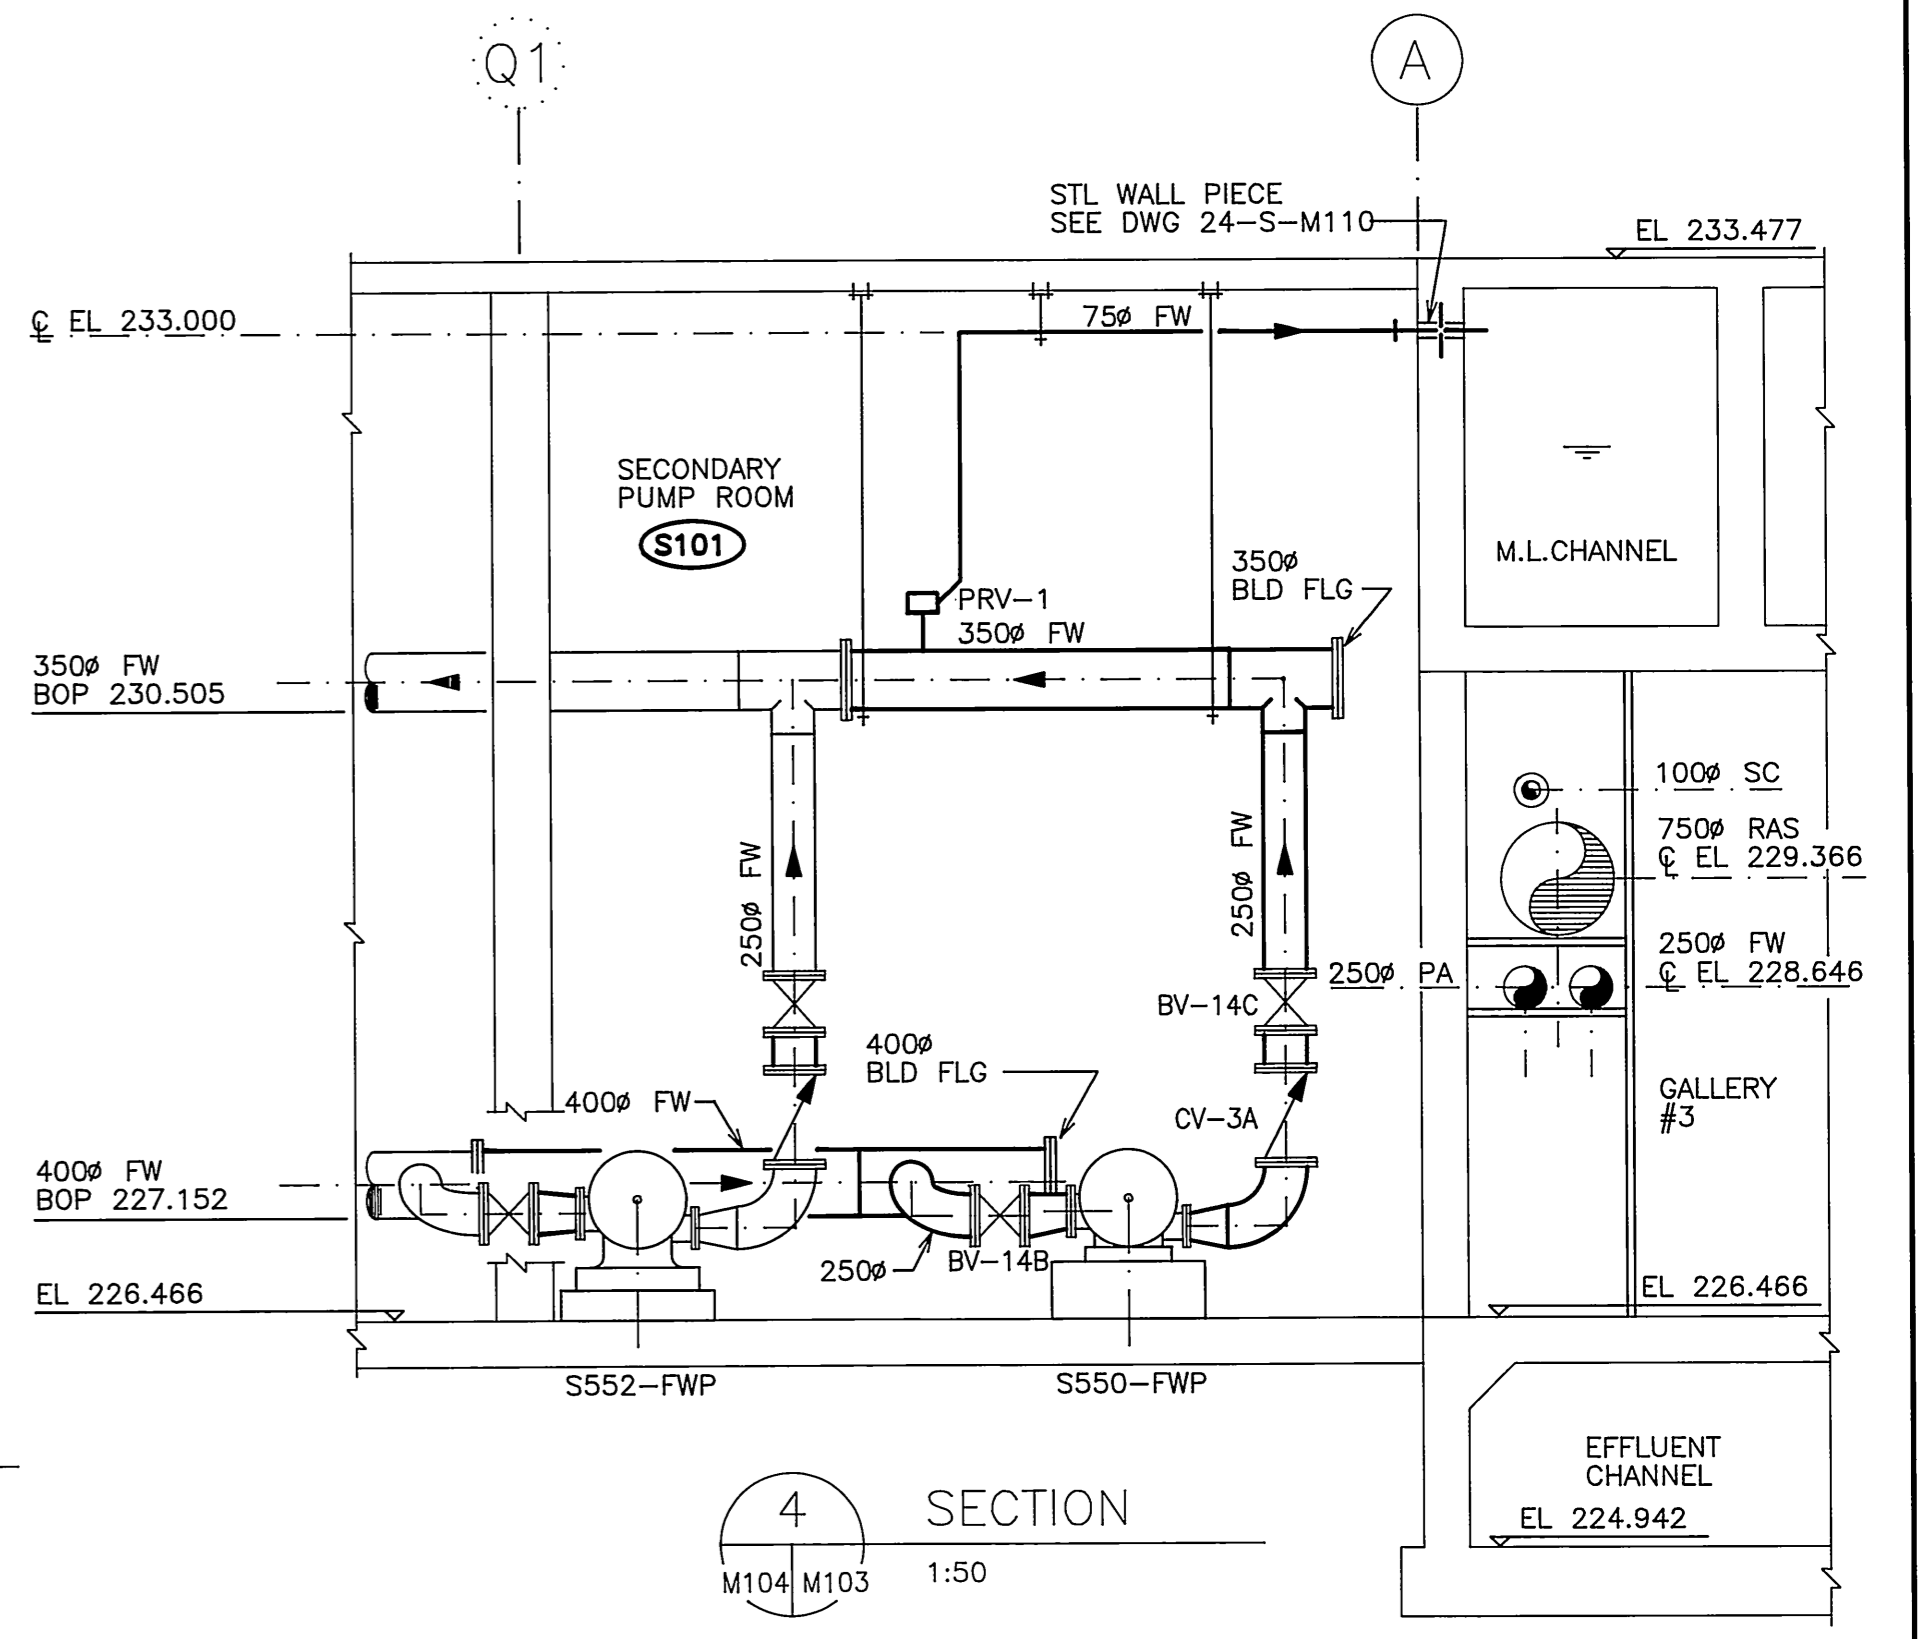

4 SECTION
M104 M103 1:50

AS CONSTRUCTED
 DATE SEPTEMBER 1993 BY P.R.B.
 APPROVED BY *Sean Quigley*

B.M. ELEV.					
DESIGNED BY	CAS/RDJ	CHECKED BY	RDJ		
DRAWN BY	TL	APPROVED BY	<i>Sean Quigley</i>		
1 AS CONSTRUCTED	09/93	P.R.B.			
0 ISSUED FOR TENDER	07/90	RDJ			
NO. REVISIONS	DATE	BY	DATE		

ORIGINALLY DESIGNED BY

THE CITY OF WINNIPEG
 WORKS AND OPERATIONS DIVISION
 WATERWORKS, WASTE & DISPOSAL DEPARTMENT

SOUTH END WATER POLLUTION CONTROL CENTRE CITY DRAWING NUMBER

SECONDARY CLARIFIER EXPANSION SHEET OF

SECONDARY CLARIFIER SECTIONS SEP-425

CONSULTANT DRAWING NO. 43525-24-S-M103