



NOTE:  
LAP LENGTH CLASS B UNLESS NOTED OTHERWISE

**TYPICAL LAP ARRANGEMENT FOR HORIZONTAL REINFORCING BARS**

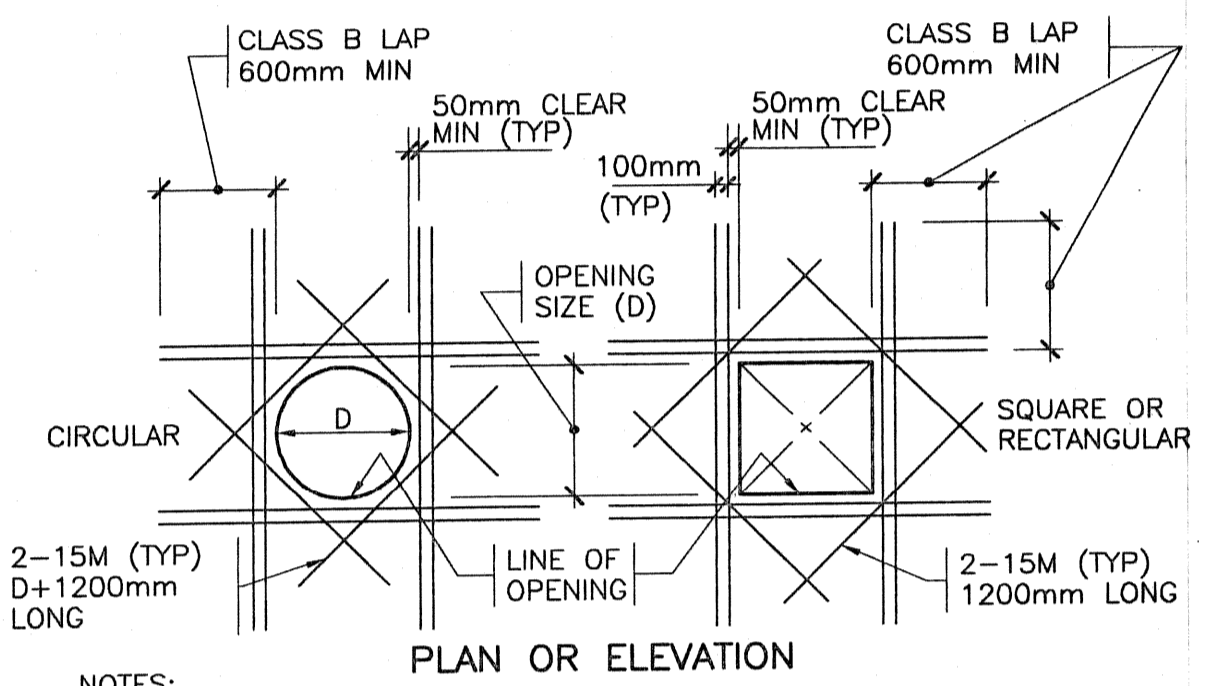

- NOTES:
- FOR OPENINGS D=400mm OR LARGER: ADD EXTRA BARS ON EACH SIDE OF THE OPENING, EQUIVALENT TO HALF THE TOTAL AREA OF REINFORCING CUT IN EACH DIRECTION, EACH FACE, UNLESS NOTED OTHERWISE.
  - FOR OPENINGS LESS THAN 400mm: NO EXTRA BARS ARE REQUIRED ADJUST REGULAR REINFORCING AROUND OPENINGS.

**EXTRA REINFORCING BARS AT OPENINGS IN WALLS AND SLABS**

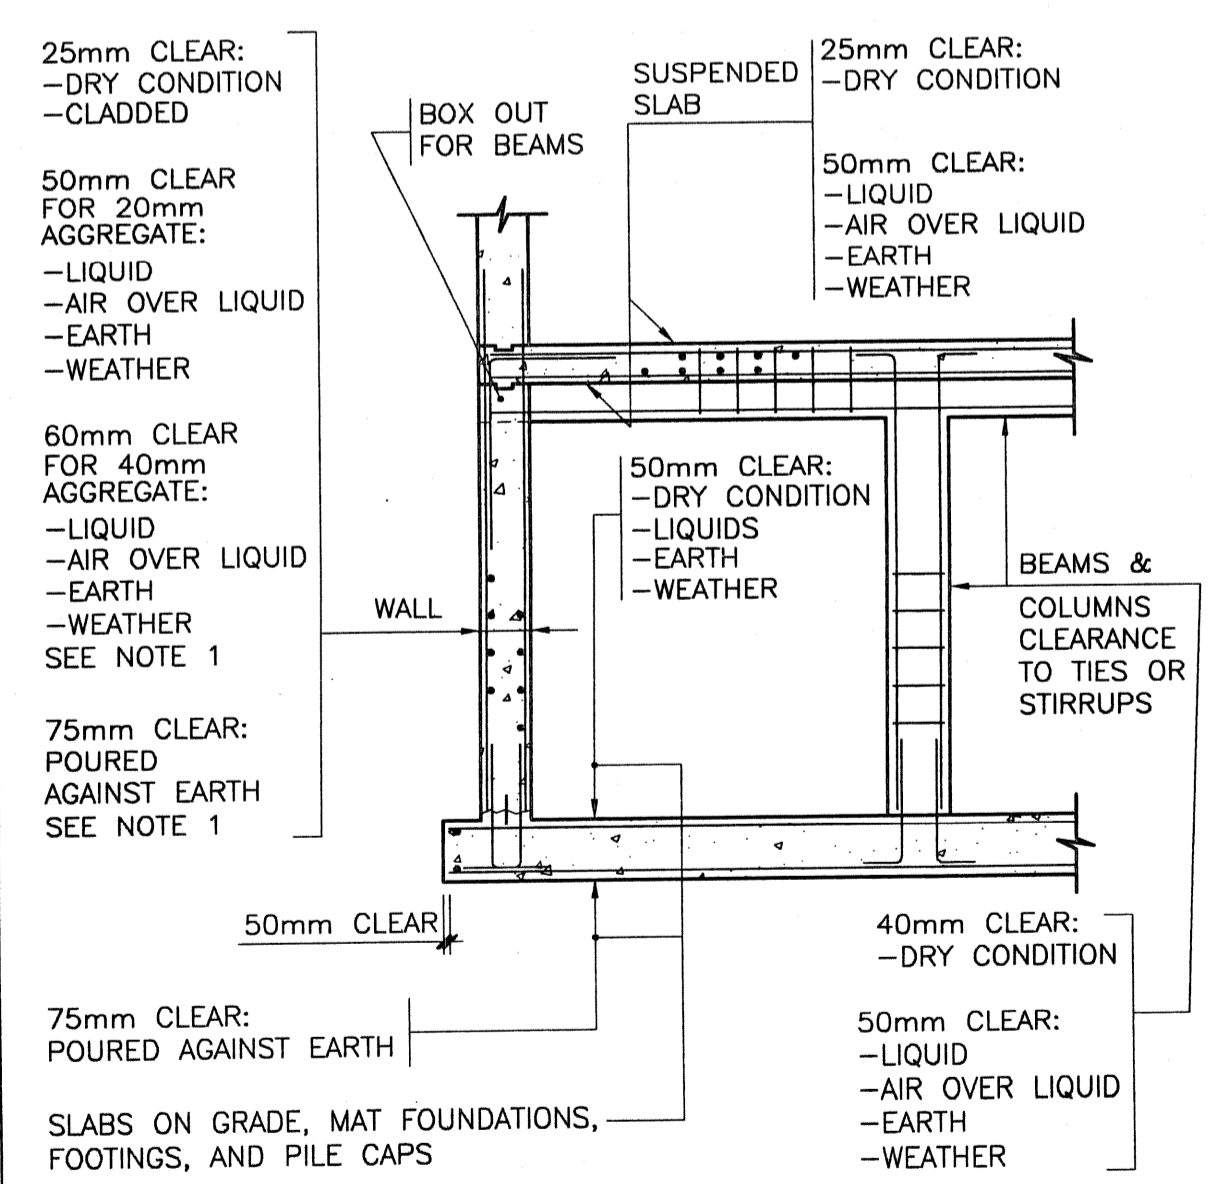

NOTE:  
1. PROVIDE 50mm CLEARANCE ON FACE EXPOSED TO DRY CONDITION.


**CONCRETE COVER TO REINFORCEMENT**

ONLY FOR : 30 MPa CONCRETE , NORMAL WEIGHT  
400 MPa REINFORCING BAR


BAR SIZE	TOP BARS (mm)		OTHER BARS (mm)	
	CLASS A	CLASS B	CLASS A	CLASS B
10M	390	500	300	390
15M	550	710	420	550
20M	670	870	520	670
25M	1080	1400	830	1080
30M	1280	1680	990	1280
35M	1530	1990	1180	1530

- NOTES:
- TOP BARS ARE:
    - ALL BARS IN CONCRETE WITH MORE THAN 300mm CONCRETE BELOW.
    - ALL HORIZONTAL BARS IN WALLS.
  - PROVIDE CLASS B LAP UNLESS NOTED OTHERWISE.
  - DEVELOPMENT LENGTHS SHOWN IN THE TABLE ARE BASED ON HEAVIER CONFINED BARS.
  - TABLE APPLIES UNLESS SHOWN OTHERWISE.


**REINFORCING BAR TENSION LAP TABLE**

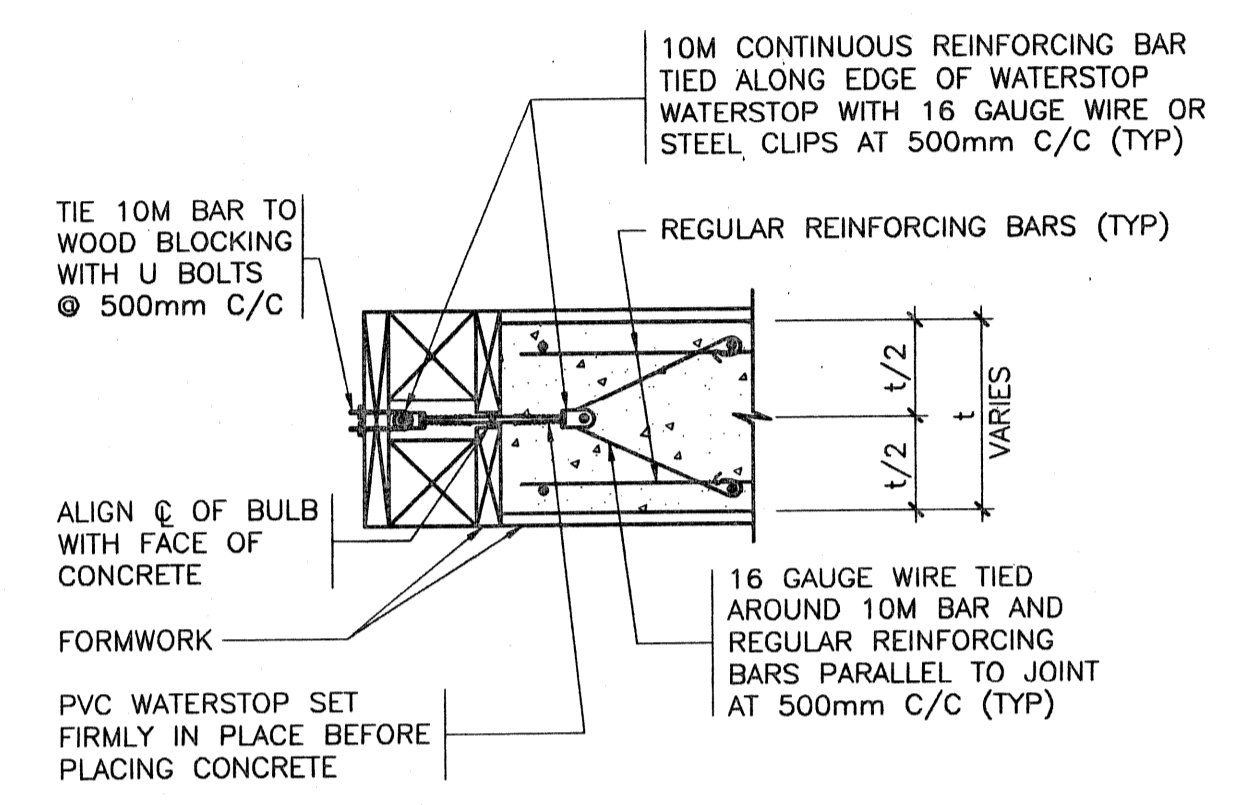


**WATERSTOP ANCHORAGE FOR FIRST PLACEMENT**

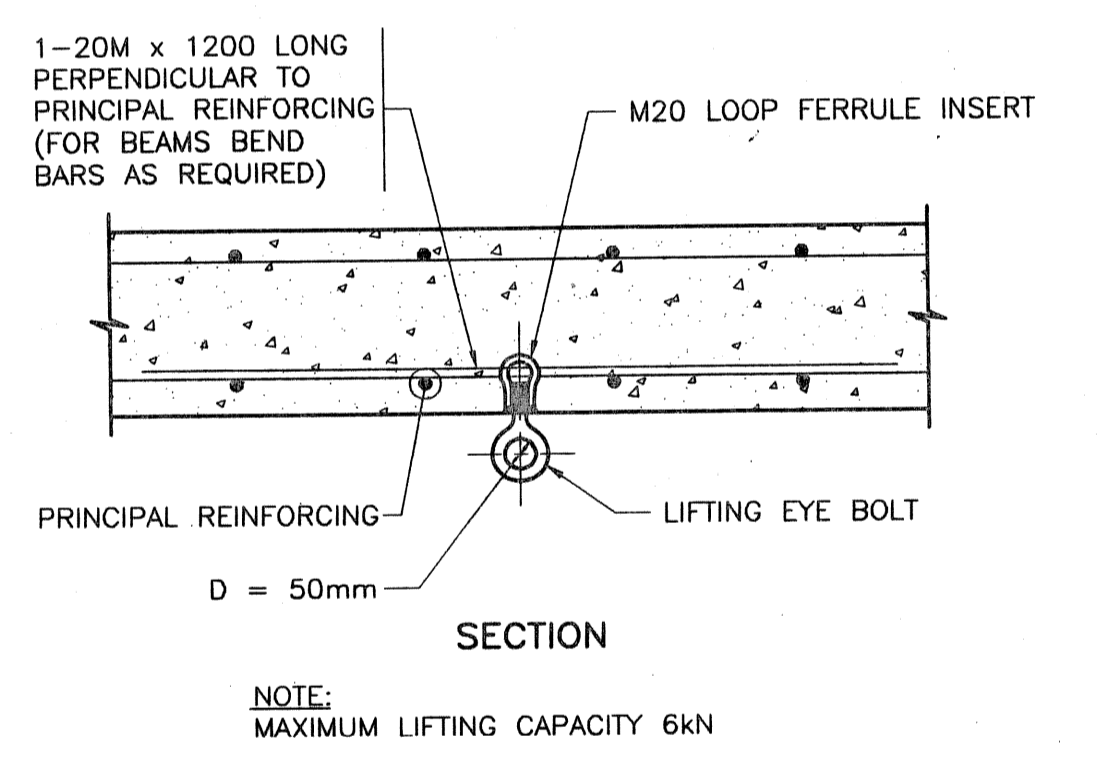

**LIFTING RING IN CONCRETE**

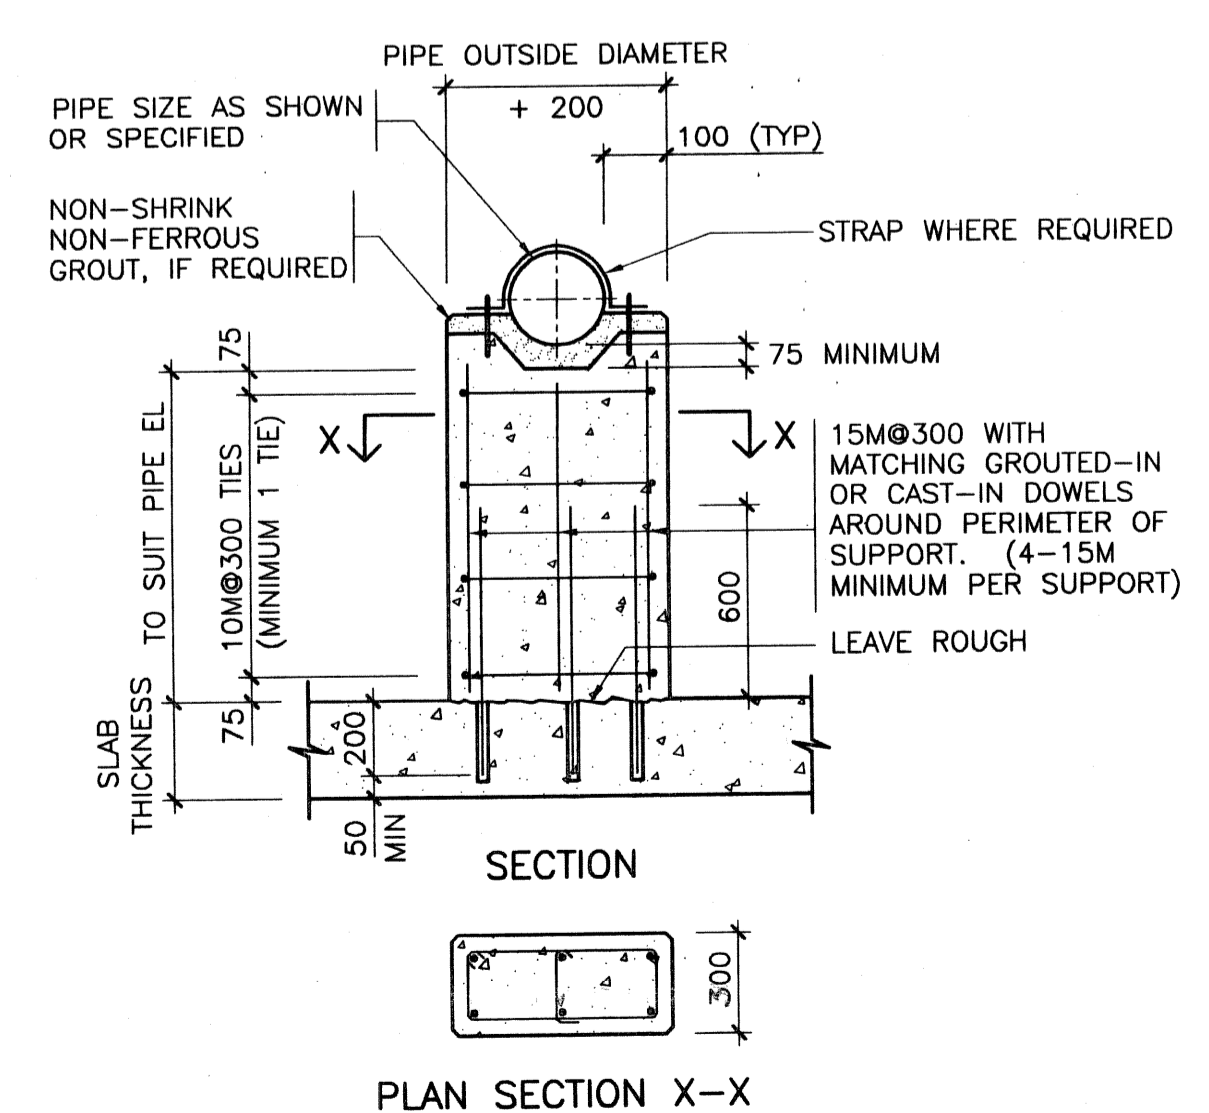

**TYPICAL CONCRETE PIPE SUPPORT**

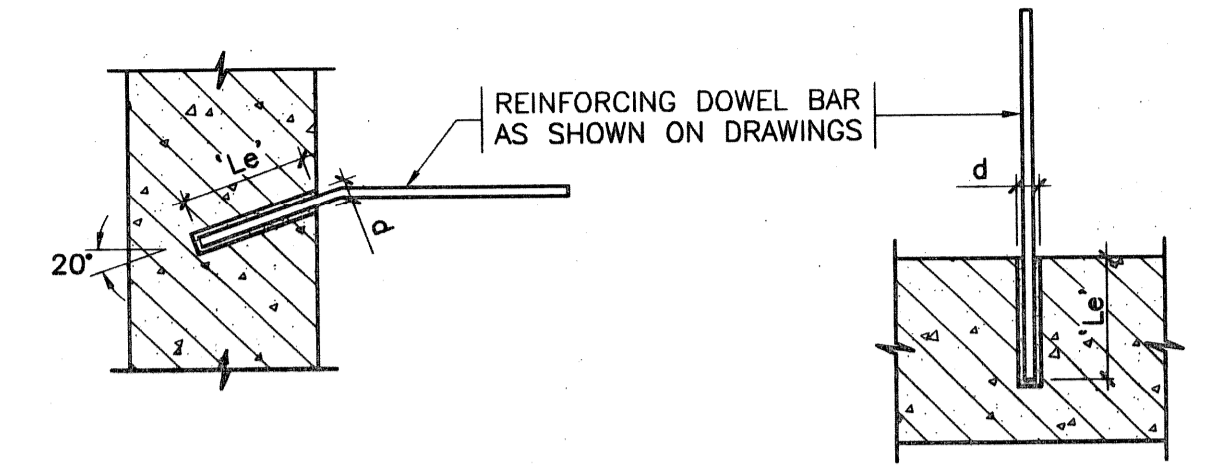


FOR HORIZONTAL BARS      FOR VERTICAL BARS


HYDRAULIC CEMENT GROUT	EPOXY GROUT
d = BAR DIA + 20mm	d AND Le IN ACCORDANCE WITH MANUFACTURER'S PRINTED INSTRUCTIONS.
Le : 15M - 200mm	
20M - 250mm	
25M - 300mm	

- NOTES:
- DRILL HOLE OF DIAMETER AND DEPTH AS REQUIRED.
  - CLEAN HOLE OF DUST AND DEBRIS.
  - FILL HOLE WITH DOWELLING GROUT.
  - INSTALL REINFORCING DOWEL BAR AND WIPE AWAY OVERFLOW.
  - SECURE DOWEL BAR FIRMLY IN POSITION AND DO NOT DISTURB BAR FOR 24 HOURS AFTER INSTALLATION.


**DOWELLING IN EXISTING CONCRETE (GID)**

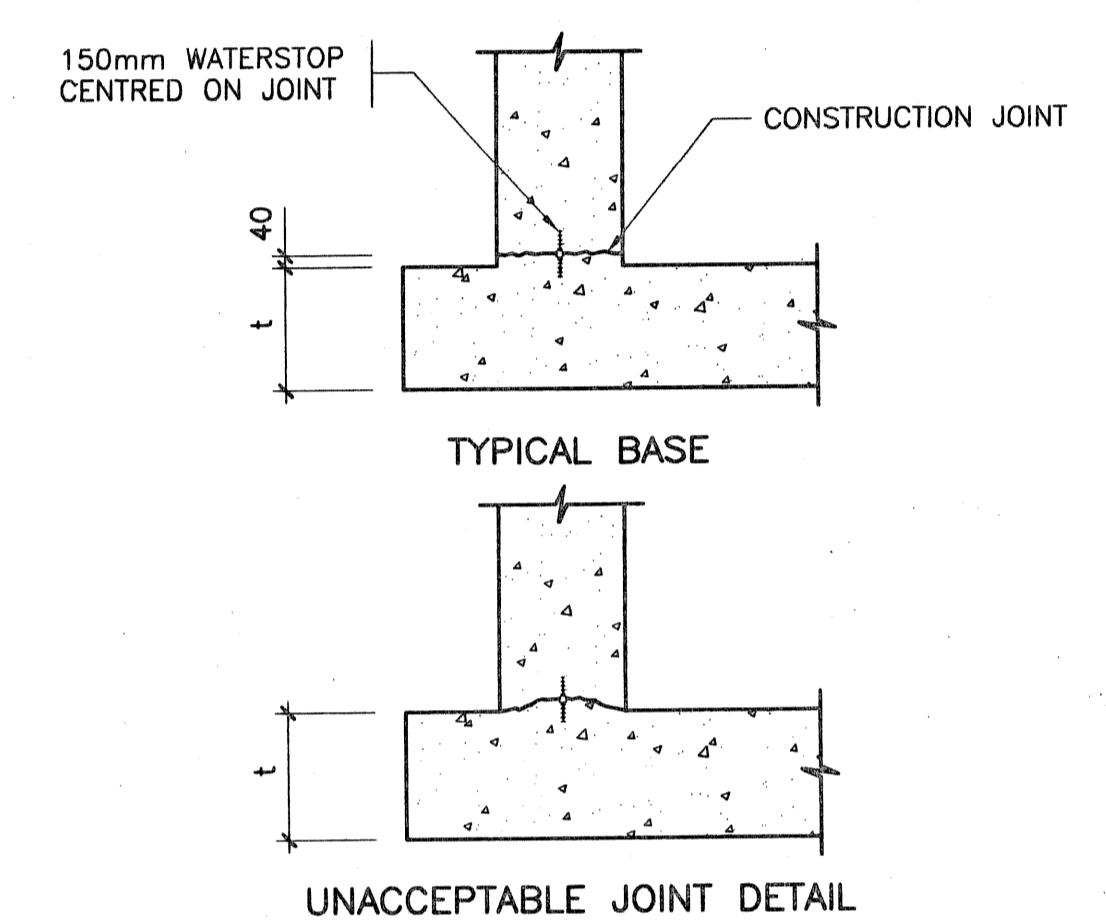

**WALLS BASE CONSTRUCTION JOINT**

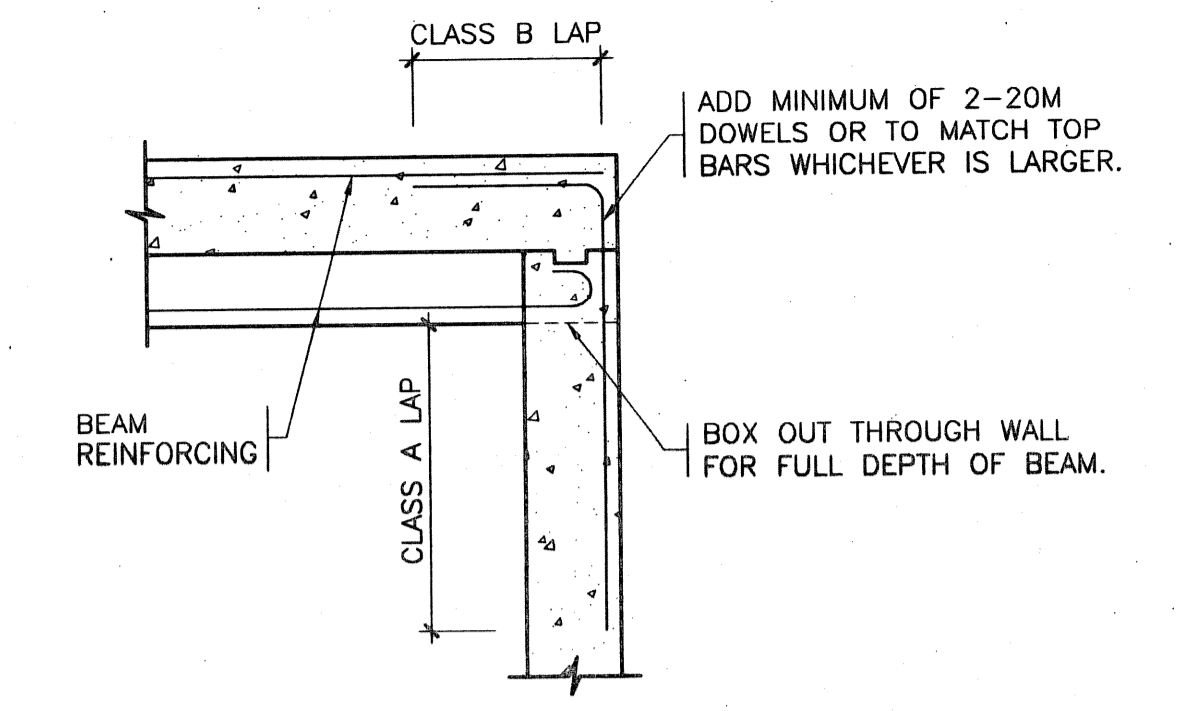


**CONCRETE BEAM END REINFORCING**

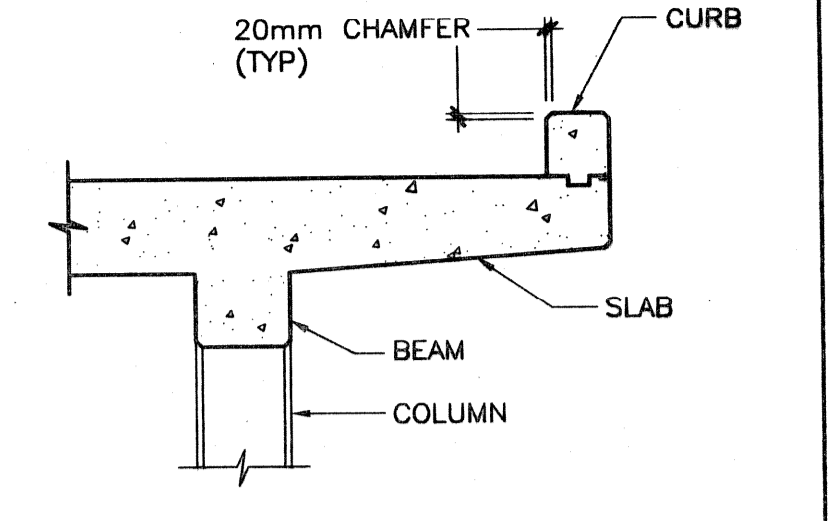


NOTE:  
PROVIDE CHAMFER ALONG EXPOSED EDGES ON CONCRETE SLABS, BEAMS, CURBS, COLUMNS, WALL OPENINGS AND SIMILAR ITEMS UNLESS OTHERWISE NOTED OR DIRECTED.

**CHAMFERS**

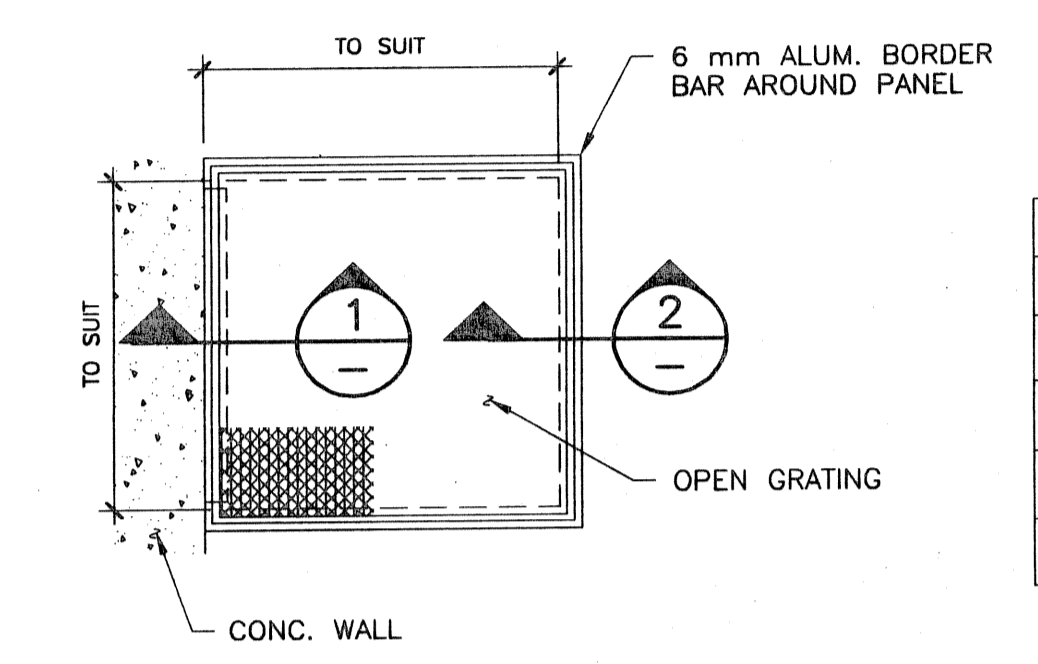

C	ANGLE SIZE
19 mm	∠ 25 x 25 x 6
25 mm	∠ 31 x 31 x 6
31 mm	∠ 38 x 38 x 6
38 mm	∠ 44 x 44 x 6
45 mm	∠ 50 x 50 x 6

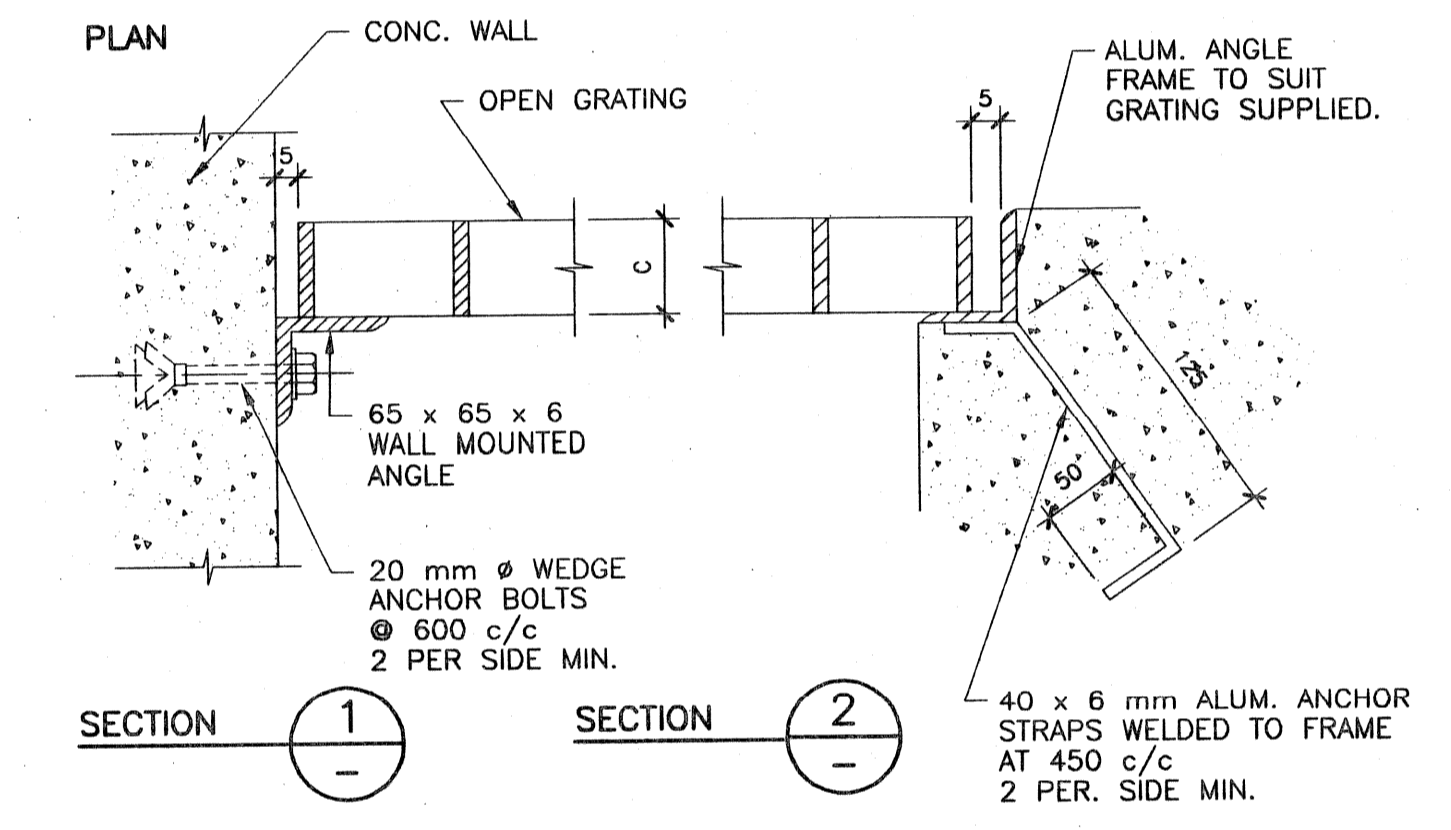

**ALUMINUM OPEN GRATING**

These record documents have been prepared based on information provided by others. The design professional has not verified the accuracy and/or the completeness of this information and shall not be responsible for any errors or omissions which may be incorporated herein as a result.

**RECORD DRAWING**

**THE CITY OF WINNIPEG**  
WORKS AND OPERATIONS DIVISION  
WATER AND WASTE DEPARTMENT

**SHOAL LAKE AQUEDUCT**  
MILE 12.86 DRAIN CHAMBER AND OUTFALL

CITY DRAWING NUMBER D-4356A  
SHEET 9 OF 23

**S3** REV. R1

MISCELLANEOUS DETAILS

FOR ABBREVIATIONS SEE DWG A1

**CGSS**  
CH2M GORE & STORRIE LIMITED

DESIGNED BY YTC      CHECKED BY ARP, RPP  
DRAWN BY MKG      APPROVED BY  
HOR. SCALE NTS      RELEASED FOR CONSTRUCTION  
VERTICAL SCALE NTS

R1 RECORD DRAWING      98.05.29 DHG      DATE 1996.08.12      DATE

ENGINEER'S SEAL  
**ORIGINAL TENDER DRAWING SEALED**

CONSULTANT DRAWING NO. 60010-53-A1-15509