


# INSTRUMENT LOOP DIAGRAM

LOOP NO. DD-257-LT

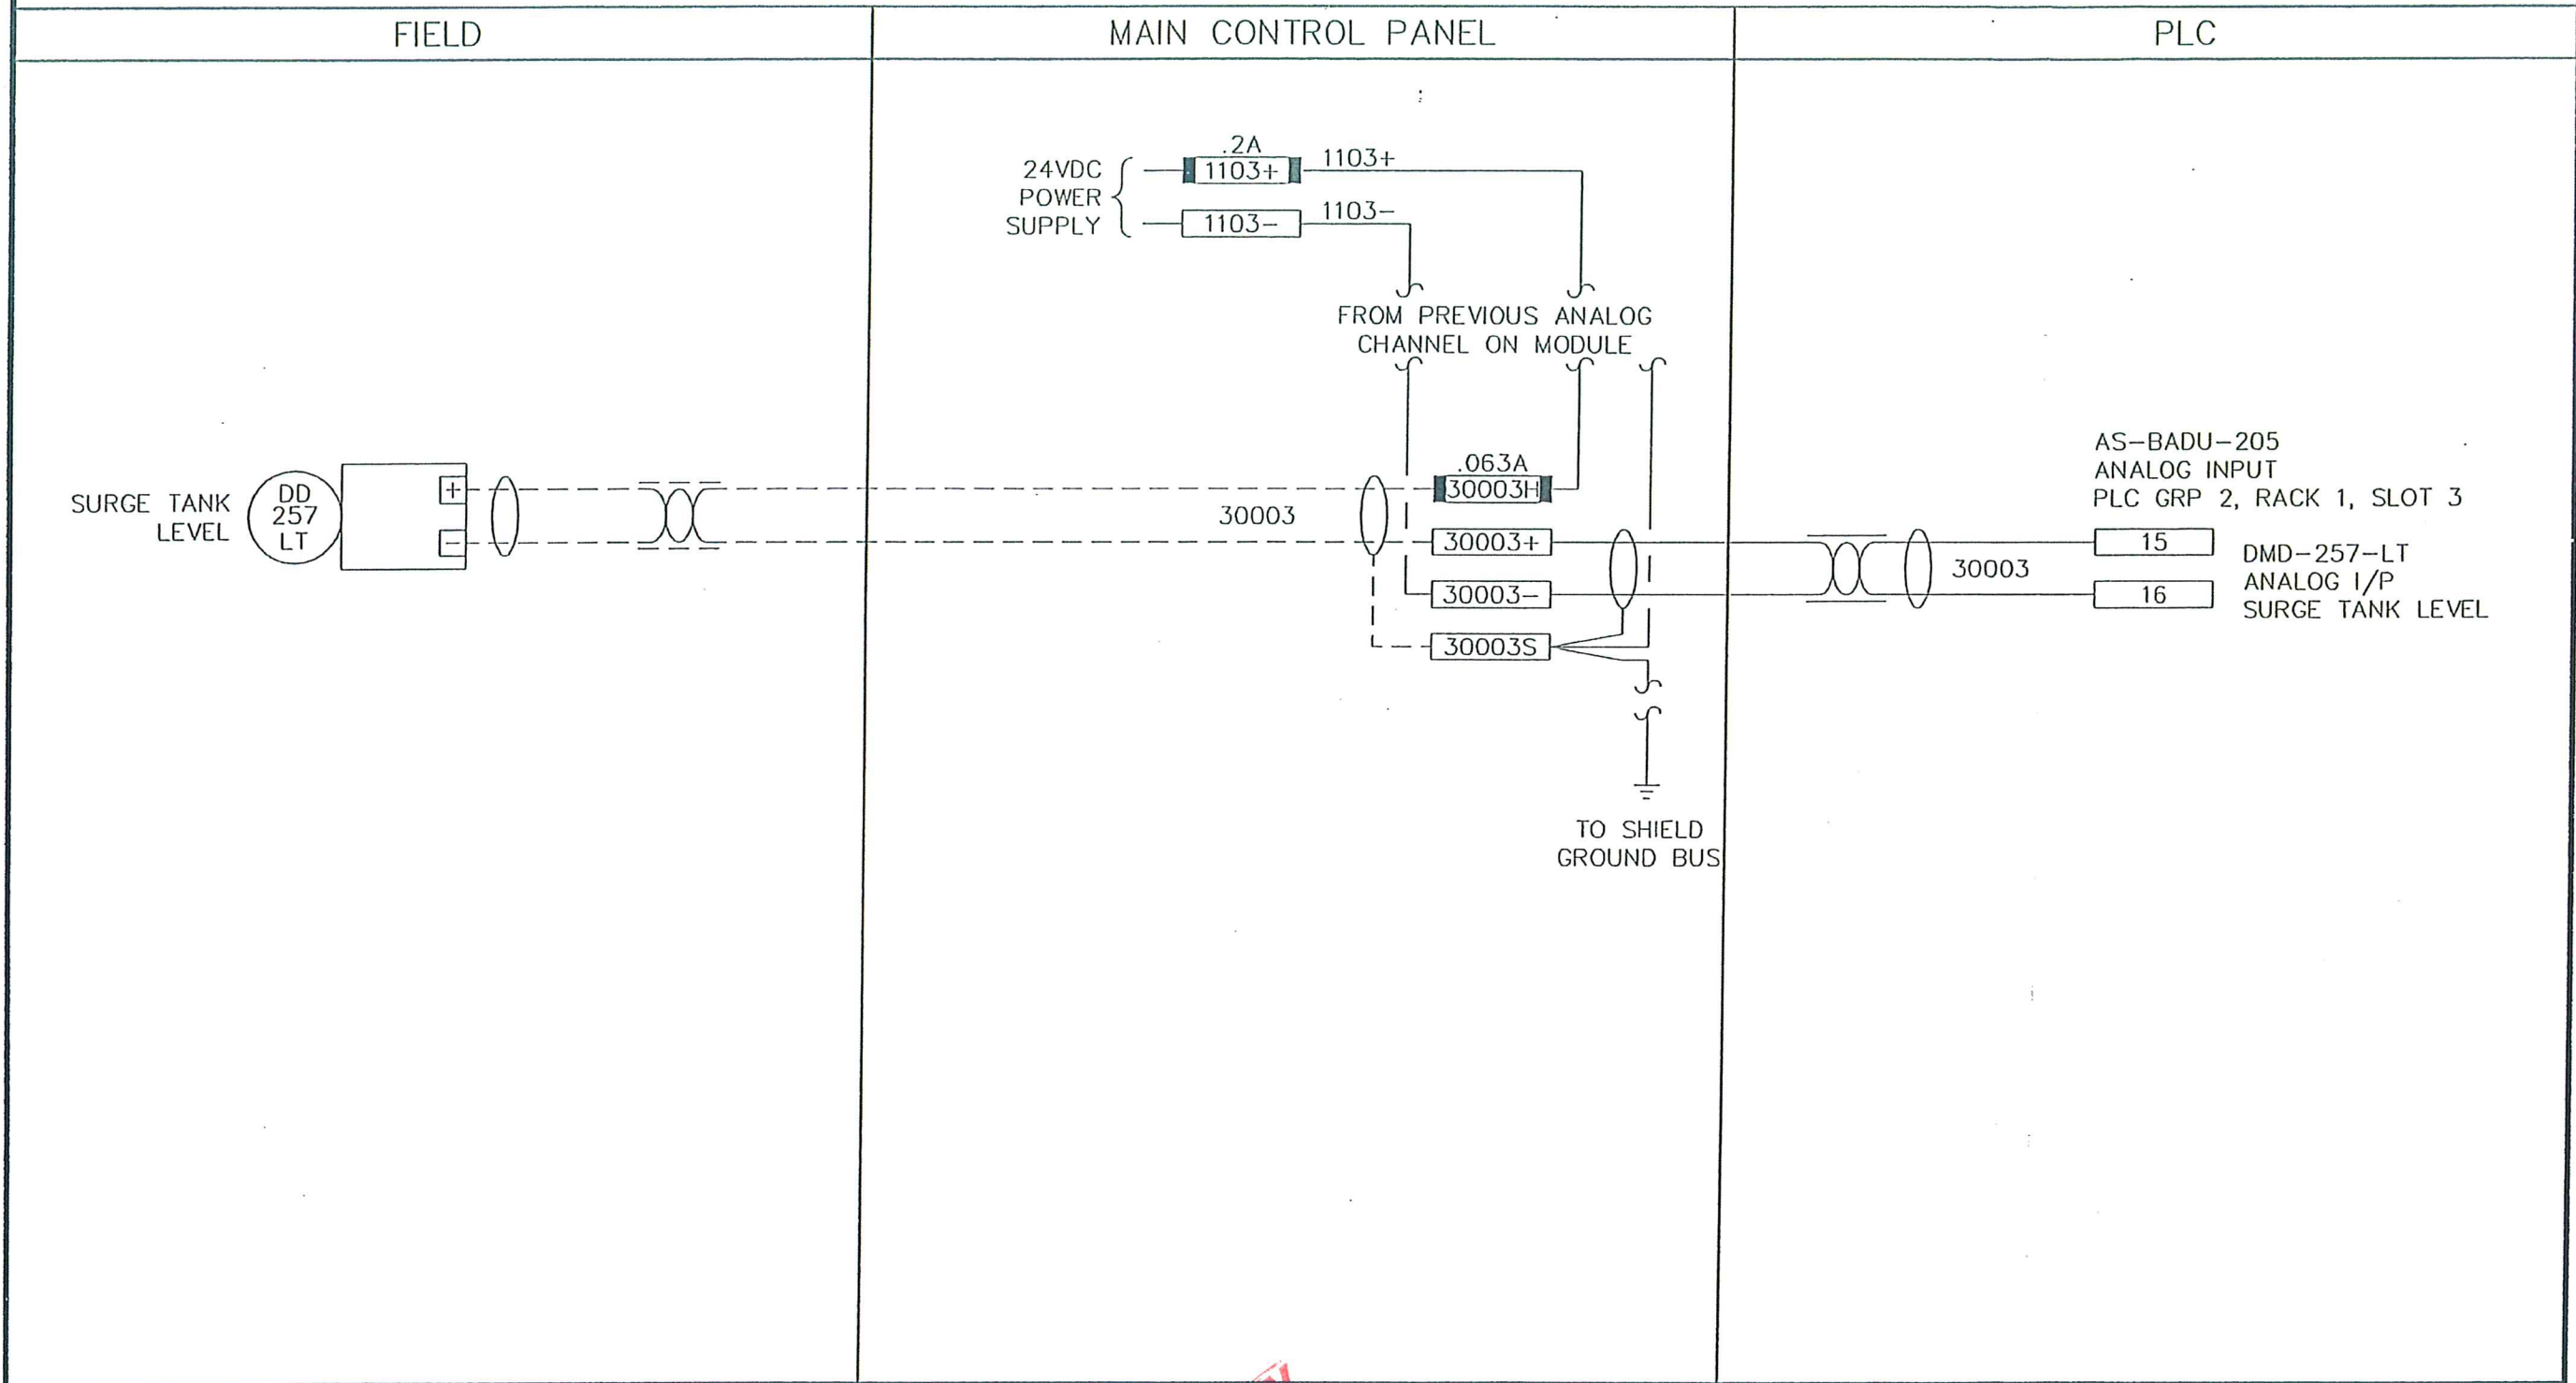

NOTE:

	JOB NO. 3153
Calgary, Alberta	FILENAME D2864
95.06.30 1 AS-BUILT	PL
94.09.14 0 ISSUED FOR CONST.	PL
94.08.10 A ISSUED FOR APPROVAL	PL
DATE	REVISION APP.



THE CITY OF WINNIPEG  
REGIONAL WATER SUPPLY SYSTEM  
INSTRUMENTATION CONTROL AND DATA ACQUISITION

DEACON BOOSTER PUMPING STATION - MCP  
SURGE TANK LEVEL TRANSMITTER

SCALE \_\_\_\_\_  
DATE 94.08.17  
DES PL DWN LFB  
CKD DN APP LK

DRAWING NO.  
D-2864