


W/T EXIST. CYCLONE CONTROL PANEL (REFER DWG. 1501-5A/6/7A/7B)

NOTE: REFER TO DWG. 1501-6/7A/7B FOR TERMINATION DETAILS

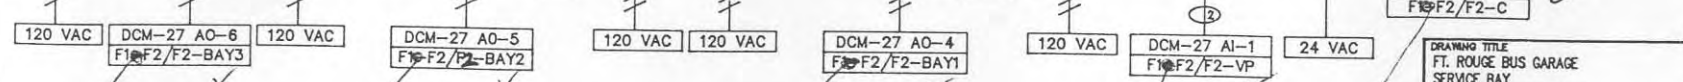

DRAWING TITLE
FT. ROUGE BUS GARAGE SERVICE BAY
HORIZONTAL VENTILATION SYSTEM 2

PROJECT
WINNIEP TRANSIT METASTYS FACILITY MANAGEMENT SYSTEM

EF-74 DELETED	4	1098-5006	08/24/00	JCF
ALSO SEE 1501-5A	3	AS BUILT	08/25/00	JCF
CHANGE ORDER 1	2	DWG. REARRANGED	12/28/00	JCF
REFERENCE DRAWING NO.	1	DPS-1 & 2 ADDED	08/11/00	JCF
SALES ENGR. PROJECT NO.	ENGR.	REVISION-LOCATION	ECON	DATE
BY JCF	DATE	12/28/00	BY	APPROVED
PROJECT		JOHNSON CONTROLS LTD		CONTRACT NUMBER
WINNIEP TRANSIT METASTYS FACILITY MANAGEMENT SYSTEM		600 WILKINSON STREET		90098-0310
		WINNIEP, MANITOBA		DRAWING NUMBER
		R31 3/8		1501-5B
		204-885-9360		