



ELECTRIC / DEMAND  
XRL 28 BI 4 ✓

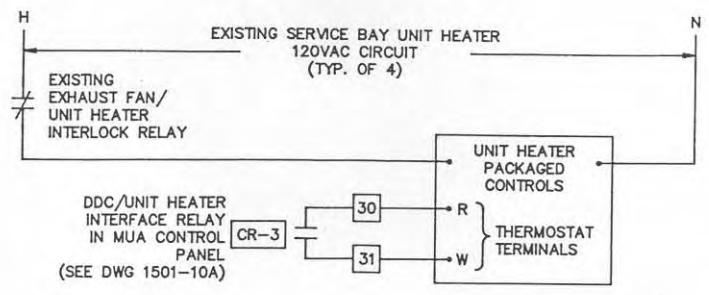

**LEGEND**

- n EXISTING M.C.C. TERMINALS
- n METASYS BASEFRAME TERMINALS
- nm WIRE/CABLE NUMBER

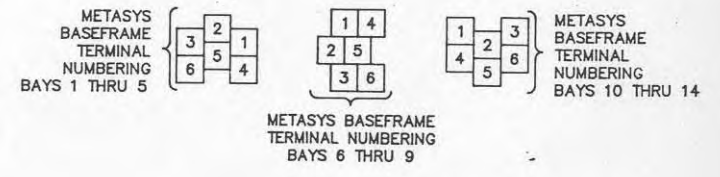

DRAWING TITLE		3 1098-5008		FILE: VENTFANB
FT. ROUGE BUS GARAGE		2 AS BUILT		10/15/91 CE
SERVICE BAY & HORIZONTAL		1 WAS DWG. 1501-7		09/25/91 JF
VENTILATION SYSTEM & DEMAND		REFERENCE DRAWING NO. REVISION-LOCATION		12/10/91 JF
METER WIRING DETAILS		SALES ENGR PROJECT MGR APPL ENGR		ECN DATE I BY
PROJECT		BY: F DATE: 12/10/91		APPROVED
WINNIPEG TRANSIT		DRAWN		DATE
METASYS FACILITY		BY: F DATE: 12/10/91		CONTRACT NUMBER
MANAGEMENT SYSTEM		JOHNSON CONTROLS		90098-0310
		Systems & Services Division		DRAWING NUMBER
				1501-7B