


1MTR	SUPPLY FAN MOTOR	
1M	MAGNETIC STARTER COIL 1MTR	
1M-1	N.O. STARTER CONTACTS 1M	
OLa	THERMAL OVERLOADS	
TR1	LINE/24VAC TRANSFORMER	
CB	10 AMP CIRCUIT BREAKER	
1TD-1	N.O. CONTACT 1TD	
2MTR	2 POSITION DAMPER MOTOR	
DMES	DAMPER MOTOR END SWITCH	
EPS	EXHAUST PROVING SWITCH	NOT USED IN THIS APPLICATION
R1	EXHAUST RELAY	
R1-1	N.O. CONTACTS R1	
1TD-2	N.C. CONTACTS 1TD	
1TD	BLOWER TIME DELAY	
SW-1	SYSTEM SWITCH	REMOTE PANEL
SW-2	HEAT SWITCH	REMOTE PANEL
1M-2	N.O. AUXILIARY CONTACTS 1M	LOCKS OUT BURNER ON LOW AIRFLOW
1LT	BLOWER LIGHT	REMOTE PANEL
2LT	HEAT LIGHT	REMOTE PANEL
1HL	INLET HIGH LIMIT	SET AT 170°F

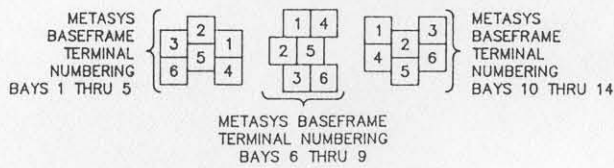

LEGEND

n EXISTING M.C.C. OR MUA TERMINALS

n METASYS BASEFRAME TERMINALS

DRAWING TITLE		FILE: STJ-OFF	
ST. JAMES BUS GARAGE			
OFFICE AREA MUA-11			
WIRING DETAILS			
REFERENCE DRAWING NO.	1	AS BUILT	DATE BY
SALES ENGR/PROJECT MGR/APPL ENGR	BH	REVISION-LOCATION	ECN DATE BY
ENGR	DW	DRAWN	APPROVED
DATE	05/28/00	DATE	
PROJECT	WINNIEG TRANSIT	CONTRACT NUMBER	90098-0310
METASYS FACILITY	MANAGEMENT SYSTEM	DRAWING NUMBER	1501-28
JOHNSON CONTROLS		Systems & Services Division	