




SUNFIRE WASTE OIL HEATING UNIT SYSTEM LAYOUT

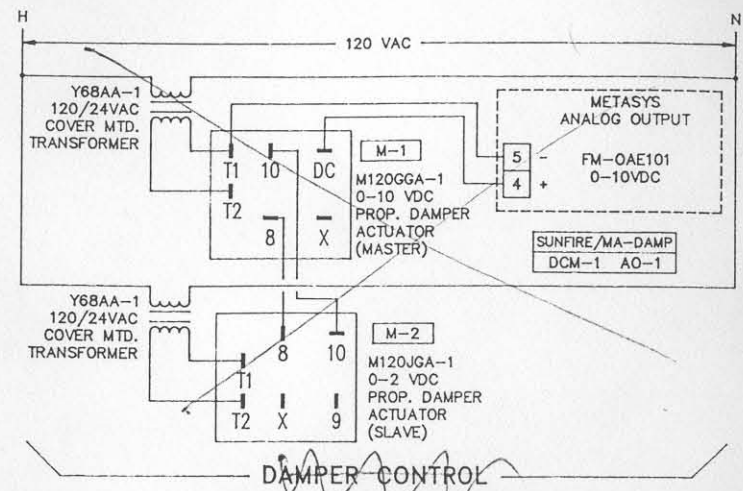


DAMPER CONTROL

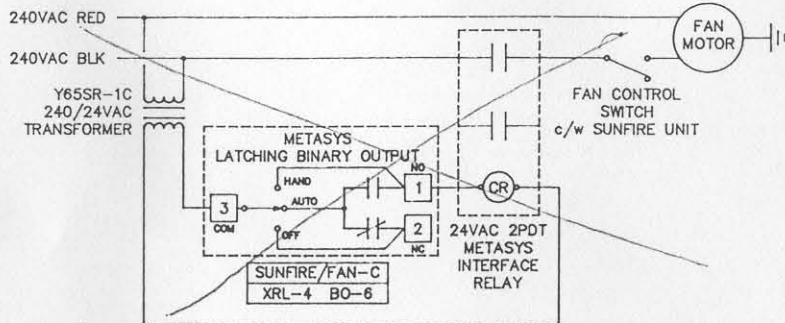


FAN CONTROL

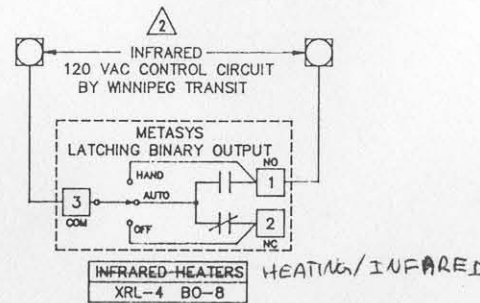


INFRARED HEATER CONTROL

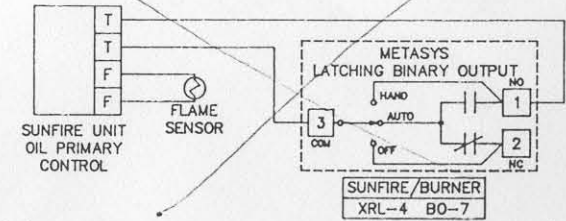

BURNER CONTROL

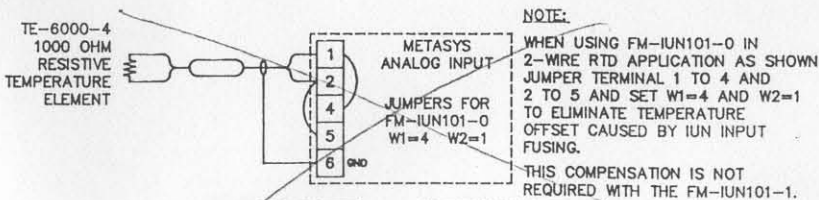


TEMPERATURE MONITORING

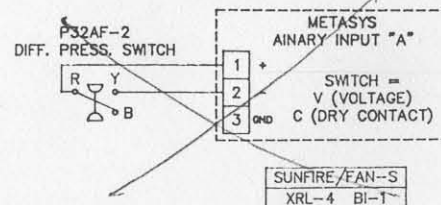

FAN STATUS MONITORING

LEGEND

- EXISTING M.C.C. TERMINALS
- METASYS BASEFRAME TERMINALS
- WIRE/CABLE NUMBER

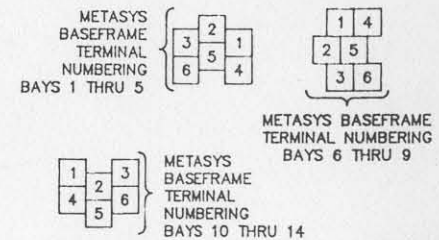

DRAWING TITLE		FILE: SPIRESYS	
ST. JAMES BUS GARAGE		INFRARED HEATERS	2 2098-5007/AS BLT
SUNFIRE WASTE OIL		AS BUILT	1 1098-5004
HEATING UNIT SYSTEM LAYOUT		REFERENCE DRAWING NO.	1 1098-5004
		SALES ENG/PROJECT MAN/APPL ENGR	DATE
		BY	DATE
		CHK	DATE
		APPV	DATE
PROJECT		CONTRACT NUMBER	
WINNIPEG TRANSIT		9009B-0310	
METASYS FACILITY		800 MORAY STREET	
MANAGEMENT SYSTEM		WINNIPEG, MANITOBA	
		R3J 3V9	
		DRAWING NUMBER	
		1501-29	
		204-685-8300	