



Address: 65 GARRY STREET
 Project No.:
 Description: THIRD FLOOR BASE PLAN
 Sheet No.:
 Date:
 File Name: 00065GY03

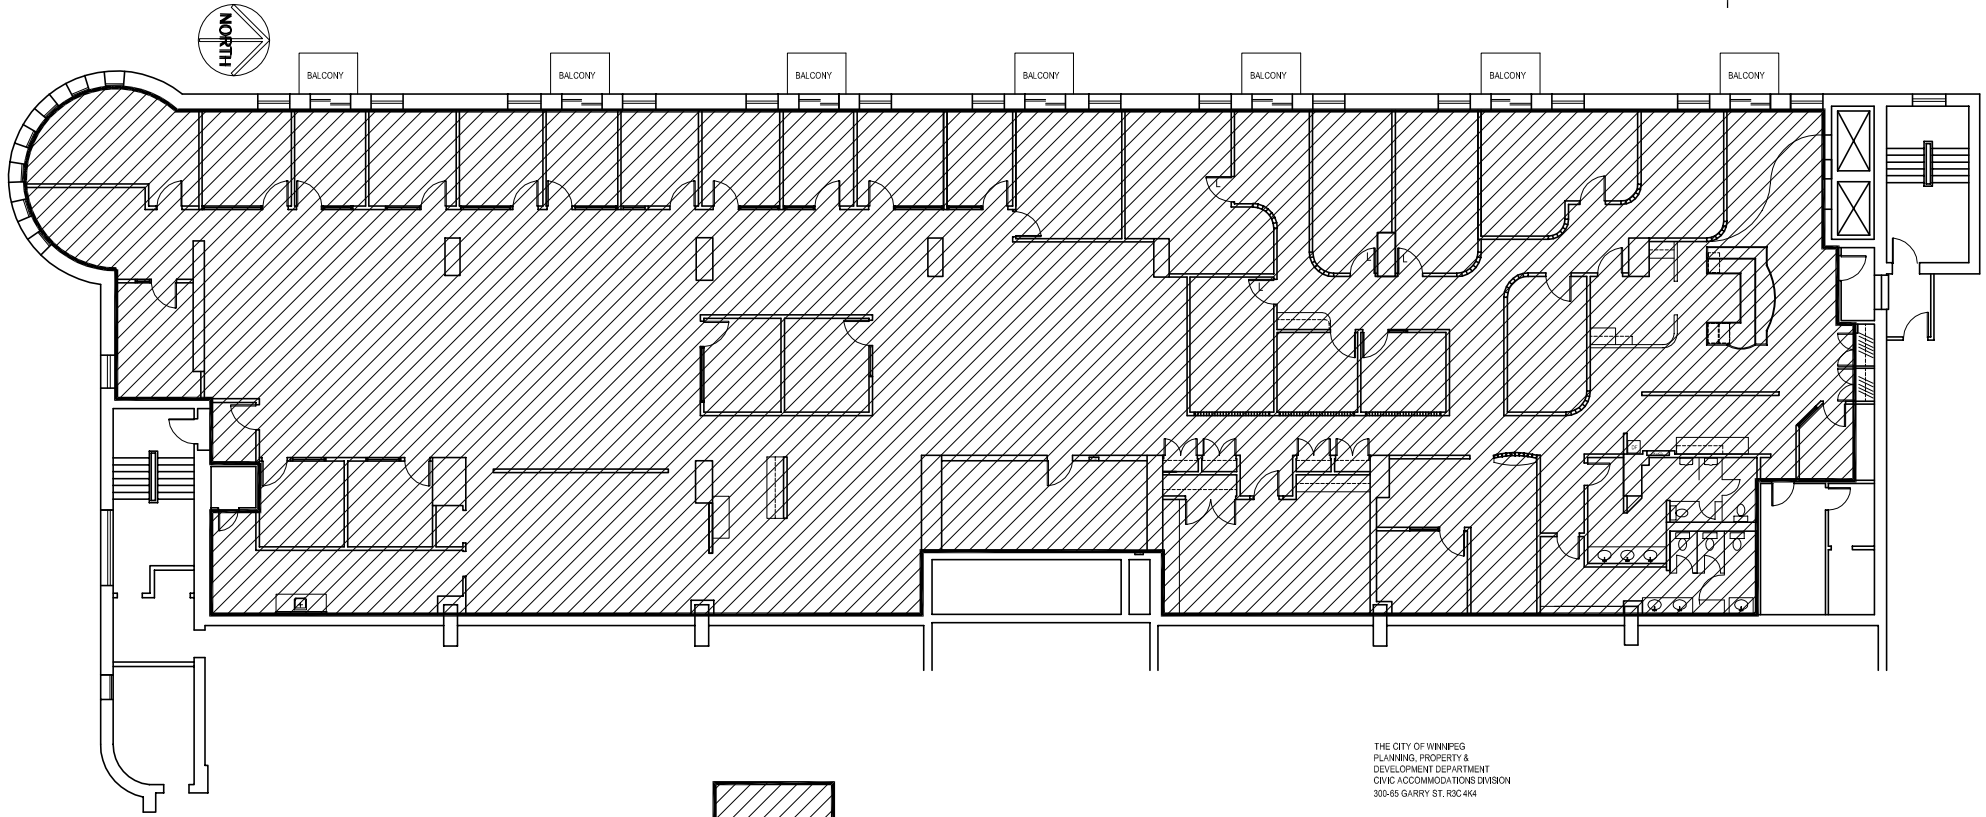

AREAS TO CLEAN

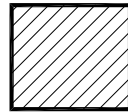

11,901 SQUARE FEET

THE CITY OF WINNIPEG
 PLANNING, PROPERTY &
 DEVELOPMENT DEPARTMENT
 CIVIC ACCOMMODATIONS DIVISION
 300-65 GARRY ST. R3C 4K4

NOTES:

AS-BUILT UPDATE DEC 2003 MMK
 AS-BUILT UPDATE SEPT. 13/200 JAD
 AS-BUILT MAY 1/00

NO.	REVISION DESCRIPTION	BY	DATE
SCALE			

DRAWN BY	CHECKED BY	APPROVED
DATE	USER APPROVAL	

THE CITY OF WINNIPEG
 PLANNING, PROPERTY &
 DEVELOPMENT DEPARTMENT
 CIVIC ACCOMMODATIONS DIVISION
 PROJECT 300-65 GARRY ST. R3C 4K4

65 GARRY STREET

SHEET TITLE		
THIRD FLOOR		
0065GY03		
SCALE	PROJECT NO.	SHEET NO.
N.T.S.		A-1