

**LIST OF MATERIALS FOR METER PIT**

| ITEM | DESCRIPTION  | LENGTH  |
|------|--|---------|
| A.   | 24" CONC. PIPE (FLANGE TO BELL)                      | 6'-0"   |
| B.   | 24" CONC. PIPE (VICTAULIC TO FLANGE)                 | 8'-0"   |
| C.   | 2-24" VICTAULIC BUTTERFLY VALVE                      | 1'-6"   |
| D.   | 24" x 24" x 12" CONC. TEE (VICT. TO VICT. TO FLANGE) | 4'-0"   |
| E.   | 24" CONC. PIPE (FLANGE TO VICTAULIC)                 | 6'-0"   |
| F.   | 12" C.I. FILLER PIECE FLANGED                        | 1'-0"   |
| G.   | 12" C.I. ELBOW FLANGED                               | 1'-7"   |
| H.   | 2-12" x 8" C.I. REDUCER/INCREASER FLANGED            | 1'-2"   |
| I.   | 2-8" GATE VALVES FLANGED                             | 11 1/2" |
| J.   | 2-8" C.I. FILLER PIECES FLANGED WITH OUTLETS         | 1'-0"   |
| K.   | 8" MAGNETIC-FLOW METER FLANGED                       | 3'-0"   |
| L.   | 2-8" C.I. FILLER PIECES (FLANGE TO VICTAULIC)        | 0'-6"   |
| M.   | 12" C.I. PIPE (FLANGE TO BELL)                       | 4'-0"   |

**NOTE:**

- ITEMS J. TO HAVE 3" TAPPED HOLES ON OPPOSITE SIDES.
- ITEM M. TO HAVE A CONCRETE RING 1'-4" FROM THE FLANGED END.
- THE METRO CORPORATION WILL SUPPLY ITEMS A., B., C., D., E., I., J., K.; ALSO 4-24" VICTAULIC COUPLINGS AND AN 8" VICTAULIC COUPLING.

**NOTE:**

FOR FURTHER DETAILS AND NOTES ON METER PIT SEE DWG. D-1111

AS BUILT V.D. APRIL, 1971

**REVISIONS**

| NO. | DESCRIPTION         | DATE      | BY   |
|-----|---------------------|-----------|------|
| 1   | TITLE BLOCK REVISED | 02 NOV 90 | JMBD |
| 2   |                     |           |      |
| 3   |                     |           |      |
| 4   |                     |           |      |
| 5   |                     |           |      |
| 6   |                     |           |      |
| 7   |                     |           |      |
| 8   |                     |           |      |

THE METROPOLITAN CORPORATION OF GREATER WINNIPEG  
**WATERWORKS & WASTE DISPOSAL DIVISION**  
WATERWORKS DEPT.


CHARLESWOOD-ASSINABOIA FEEDERMAIN RIVER CROSSING  
METER PIT - ROUGE ROAD AT ASSINABOINE AVENUE  
STA. 2+04.10

APPROVED BY: [Signature]  
DESIGNED BY: W.S.B.  
DRAWN BY: A.C.  
DATE: JULY 31/71

CHIEF ENGINEER

SCALES AS NOTED

DRAWING NO. **D-1110**

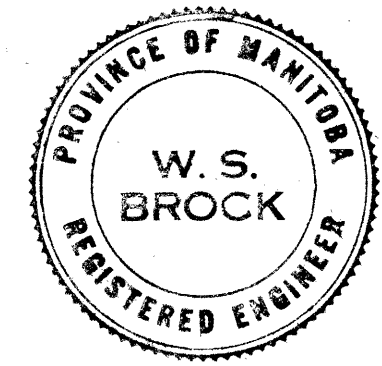

**DETAIL OF METER PIT AT STA. 204.1**  
SCALE: 1/2" = 1'-0"

**SEC. 'A-A' LONG SECTION**

**SEC. 'B-B' CROSS-SECTION**