


- ① V-24-A OPEN TO B EMERGENCY CONNECTION TO #1 MANHOLE.
- ② V-24-B CLOSE B VALVE TO RESERVOIR NORTH END IN SUB CHAMBER.
- ③ V-14-B OPEN 6" SERVICE WATER VALVE.

6" DIA. SERVICE WATER TO RESERVOIR @ ELEV. = 746.50 TO BE REPLACED WITH PERMASTRAN PRESSURE PIPE CLASS 150"

CONNECT HERE

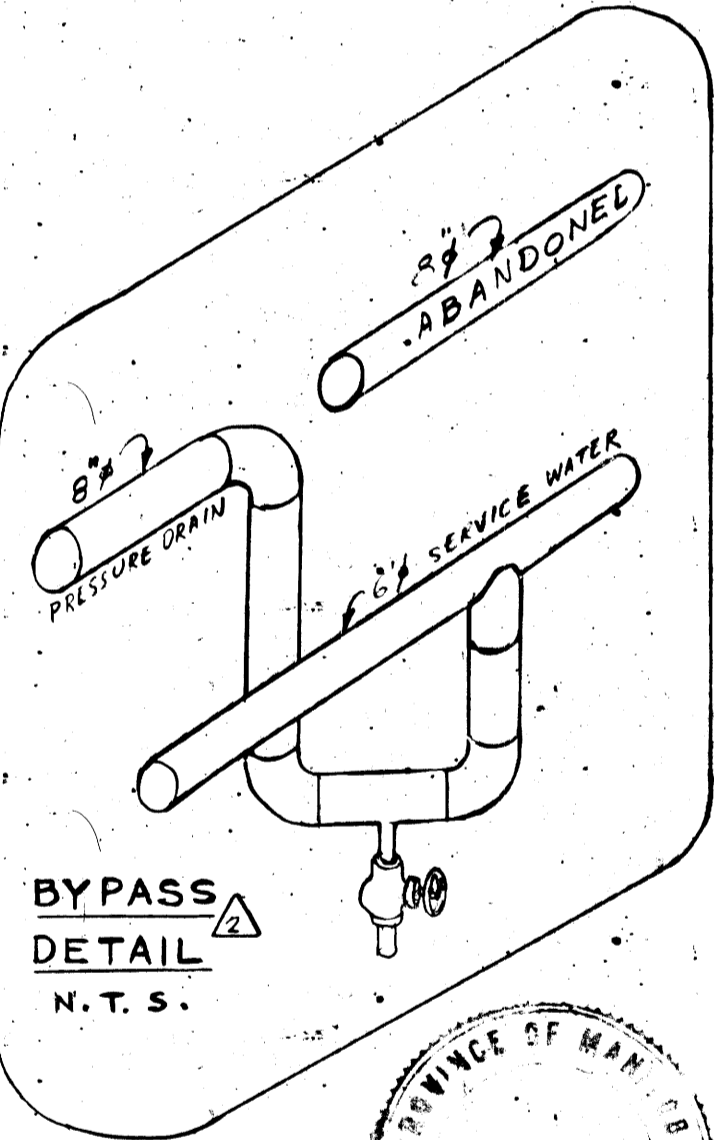

REVISED FOR SERVICE WATER REPLACEMENT 1 SEPTEMBER 1977
 BYPASS ADDED 28 JANUARY 1975
 REVISED AS BUILT JUNE 1965

THE METROPOLITAN CORPORATION OF GREATER WINNIPEG
 WATERWORKS AND WASTE DISPOSAL DIVISION

METRO EAST PUMPING STATION AND RESERVOIR

**CONTRACT A - PUMPING STATION
 MECHANICAL - PLAN ABOVE
 ELEVATIONS 730.00, 740.00 & 750.00**

APPROVED: <i>J. MacLaren</i> JAMES F. MACLAREN ASSOCIATES ENGINEERS TORONTO	DESIGN ENGINEER: <i>R. Somerville</i> ENGINEER OF WATERWORKS TEMPLETON ENGINEERING COMPANY PROFESSIONAL ENGINEERS WINNIPEG
DATE JUNE 22 1962	SCALE 1/8" = 1'-0"
DWG. NO. 17	OF 41
ME-24	