
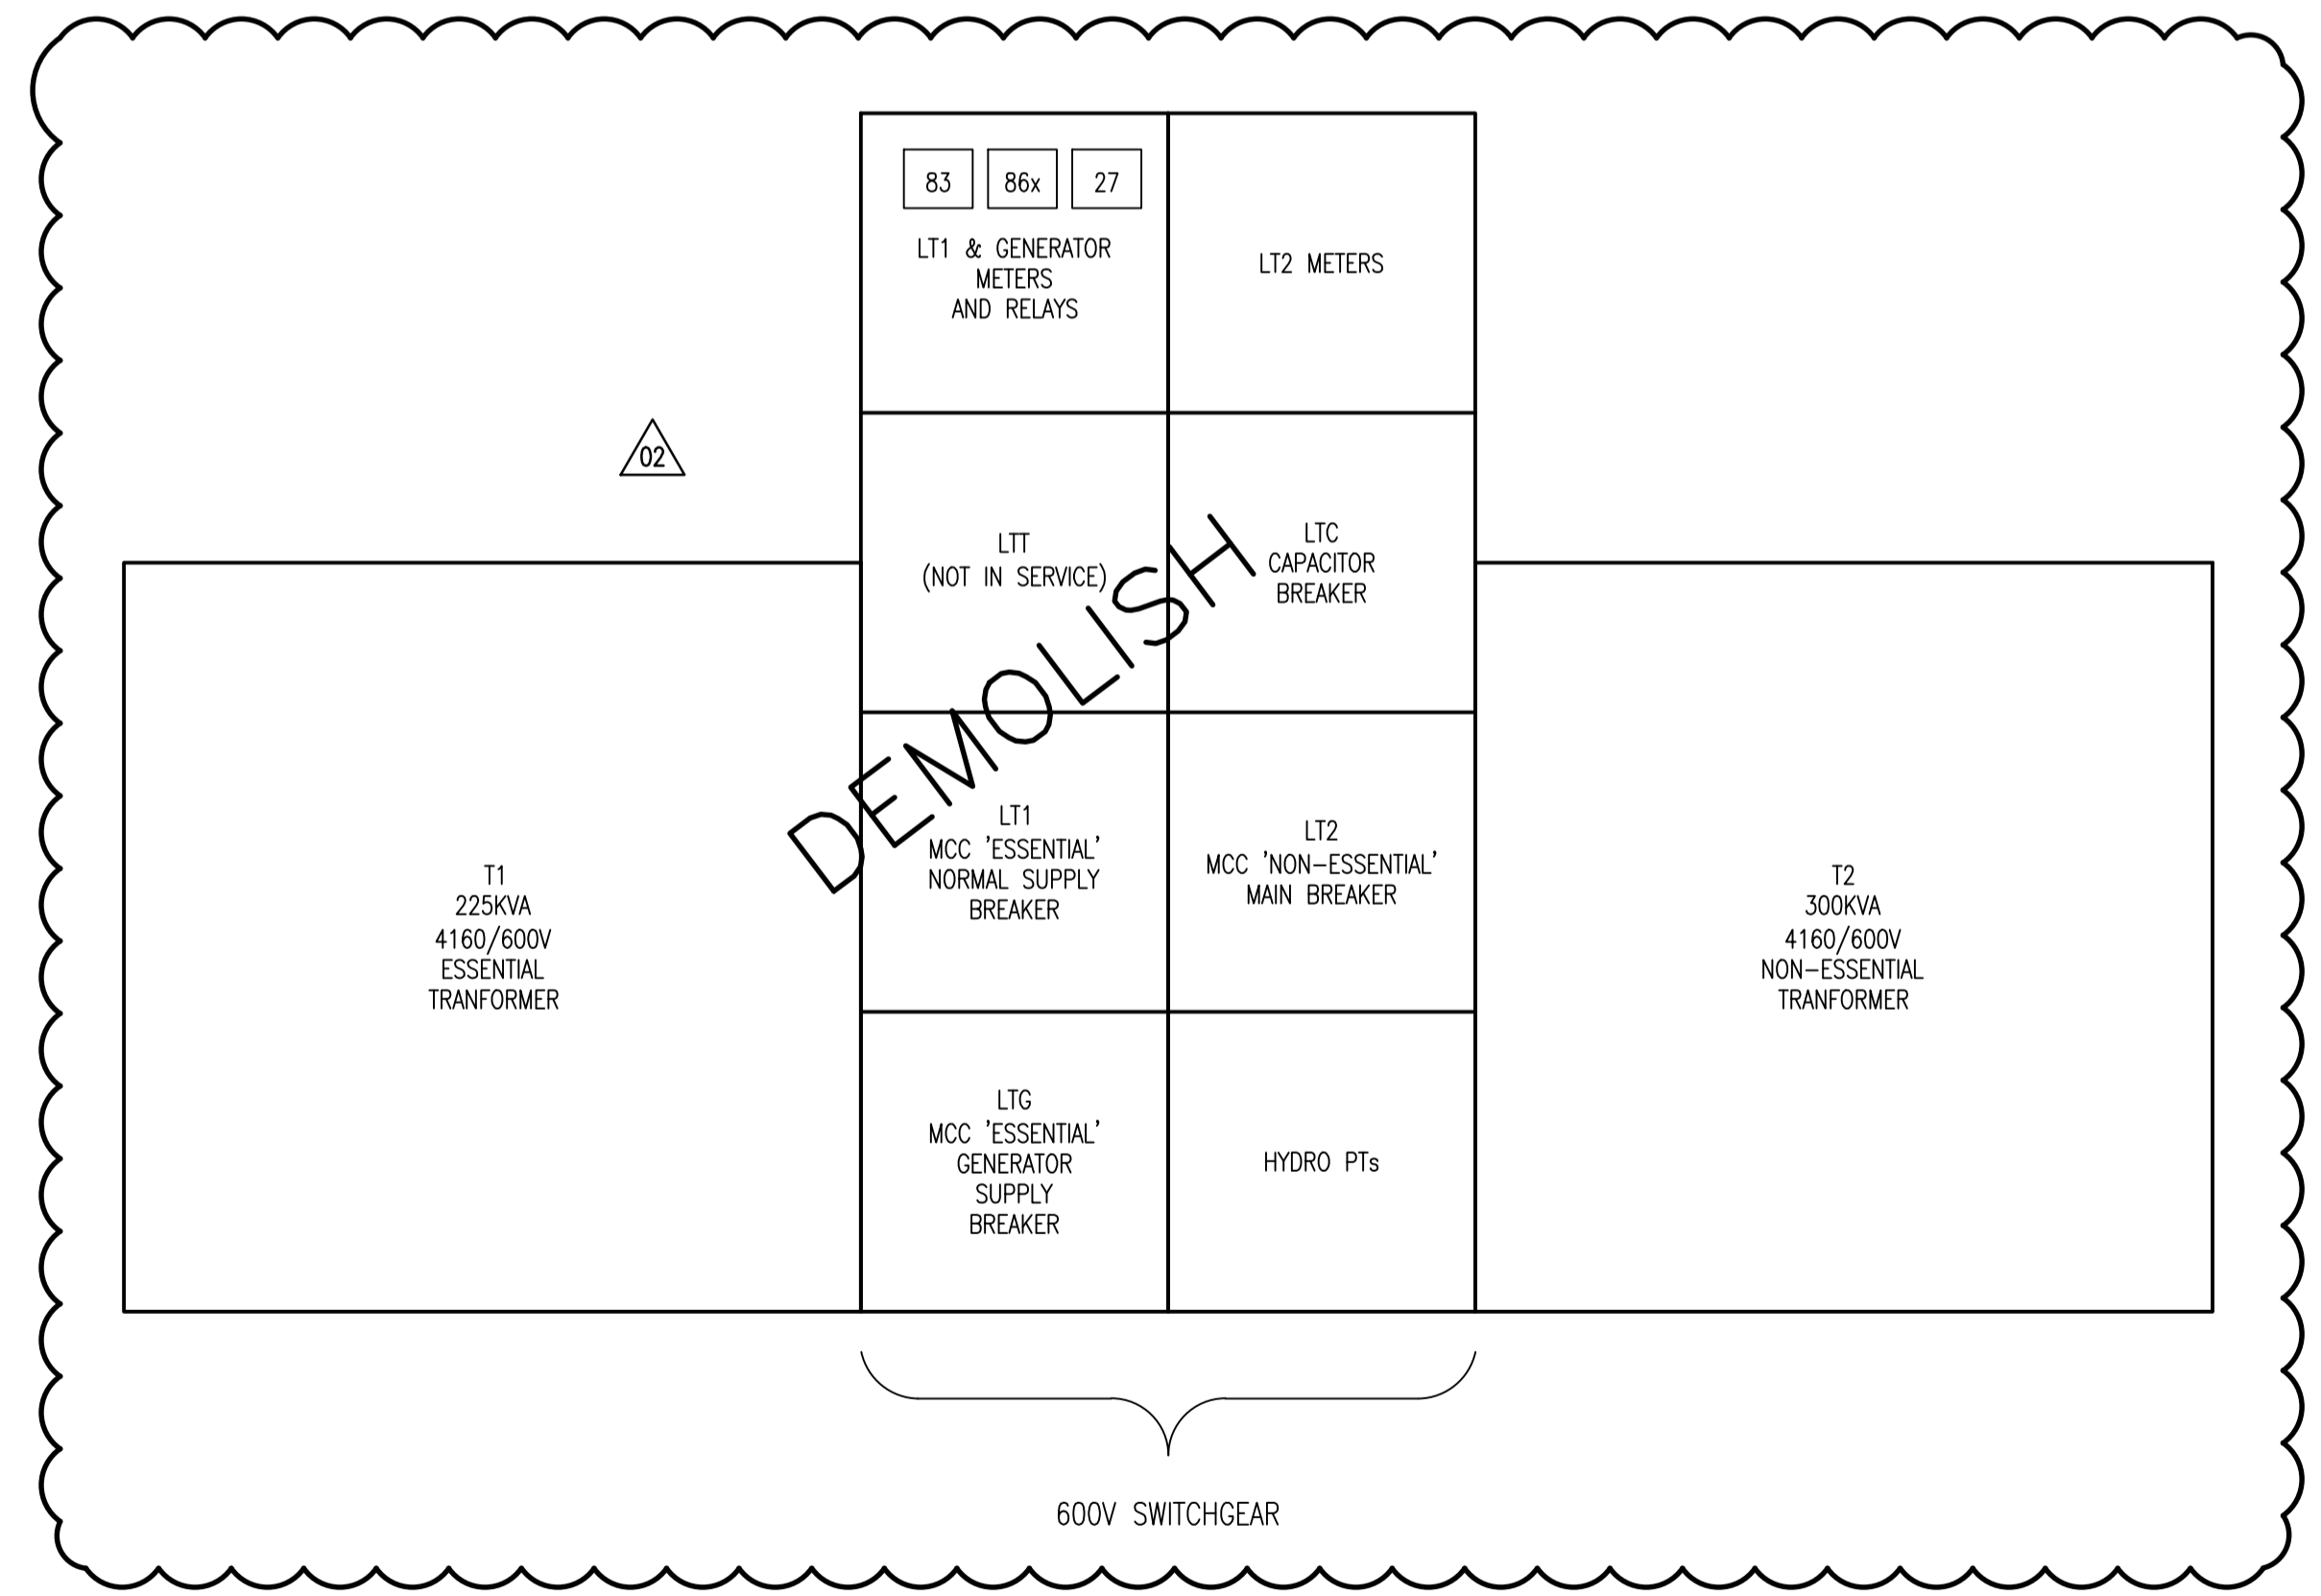


CONSTRUCTION NOTES:
 1. REPLACE EXISTING IQ DP-4000 MULTI-FUNCTION POWER METER WITH A SCHNEIDER ELECTRIC IQN7650. REFER TO DRAWING 1-0630M-E0015 FOR COMPLETE PART NUMBER.

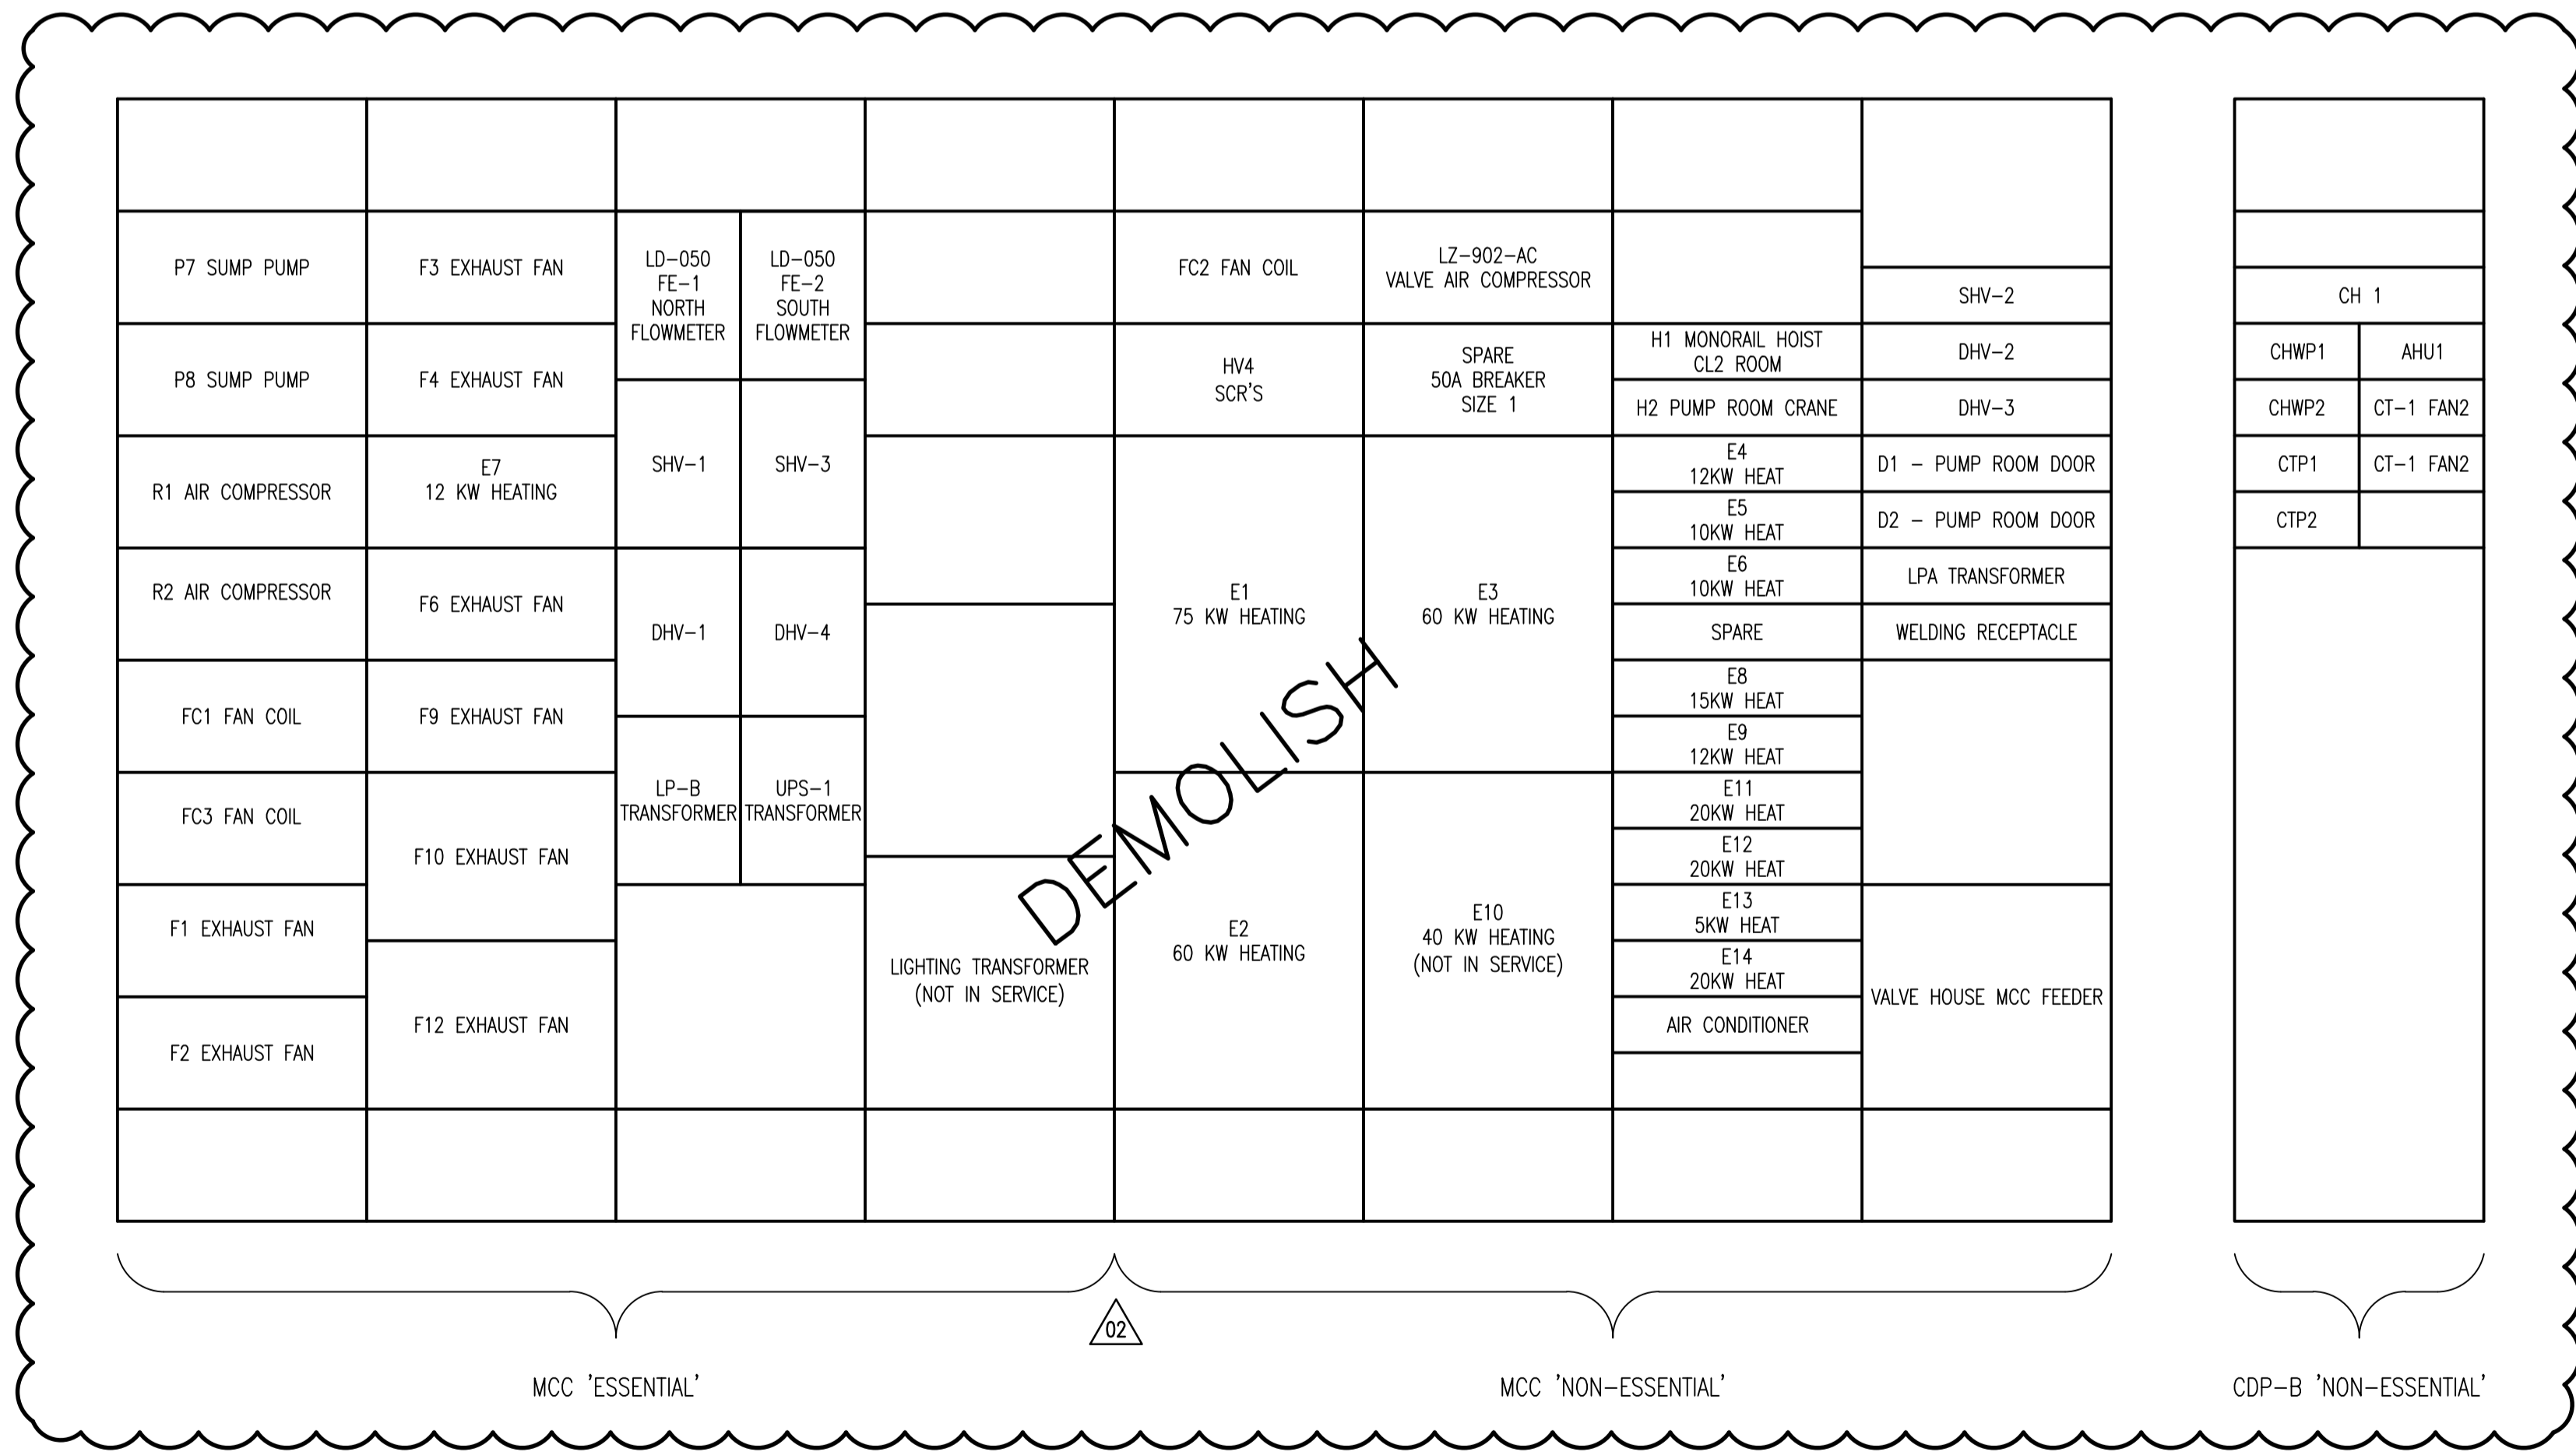

1-0630M-E0012	ELECTRICAL EQUIPMENT PLAN
DRAWING NUMBER	REFERENCE DRAWINGS

NOTES:
 1. THIS DRAWING IS BASED UPON EXISTING DOCUMENTATION AND SITE INSPECTION. DESIGN RESPONSIBILITY IS LIMITED TO THE MODIFICATIONS SHOWN.

APECM
 Certificate of Authorization
SNC-Lavalin Inc.
 No. 4489

NO.	REVISIONS	DATE	DESIGN	CHECK
02	ISSUED FOR TENDER, BID OPP. 490-2012	2012/07/23	BJC	CJR
01	AS-BUILT - MODIFIED PROTECTION RELAYS	2012/01/10	-	BJC
00	ISSUED FOR TENDER	2009/08/17	BDK	CJR

SNC-LAVALIN INC.
 148 Nature Park Way
 Winnipeg, MB, Canada R3P 0X7
 204-786-8080

DESIGNED BY: B. KING
 CHECKED BY: C. REIMER
 DRAWN BY: B. KING
 APPROVED BY: C. REIMER
 SCALE: NTS
 RELEASED FOR CONSTRUCTION BY: BJC
 DATE: 2009/08/17
 CONSULTANT NO.: 508955-0000-47DD-0013

THE CITY OF WINNIPEG
 WATER AND WASTE DEPARTMENT

MACLEAN WATER PUMPING STATION

ELECTRICAL EQUIPMENT ELEVATIONS
 4160V SWITCHGEAR & 600V SWITCHGEAR/MCC

CITY DRAWING NUMBER: 1-0630M-E0013

SHEET: 001
 REV: 02
 SIZE: A1