


INSTRUMENT LOOP DIAGRAM

LOOP NO. LZ-912-TAH

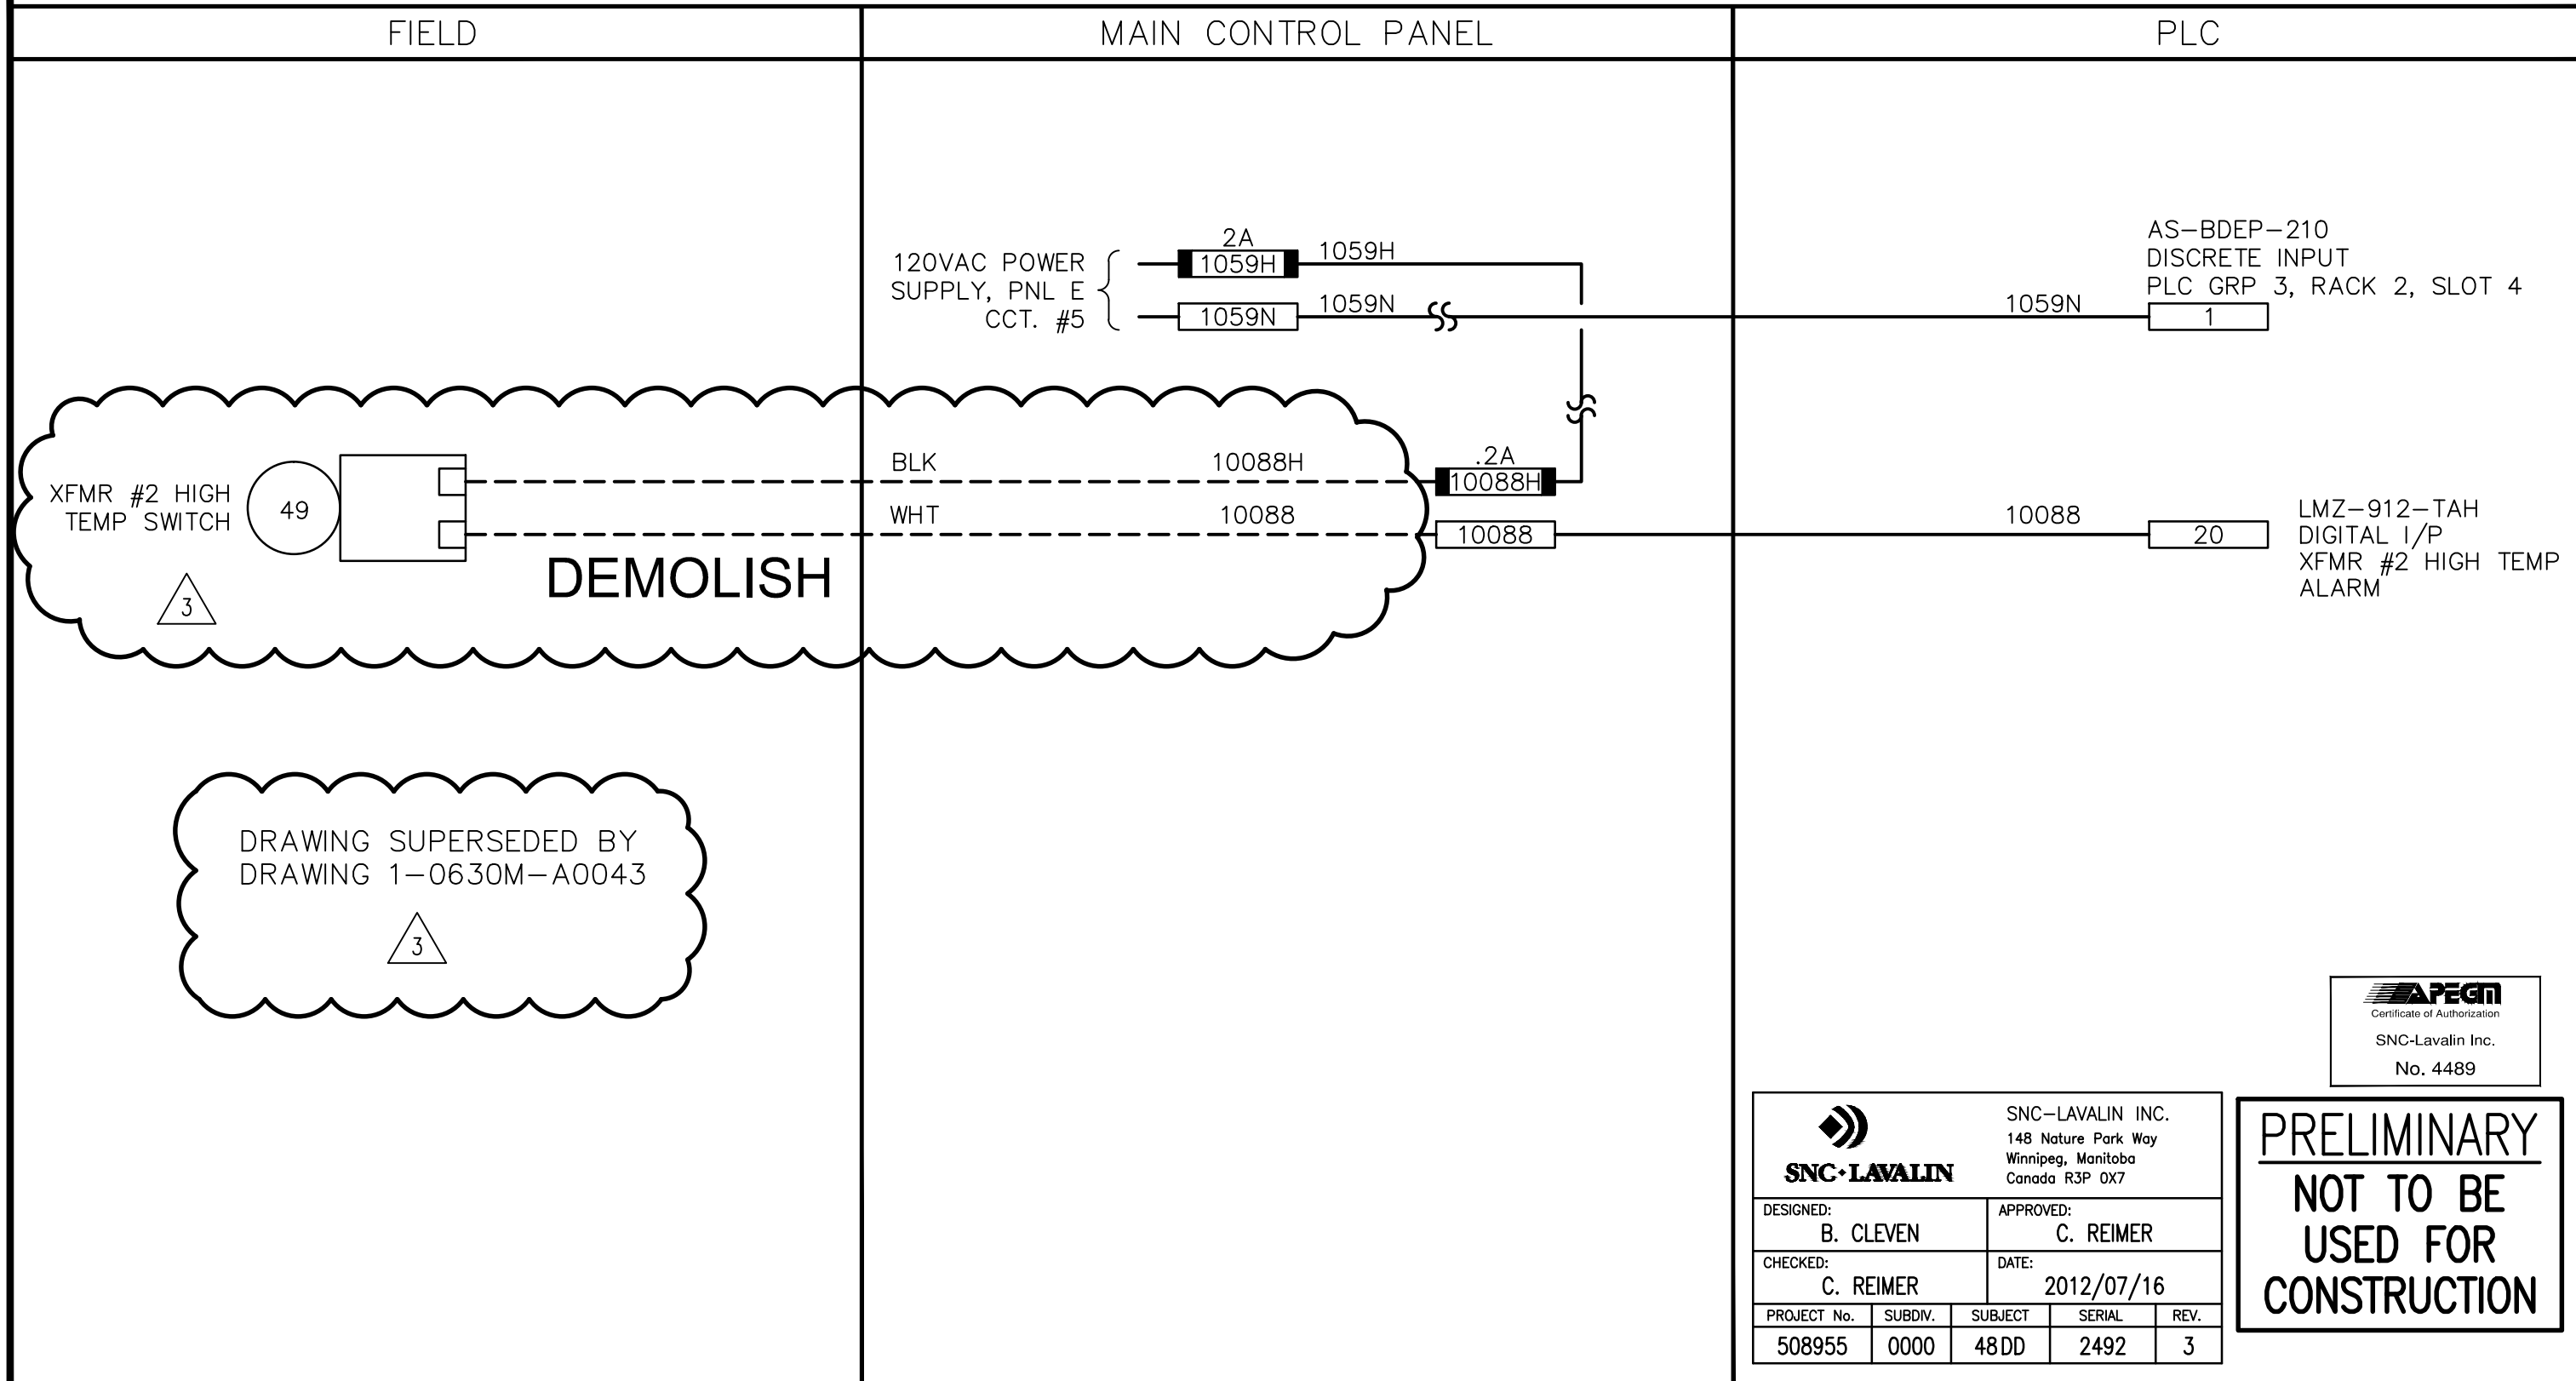

SNC-LAVALIN

SNC-LAVALIN INC.
148 Nature Park Way
Winnipeg, Manitoba
Canada R3P 0X7

DESIGNED: B. CLEVEN	APPROVED: C. REIMER			
CHECKED: C. REIMER	DATE: 2012/07/16			
PROJECT No. 508955	SUBDIV. 0000	SUBJECT 48DD	SERIAL 2492	REV. 3

**PRELIMINARY
NOT TO BE
USED FOR
CONSTRUCTION**

NOTE:
1. CONTACTS OPERATE IN FAILSAFE MODE.

Reid Crowther Consulting Engineers		dp controls Ltd. Edgely, Alberta		JOB NO. 3153			
				FILENAME D2492			
		95.07.11	1	AS-BUILT	PL		
12.07.23	3	ISSUED FOR TENDER, BID OPP.490-2012	CJR	94.08.12	0	ISSUED FOR CONST.	PL
97.02.03	2	RCPL RECORD DRAWING	PS	94.07.19	A	ISSUED FOR APPROVAL	PL
DATE		REVISION	APP.	DATE		REVISION	APP.

THE CITY OF WINNIPEG
REGIONAL WATER SUPPLY SYSTEM
SUPERVISORY CONTROL AND DATA ACQUISITION

MacLEAN REGIONAL PUMPING STATION – MCP
TRANSFORMER #2 WINDING HIGH TEMP SWITCH

SCALE _____
DATE 94.07.19
DES PL DWN MJJ
CKD DN APP LK

DRAWING NO.
D-2492