


ELECTRICAL ROOM AIR HANDLING UNIT  
LOOP G682-AHU

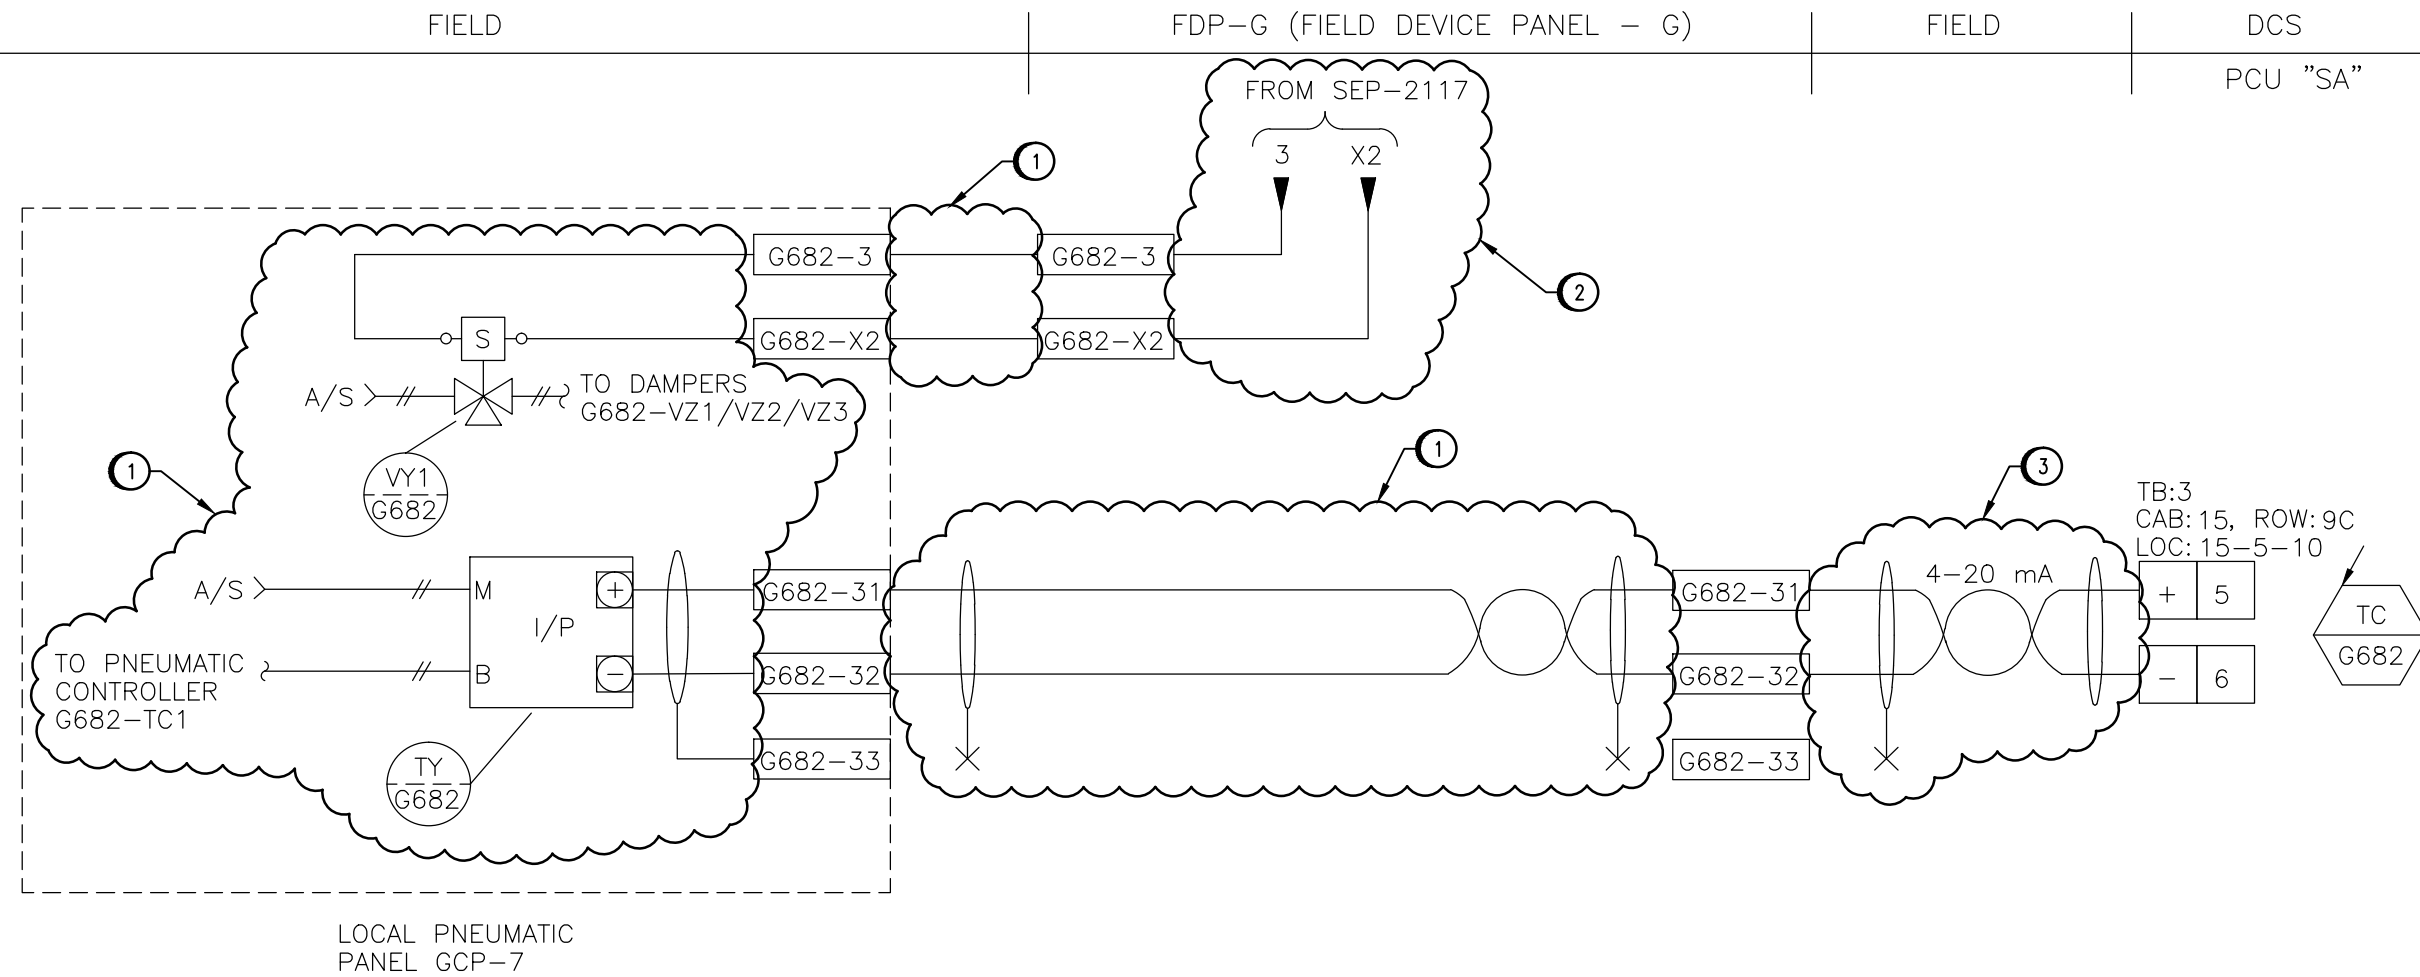

- 1
- 2
- 3 VY1, DAMPER OPEN E/P RELAY
- 4
- 5 TY, CURRENT TO PRESSURE CONVERTER
- 6 TC, SETPOINT OVERRIDE OUTPUT FROM DCS
- 7
- 8
- 9
- 10
- 11
- 12
- 13
- 14
- 15
- 16
- 17

CONSTRUCTION NOTES	
①	DISCONNECT AND REMOVE WIRING AND DEVICES.
②	DISCONNECT WIRING FROM TERMINALS AND REMOVE WIRING WITHOUT AFFECTING OTHER PANEL WIRING.
③	DISCONNECT WIRING FROM TERMINALS. MARK SPARE AND LOCATION OF OTHER END OF WIRE.



<b>MacLAREN ENGINEERS INC. WARDROP ENGINEERING INC. ENGINEERING CONSULTANTS</b>			
DESIGNED BY:	RH	DATE:	06/92
DRAWN BY:	RH	DATE:	06/92
SCALE:	N.T.S.	DATE:	06/92
2	REMOVED WIRING AND DEVICES	2012/09/10	TMC
1	AS CONSTRUCTED	12/93	B.T.
0	ISSUED FOR CONSTRUCTION	09/92	B.T.
-	ISSUED FOR REVIEW	07/92	B.T.
NO.	REVISIONS	DATE	BY

<b>SNC-LAVALIN INC.</b> 148 Nature Park Way Winnipeg, Manitoba Canada R3P 0X7				
DESIGNED:	T. CHURCH	APPROVED:	C. REIMER	
CHECKED:	C. REIMER	DATE:	2012/10/09	
PROJECT No.	SUBDIV.	SUBJECT	SERIAL	REV.
112577	0116	48 DD	0130	2

**THE CITY OF WINNIPEG**  
WORKS AND OPERATIONS DIVISION  
WATERWORKS, WASTE & DISPOSAL DEPARTMENT

SOUTH END WATER POLLUTION CONTROL CENTER	CITY DWG. NO.
PUMP & SCREEN BUILDING - I & C	
HVAC SYSTEM	SHEET 2 OF 2
ELECTRICAL ROOM AIR HANDLING UNIT	
LOOP G682	SEP-2118

CONSULTANT DWG. NO.  
870012-01-20