


NOTES

- STANDPIPES REQUIRED BETWEEN STA. 12+00 AND STA. 13+00.
- ALL MANHOLES TO BE TYPE "A-T" EXCEPT AS NOTED.
- ALL SEWER HOUSE SERVICES TO BE INSTALLED BELOW STREET WATERMAIN EXCEPT AS NOTED.
- ALL SEWER HOUSE SERVICES TO BE A MINIMUM OF 9' BURY AT THE PROPERTY LINE EXCEPT AS NOTED.
- ALL SEWERS TO BE EXTRA STRENGTH CONCRETE PIPE EXCEPT AS NOTED.
- STREET INTERSECTION DETAILS TO BE SHOWN ON SEPARATE SHEETS.
- RADIUS EXCEPT AS NOTED.
- LOCATION AND DEPTH OF EXISTING UNDERGROUND SERVICES AS SHOWN ON DRAWINGS IS APPROXIMATE ONLY. CONTRACTOR SHALL NOTIFY THE RESPECTIVE UTILITIES BEFORE BEGINNING EXCAVATION.
- BENCH MARK:

LEGEND

PLAN	PROFILE
WASTEWATER SEWER	EXIST. NORTH OR EAST DITCH
CULVERT	EXIST. NORTH OR WEST DITCH
EXIST. GAS LINE	EXIST. SOUTH OR WEST DITCH
EXIST. MTS. DUCT	EXIST. GUTTER GRADE
	EXIST. SIDEWALK GRADE
	DITCH GRADE

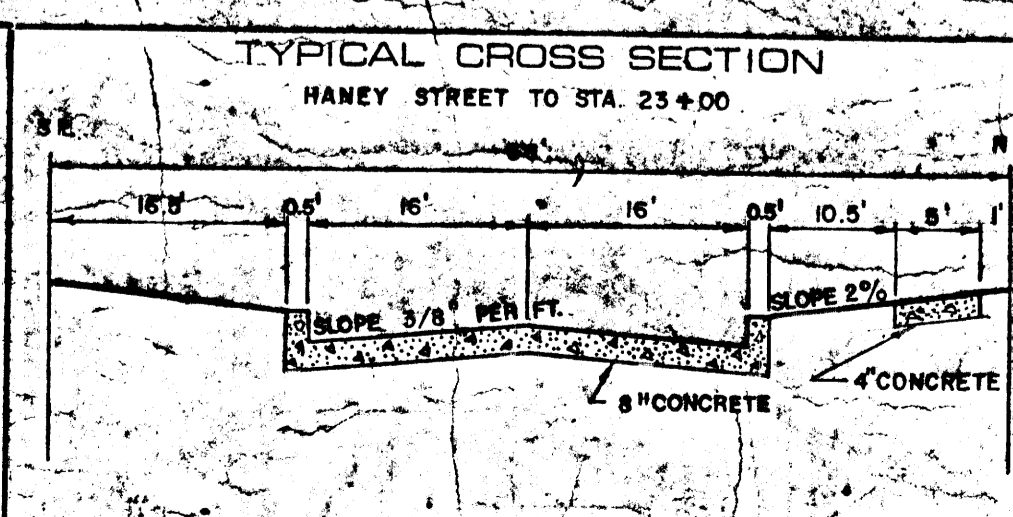

REVISIONS

NO.	REVISION	DATE	BY
1	GENERAL REVISION	4 NOV 79	BR
2	REVISED 60" SEWER GRADE	JUNE 16/78	BR
3	REVISED 48" L.G. WEST FROM HANEY ST.	APRIL 14/78	BR
4	REVISED 12" WATER TO SEWER TO AS BUILT	MAY 14/76	BR
5	REVISED ROW TO LEGAL PLAN 12-227	DEC 4/75	BR
6	REVISED LAND DRAINAGE SEWER TO AS BUILT	30 JAN 74	BR

THE CITY OF WINNIPEG
OPERATIONS DIVISION - DISTRICT 6
LOCATION AND GRADE OF SERVICES ON
ELDRIDGE AVENUE
STA. 12+00W TO STA. 23+00W

TEMPLETON ENGINEERING COMPANY
PROFESSIONAL ENGINEERS

WINNIPEG

DRAWN BY: B.H.F. CHECKED BY: [Signature] APPROVED BY: [Signature]

DATE: AUGUST 23, 1974 SCALE: HOR. 1" = 40' VERT. AS SHOWN

PROJECT NO. 10315-2004-60-15
LEGAL PLAN NO. 12-227

PROF. ENG. REG. NO. 1124
1150

8-223

20 * LD10560 LD-1442