


SOUTH CABINET
SCALE: 1 : 2

CONSTRUCTION NOTES
1. REMOVE FAIL LIGHT AND INSTALL PLUG IN PANEL HOLE.

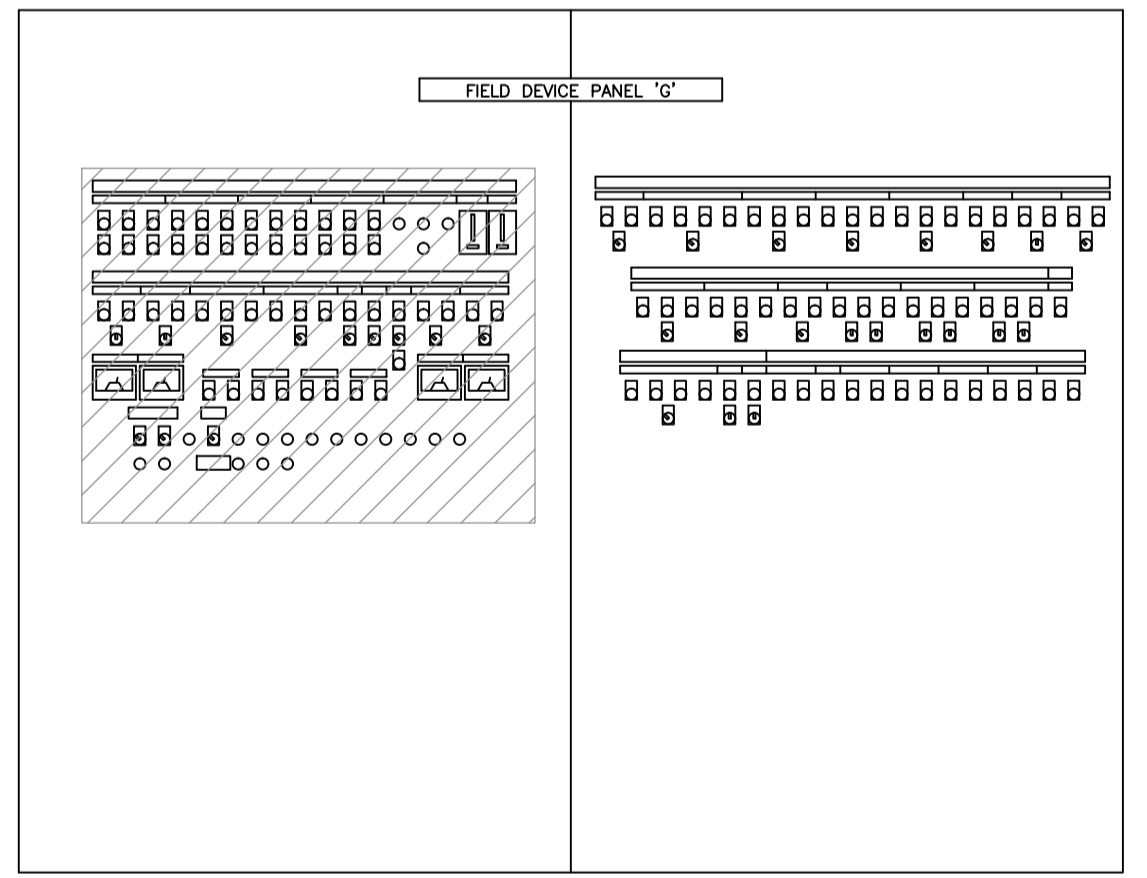

KEY PLAN
SCALE: 1:20

NOTES:
1. THIS DRAWING SUPERCEDES PART OF SEP-840.



NO.	REVISIONS	DATE	DESIGN	CHECK
02	REMOVED G260-CON FAIL LIGHT	2012/02/24	TMC	CJR
01	AS-BUILT, BID OPP. 759-2010	2011/11/01	-	TMC
00	ISSUED FOR TENDER	2010/10/01	TMC	CJR

		SNC-LAVALIN INC. 148 Nature Park Way Winnipeg, MB, Canada R3P 0X7 204-786-8080	
DESIGNED BY:	T. CHURCH	CHECKED BY:	C. REIMER
DRAWN BY:	S. COATES	APPROVED BY:	C. REIMER
SCALE:	1:2	RELEASED FOR CONSTRUCTION BY:	J. VEILLEUX
DATE:	2010/03/25	DATE:	2010/10/01
CONSULTANT NO.:	112577-0112-480D-0301		

ENGINEER'S SEAL
ORIGINAL DRAWING SEALED BY:
T. M. CHURCH
SNC-LAVALIN
MEMBER # 32682
2012/02/27
REV. 02

THE CITY OF WINNIPEG
WATER AND WASTE DEPARTMENT

SOUTH END WATER POLLUTION CONTROL CENTRE
HEADWORKS UPGRADES
PANEL LAYOUT
FDP-G FRONT VIEW

CITY DRAWING NUMBER: 1-0102G-A0085
SHEET: 001
REV: 02
SIZE: A1