


DISCHARGE CHANNEL HIGH LEVEL LOOP G202

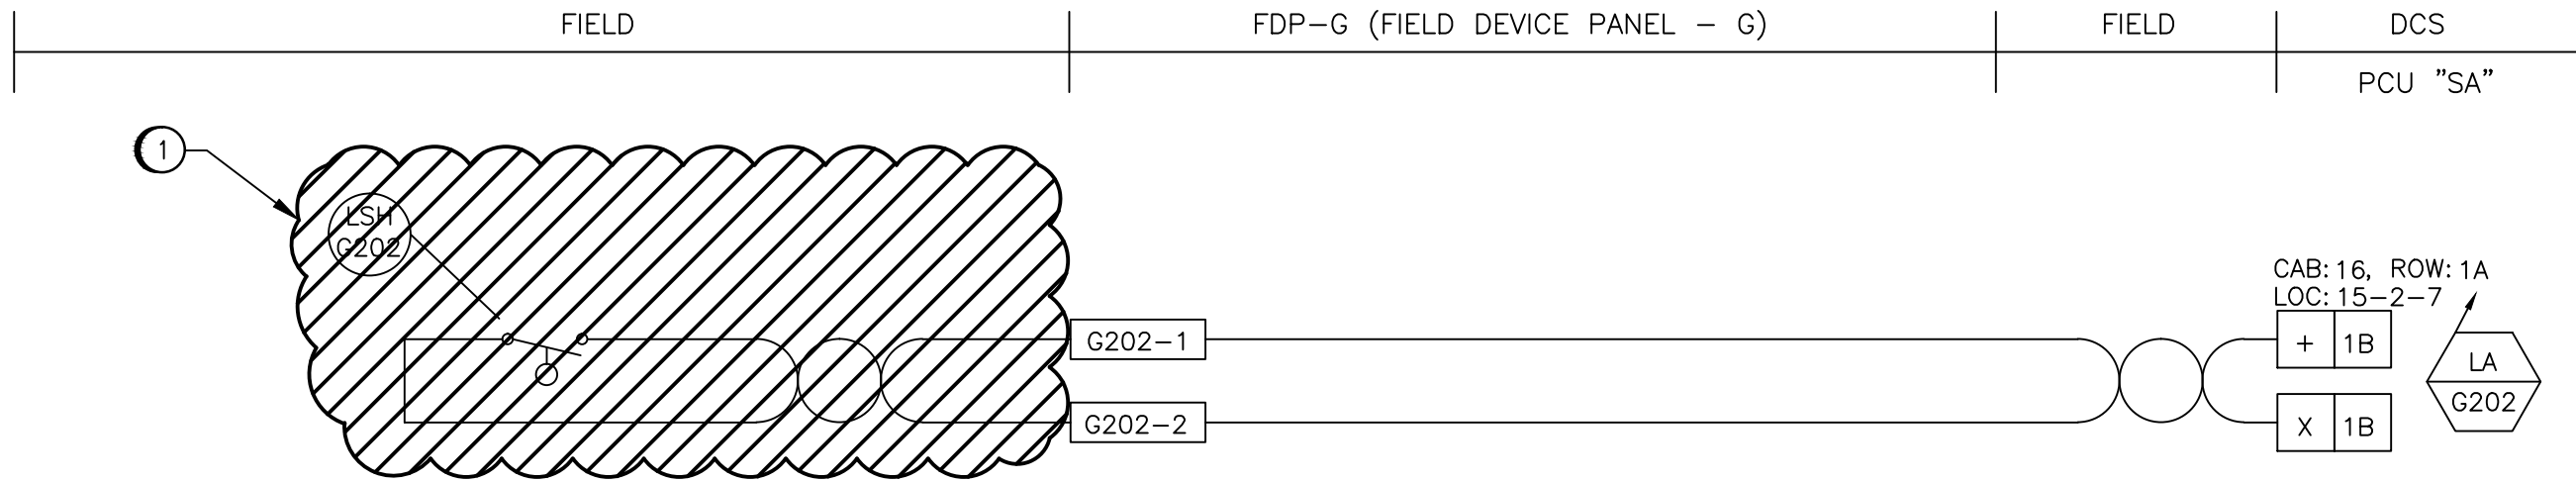

- 1
- 2 LSH, HIGH LEVEL SWITCH
- 3 LA, HIGH LEVEL ALARM TO DCS
- 4
- 5
CONSTRUCTION NOTES

① REMOVE EXISTING LEVEL SWITCH, WIRING AND CONDUIT. REPLACE WITH I.S. PROTECTED SWITCH. SEE DRAWING 1-0102G-A0043.



SNC-LAVALIN INC. 148 Nature Park Way Winnipeg, Manitoba Canada R3P 0X7				
DESIGNED: T. CHURCH		APPROVED: C. REIMER		
CHECKED: C. REIMER		DATE: 2012/02/16		
PROJECT No.	SUBDIV.	SUBJECT	SERIAL	REV.
112577	0113	47 DD	2228	2

MacLAREN ENGINEERS INC. WARDROP ENGINEERING INC. ENGINEERING CONSULTANTS			
DESIGNED BY:	RH	DATE:	06/92
DRAWN BY:	RH	DATE:	06/92
SCALE:	N.T.S.	DATE:	06/92
NO. REVISIONS	DATE	BY	DATE
2	REMOVED LEVEL SWITCH	2012/02/09	TMC
1	AS CONSTRUCTED	12/93	B.T.
0	ISSUED FOR CONSTRUCTION	09/92	B.T.
-	ISSUED FOR REVIEW	07/92	B.T.

ORIGINAL DRAWING SEALED BY:
T. M. CHURCH
SNC-LAVALIN
MEMBER # 32682
2012/02/15
REV. 02
CHANGES ONLY

CONSULTANT DWG. NO.
870012-01-20

THE CITY OF WINNIPEG WORKS AND OPERATIONS DIVISION WATERWORKS, WASTE & DISPOSAL DEPARTMENT	
SOUTH END WATER POLLUTION CONTROL CENTER	CITY DWG. NO.
PUMP & SCREEN BUILDING - I & C	SHEET 1 OF 1
GRIT REMOVAL SYSTEM	
DISCHARGE CHANNEL HIGH LEVEL LOOP G202	SEP-2033