



METRIC NOTES
WHOLE NUMBERS IND. MILLIMETRES
DECIMALIZED EXPRESSIONS IND. METRES

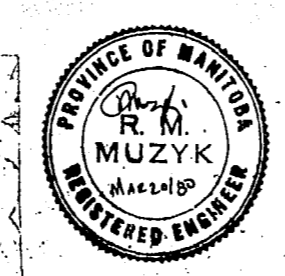

NO.	REVISIONS	DATE	APP.
3	RECORD CHANGES	NOV 20 1980	EEL
2	CONST. RECORD CHANGES	AUG 18 1980	EEL
1	ADDENDUM NO. 1	23 APR 77	EE

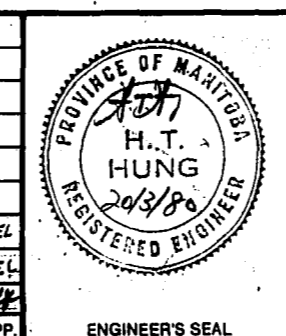

Underwood McLellan Ltd.
Consulting Engineers and Planners

DESIGNED BY: H.T.H. DRAWN BY: G.S.H.

CHECKED BY: DATE: MARCH 20, 1980

APPROVED BY: DATE: 20/3/80

THE CITY OF WINNIPEG
WORKS & OPERATIONS DEPARTMENT

WILKES AVENUE RESERVOIR RECONSTRUCTION
RESERVOIR FLOOR PLAN

RELEASED FOR CONSTRUCTION: DATE: 20/03/80

SCALE: AS NOTED DRAWING NO: WIL-16

RECORD DRAWING