


RESERVOIR PLAN

MICROFILMED JUN 1982
RECORD DRAWING

METRIC NOTES
 WHOLE NUMBERS IND. MILLIMETRES
 DECIMALIZED EXPRESSIONS IND. METRES

NO.	REVISIONS	DATE	APP.
2	RECORD DRAWING	NOV 20 1981	EEL
1	CONSTRUCTION RECORD CHANGES	MAR 20 1980	EEL

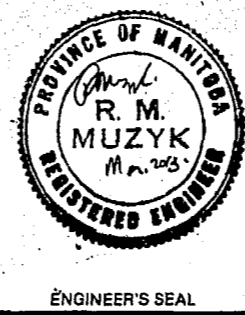

Underwood McLellan Ltd.
 Consulting Engineers and Planners

DESIGNED BY: R.M.M. DRAWN BY: R.B.T.
 CHECKED BY: DATE: MARCH 20, 1980
 APPROVED BY: DATE: 20/3/80

THE CITY OF WINNIPEG
 WORKS & OPERATIONS DEPARTMENT
WATERWORKS, WASTE & DISPOSAL DIVISION

WILKES AVENUE RESERVOIR RECONSTRUCTION
 GENERAL ARRANGEMENT

RELEASED FOR CONSTRUCTION: DATE: 20/03/80
 SCALE: 1:500
 DRAWING NO: **WIL-3**