


SECTION 1
4/3

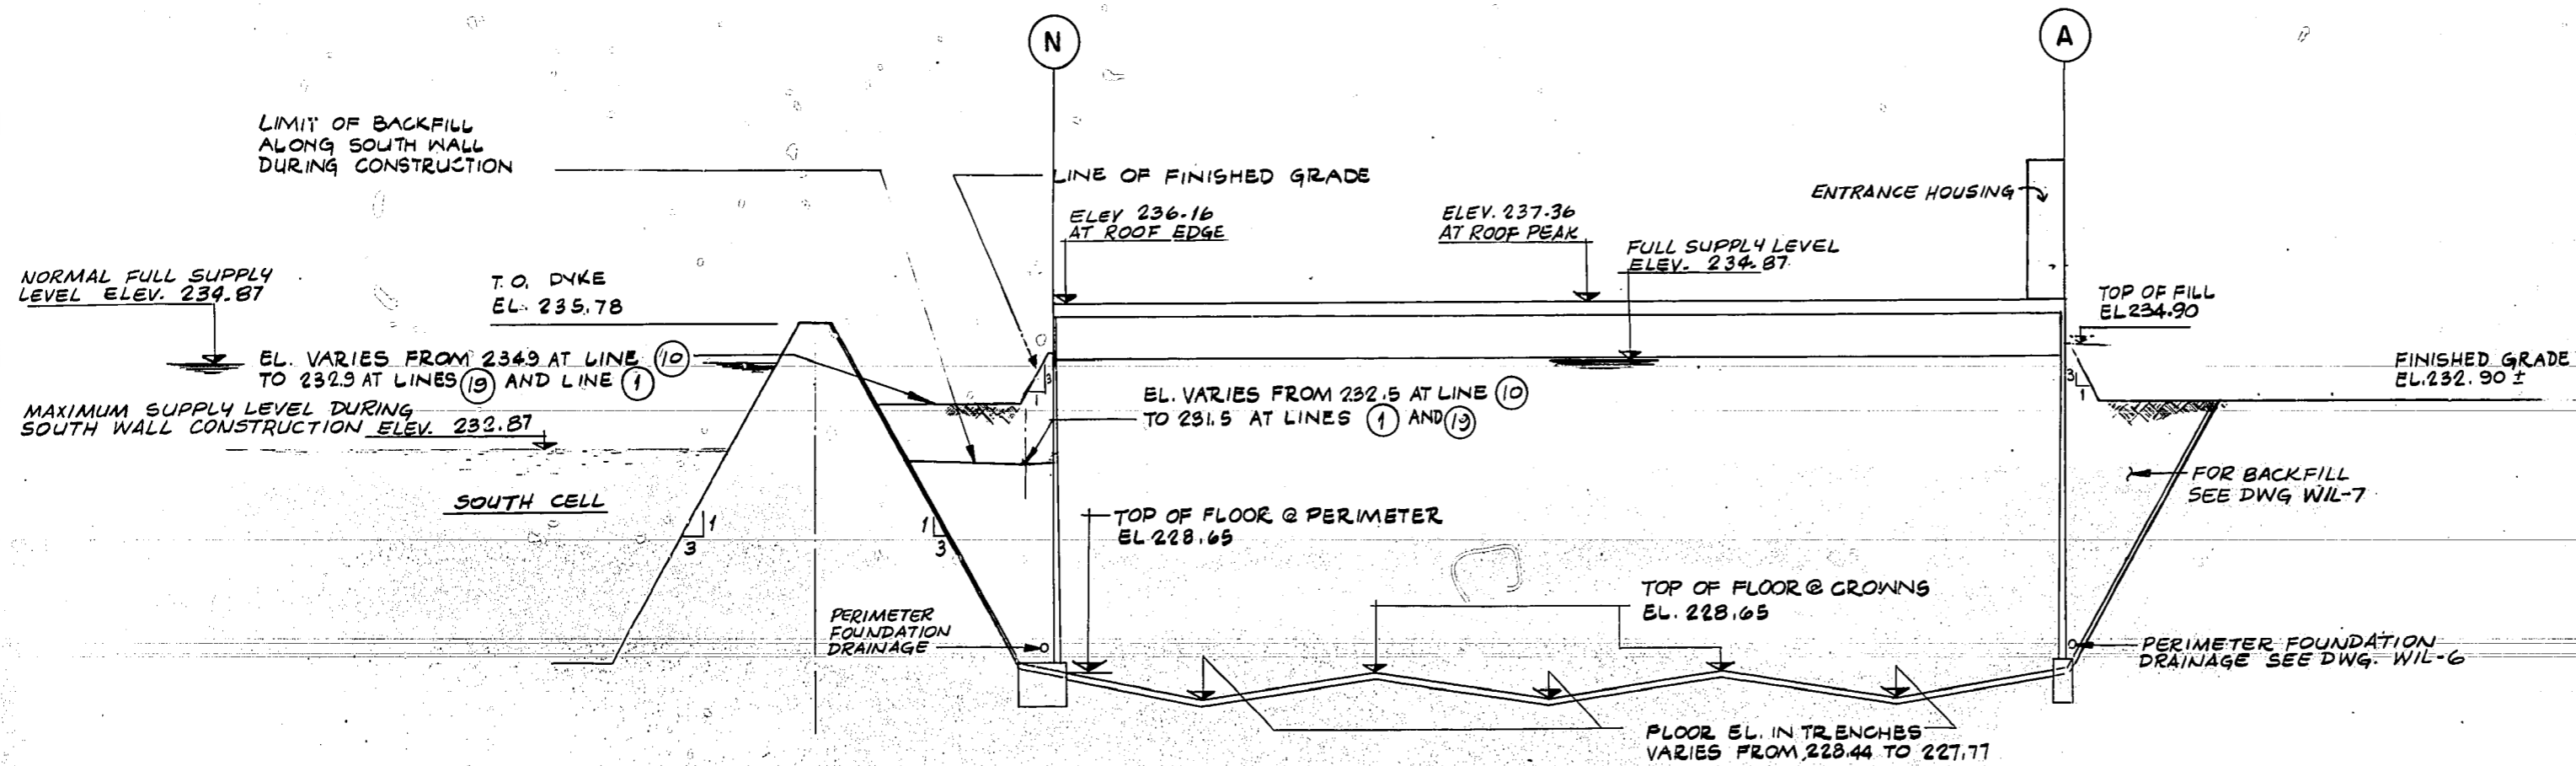

SECTION 2
4/3

MICROFILMED

RECORD DRAWING

METRIC NOTES
WHOLE NUMBERS IND. MILLIMETRES
DECIMALIZED EXPRESSIONS IND. METRES

NO.	REVISIONS	DATE	APP.
2	RECORD DRWG.	NOV/80	FEEL
1	CONST. RECORD CHANGES	AUG/80	FEEL



Underwood McLellan Ltd.
Consulting Engineers and Planners

DESIGNED BY: R.M.M. DRAWN BY: R.B.T.
CHECKED BY: DATE: MARCH 20, 1980
APPROVED BY: DATE: 20/3/80

THE CITY OF WINNIPEG
WORKS & OPERATIONS DEPARTMENT
WATERWORKS, WASTE & DISPOSAL DIVISION

WILKES AVENUE RESERVOIR RECONSTRUCTION
GENERAL SECTIONS

RELEASED FOR CONSTRUCTION: DATE: 20/03/80
SCALE: 1:500 HORZ. 1:100 VERT.
DRAWING NO: WIL-4 REV 2