


WET WELL EMERGENCY EXHAUST FAN
LOOP G686-EF

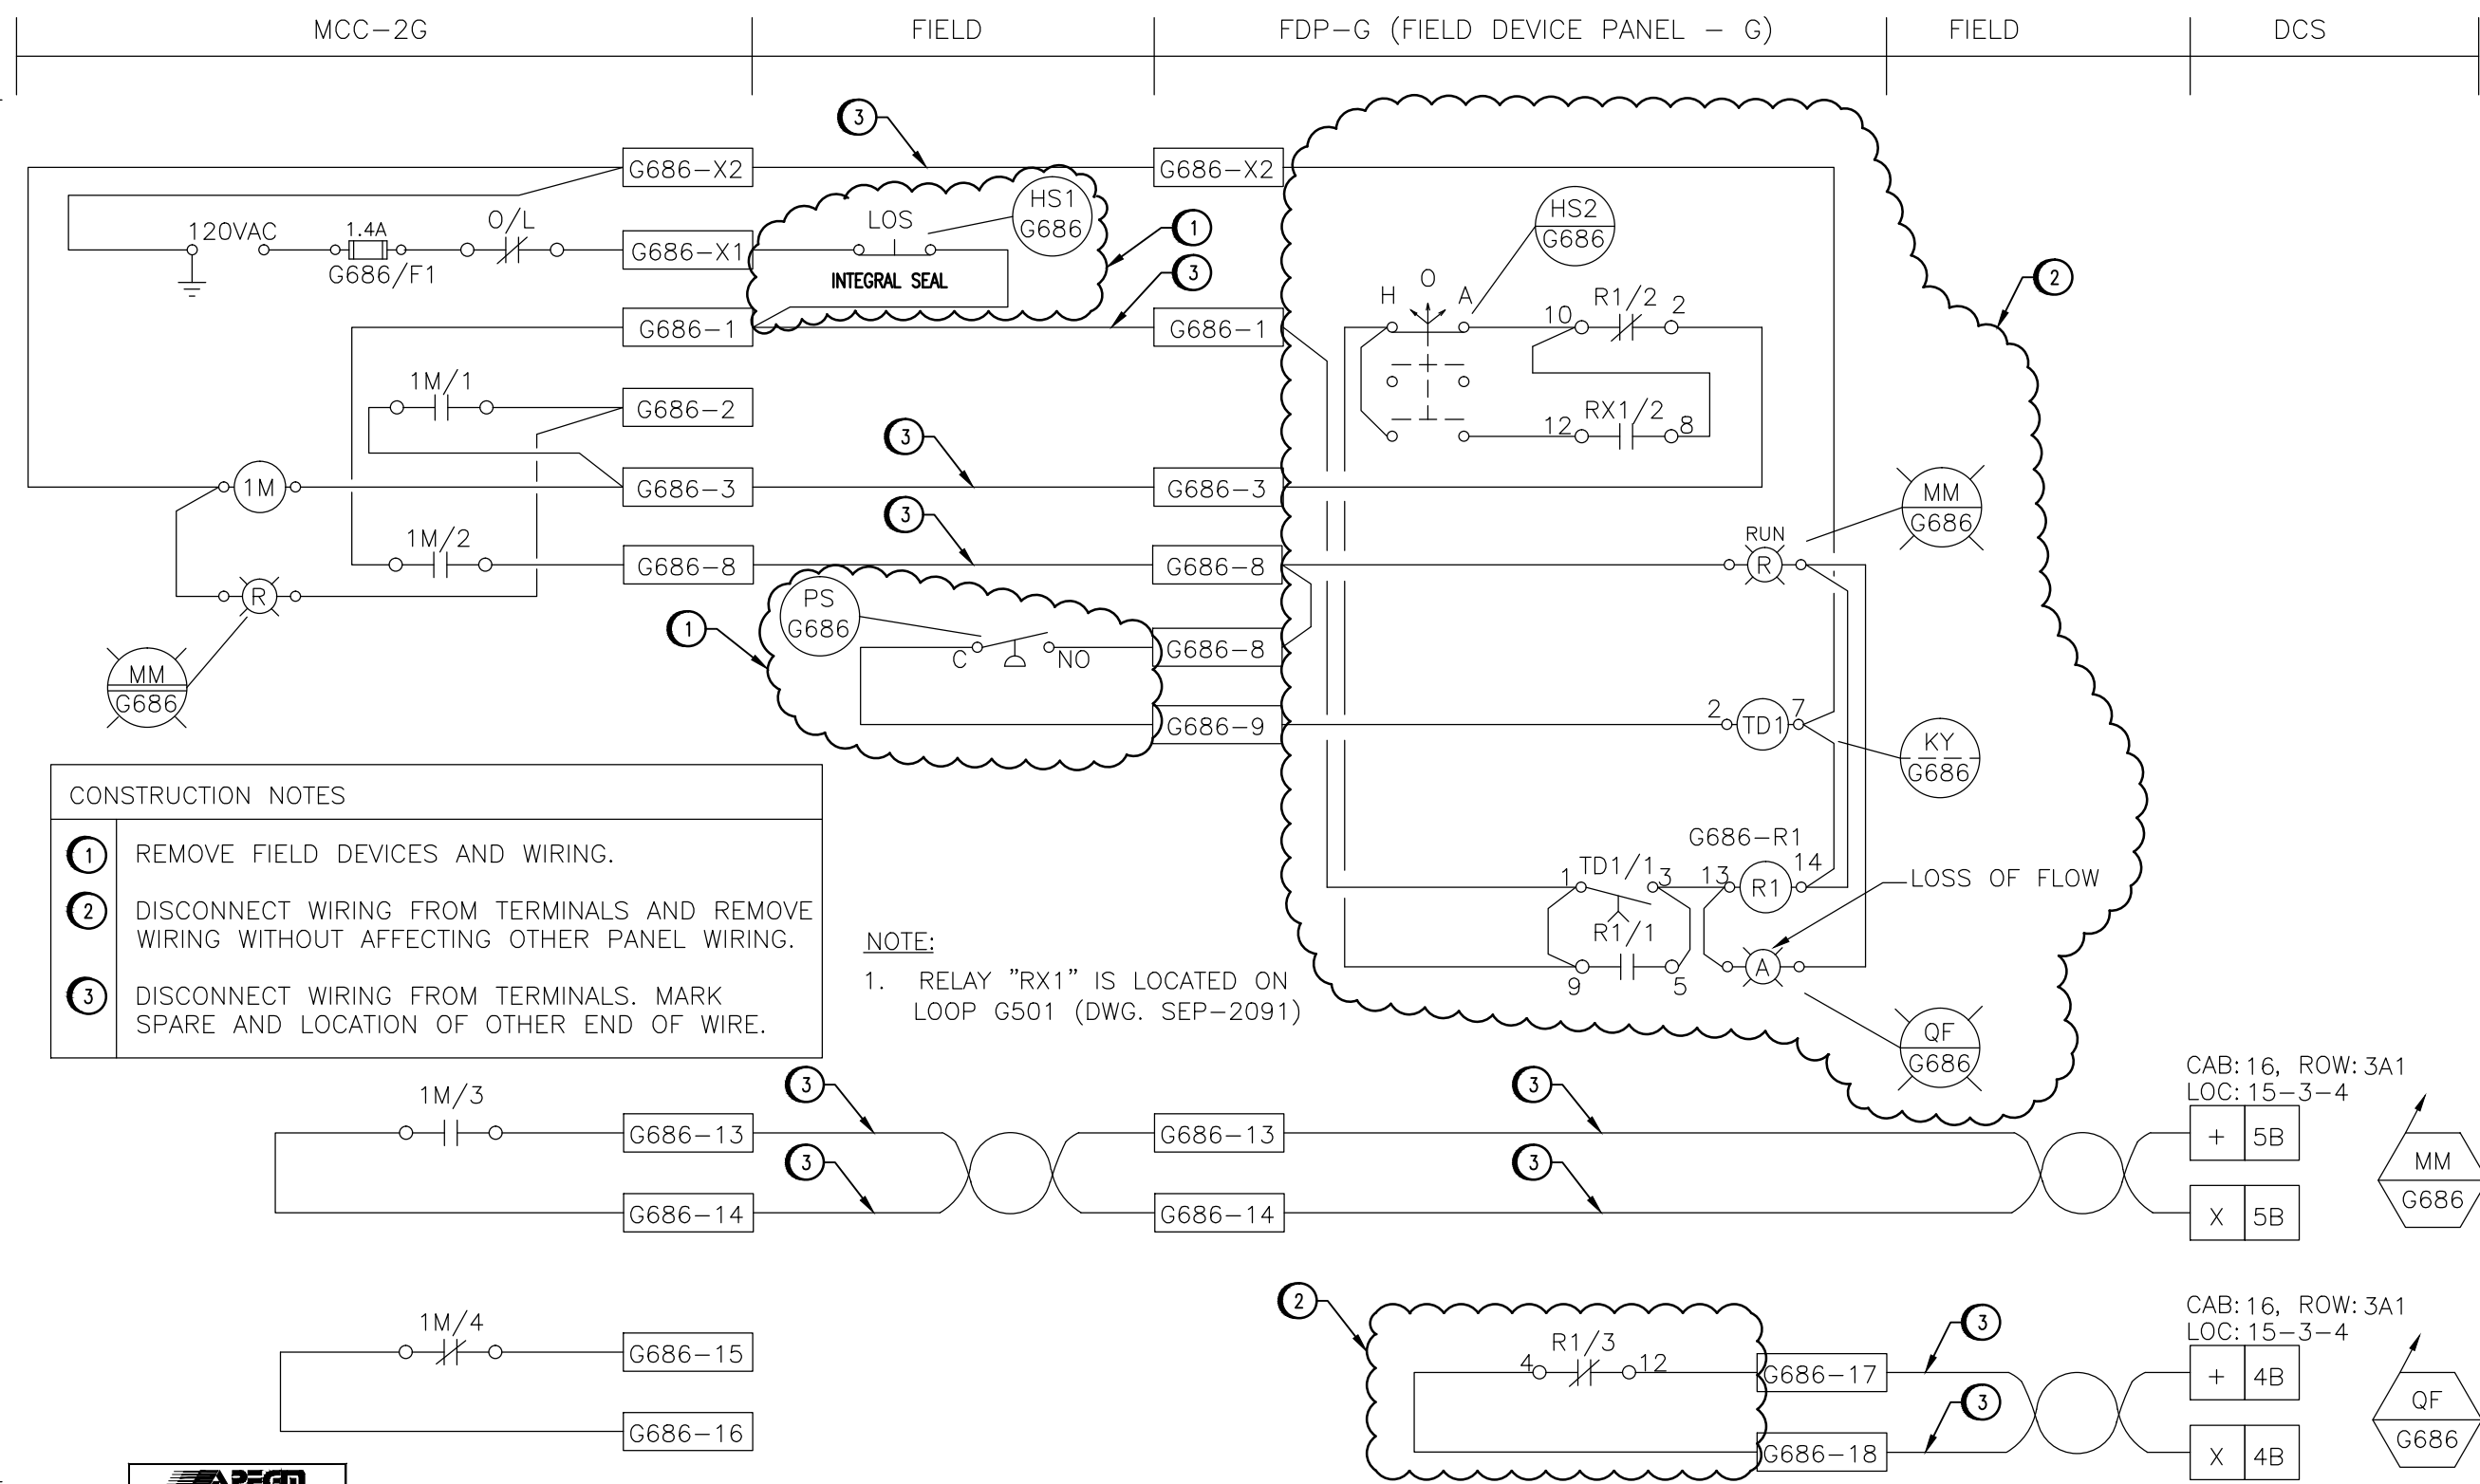

- 1
- 2 HS1, LOCK/OFF/STOP PUSHBUTTON
- 3 HS2, HAND/OFF/AUTO SELECTOR SWITCH
- 4
- 5
- 6 MM, RUN INDICATION PILOT LIGHT
- 7 PS, DIFFERENTIAL PRESSURE SWITCH
- 8 KY, TIME DELAY FAIL RELAY
- 9
- 10 R1, LOSS OF FLOW ALARM RELAY
- 11 QF, LOSS OF FLOW PILOT LIGHT
- 12
- 13 MM, RUN INPUT TO DCS
- 14
- 15
- 16 QF, COMMON FAIL TO DCS
- 17

CONSTRUCTION NOTES

- ① REMOVE FIELD DEVICES AND WIRING.
- ② DISCONNECT WIRING FROM TERMINALS AND REMOVE WIRING WITHOUT AFFECTING OTHER PANEL WIRING.
- ③ DISCONNECT WIRING FROM TERMINALS. MARK SPARE AND LOCATION OF OTHER END OF WIRE.

NOTE:
1. RELAY "RX1" IS LOCATED ON LOOP G501 (DWG. SEP-2091)



SNC-LAVALIN				
SNC-LAVALIN INC. 148 Nature Park Way Winnipeg, Manitoba Canada R3P 0X7				
DESIGNED: T. CHURCH	APPROVED: C. REIMER			
CHECKED: C. REIMER	DATE: 2012/10/09			
PROJECT No.	SUBDIV.	SUBJECT	SERIAL	REV.
112577	0113	47 DD	2220	2

MacLAREN ENGINEERS INC. WARDROP ENGINEERING INC. ENGINEERING CONSULTANTS			
2	REMOVED WIRING AND DEVICES	2012/09/10	TMC
1	AS CONSTRUCTED	12/93	B.T.
0	ISSUED FOR CONSTRUCTION	09/92	B.T.
-	ISSUED FOR REVIEW	07/92	B.T.
NO REVISIONS		DATE	BY
		DATE: 06/92	

DESIGNED BY:	RH
DRAWN BY:	RH
SCALE:	N.T.S.
CONSULTANT DWG. NO.	870012-01-20

THE CITY OF WINNIPEG
WORKS AND OPERATIONS DIVISION
WATERWORKS, WASTE & DISPOSAL DEPARTMENT

SOUTH END WATER POLLUTION CONTROL CENTER	CITY DWG. NO.
PUMP & SCREEN BUILDING - I & C	SHEET 1 OF 1
HVAC SYSTEMS	
WET WELL EMERGENCY EXHAUST FAN LOOP G686	SEP-2124