
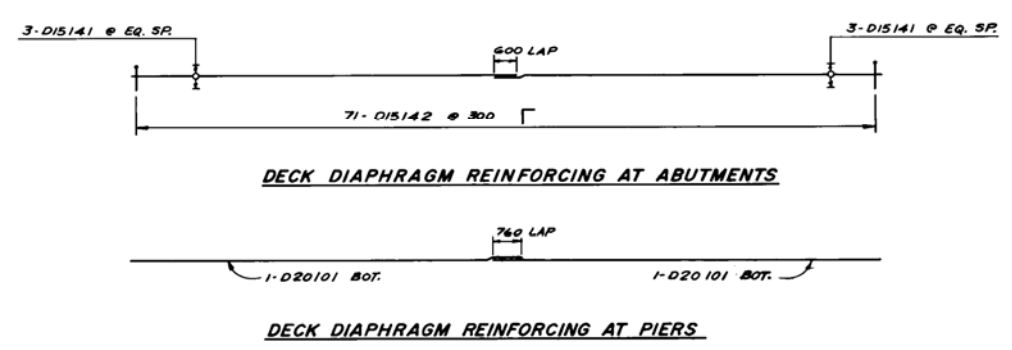


NORTH STRUCTURE DECK PLAN

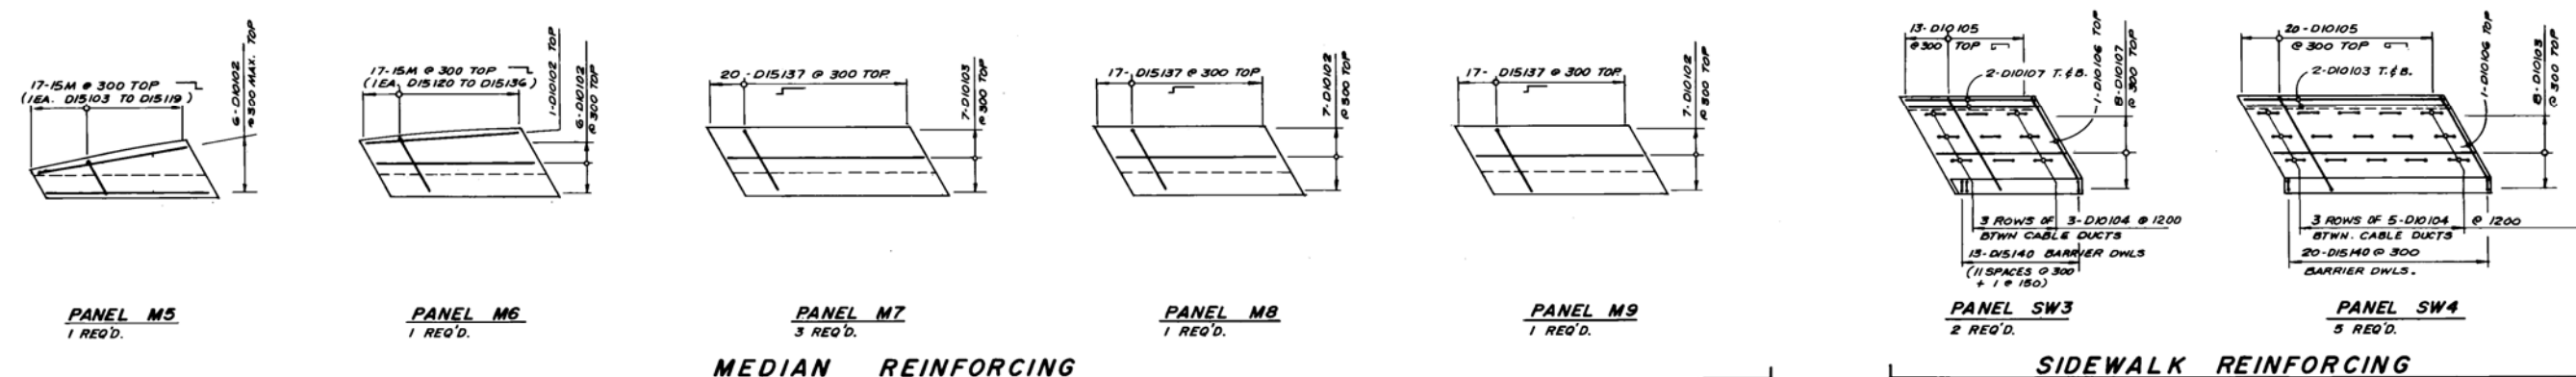

AS BUILT
APPROVED BY: *R. White*

NOTE
ALL REBAR SHOWN ON THIS DRAWING SHALL BE EPOXY COATED.

		THE CITY OF WINNIPEG WORKS & OPERATIONS		STURGEON CREEK BRIDGE ON PORTAGE AVENUE NORTH STRUCTURE DECK PLAN CONCRETE & REINFORCEMENT	
DESIGNED BY:	F.A.K.	DRAWN BY:	W.P.S.	B-5428 AUTHORIZED BY: <i>[Signature]</i> DATE: 80-08-25 ACCEPTED BY: <i>[Signature]</i> DATE: <i>[Signature]</i>	
CHECKED BY:	L.D.M.	DATE:	80-08-25	SCALE: 1:100 DRAWING NO: B178-80-42	
APPROVED BY:	<i>[Signature]</i>		DATE:	23/9/80	
NO.	REVISIONS	DATE	APP.	PROJ. NO. M.M.D. 7580-02 NS-13	