



11. PLAN - POOL DECK AND TANK FLOOR
SCALE 1/8" = 1'-0"

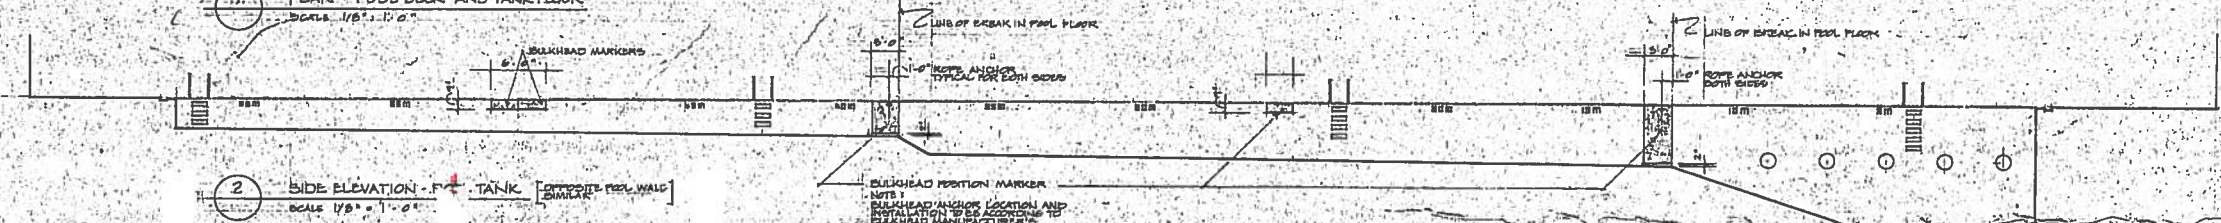


2. SIDE ELEVATION - F. TANK [OPPOSITE POOL WALL]
SCALE 1/8" = 1'-0"

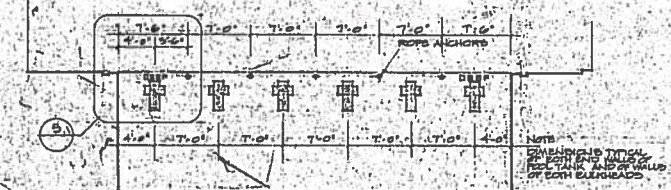

3. DEEP END WALL ELEVATION
SCALE 1/8" = 1'-0"



4. SHALLOW END WALL ELEVATION
SCALE 1/8" = 1'-0"

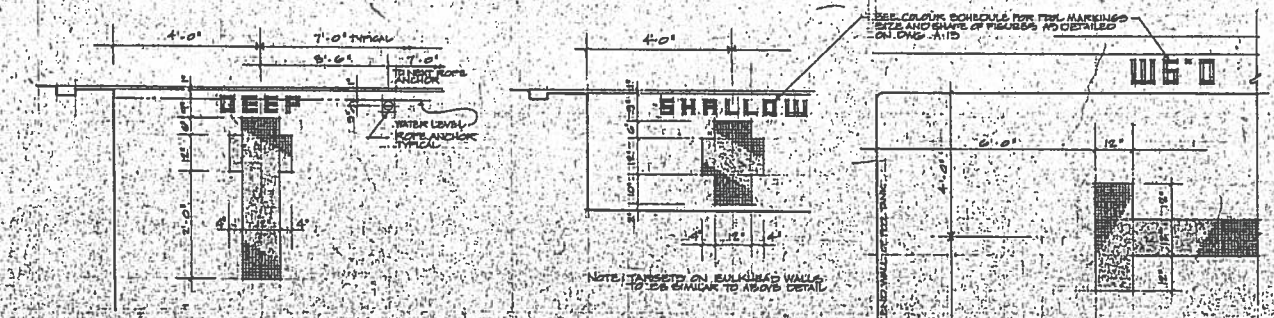

5. DETAIL - DEEP END LANE TARGET
SCALE 1/2" = 1'-0"

6. SHALLOW END LANE TARGET
SCALE 1/2" = 1'-0"

7. TYPICAL LANE MARKER
SCALE 1/2" = 1'-0"

NOTE:
THIS DRAWING IS ISSUED TO CLARIFY THE FOLLOWING:
LOCATE THE SPECIFIED BACKSTROKES (B.S.) AND PAIR BRUSH (P.B.) ROPE ANCHORS
RELOCATE LIFE GUARD CHAIRS
RELOCATE LANE MARKERS AND TARGETS, DISTANCE MARKERS AND DEPTH MARKERS
LOCATE BULKHEAD POSITION MARKERS
RELOCATE ROPE ANCHORS IN SIDE OF POOL TALK @ 2' BREAK IN POOL FLOOR SLOPE

SCALE	AS BUILT DRAWING
DATE	1/1/17
REVISION	
DATE	
REVISION	

NUMBER TEN ARCHITECTURAL GROUP
ARCHITECTS ENGINEERS PLANNERS
930 DUNDAS STREET NORTH WINNIPEG CANADA (204) 584 8841

ASSOCIATE ARCHITECT

CONSULTING ENGINEER

ARCH. SEAL

PROJECT
INDOOR SWIMMING POOL
FOR
THE CITY OF WINNIPEG
WINNIPEG, MANITOBA

SHEET TITLE
POOL DECK AND POOL TANK
CLARIFICATION DRAWING
SCALE: 1/8" = 1'-0"

DRAWN BY	DATE	SHEET NO.
WAC	JULY 2016	1/1
APPROVED BY	PROJECT NO.	FILE NO.
	1516	