


NOTE: FOR DETAILS & LOCATION OF SIM & BM DIVING PLATFORM SEE SHEET NO A-16

NOTE FOR FURTHER INFORMATION ON DECK EQUIPMENT LOCATIONS SEE SH1-A-3 MAIN FLOOR PLAN

JAN. 31/78	KL	AS BUILT DRAWING
DATE	DR	REVISION
THIS DRAWING MUST NOT BE SCALED.		
THE GENERAL CONTRACTOR SHALL VERIFY ALL DIMENSIONS, DATUMS AND LEVELS PRIOR TO COMMENCEMENT OF WORK. ALL ERRORS AND OMISSIONS TO BE REPORTED IMMEDIATELY TO THE ARCHITECT.		
VARIATIONS & MODIFICATIONS TO WORK SHOWN ON THESE DRAWINGS SHALL NOT BE CARRIED OUT WITHOUT WRITTEN PERMISSION FROM THE ARCHITECT.		
THIS DRAWING IS THE EXCLUSIVE PROPERTY OF THE ARCHITECTS AND CAN BE REPRODUCED ONLY WITH THE PERMISSION OF THE ARCHITECTS. IN WHICH CASE THE REPRODUCTION MUST BEAR THEIR NAME AS ARCHITECTS.		

**NUMBER TEN ARCHITECTURAL GROUP**  
 ARCHITECTS ENGINEERS PLANNERS  
 10 DONALD STREET NORTH WINNIPEG CANADA (204) 942 0981

ASSOCIATE ARCHITECT  
 CONSULTING ENGINEER

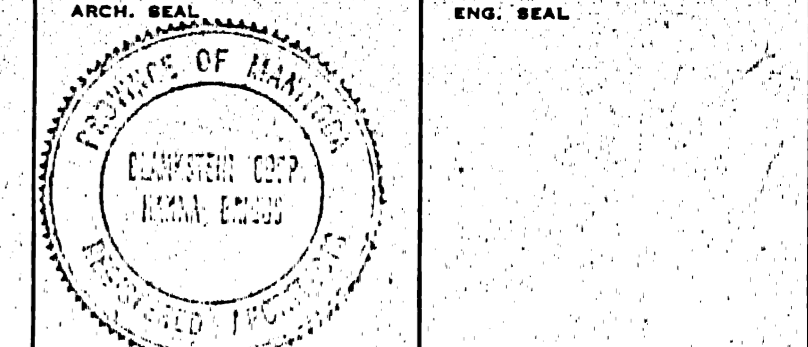

PROJECT  
**INDOOR SWIMMING POOL**  
 FOR  
**THE CITY OF WINNIPEG**  
 WINNIPEG MANITOBA

SHEET TITLE  
**POOL PLAN AND DETAILS**

DRAWN BY R.L.	DATE OCT-17-75	SHEET NO. A-12
CHECKED BY D.	PROJECT NO. 7508	FILE NO.

SCALE: 1/4" = 1'-0"