




**PLAN**  
SCALE: 1:200

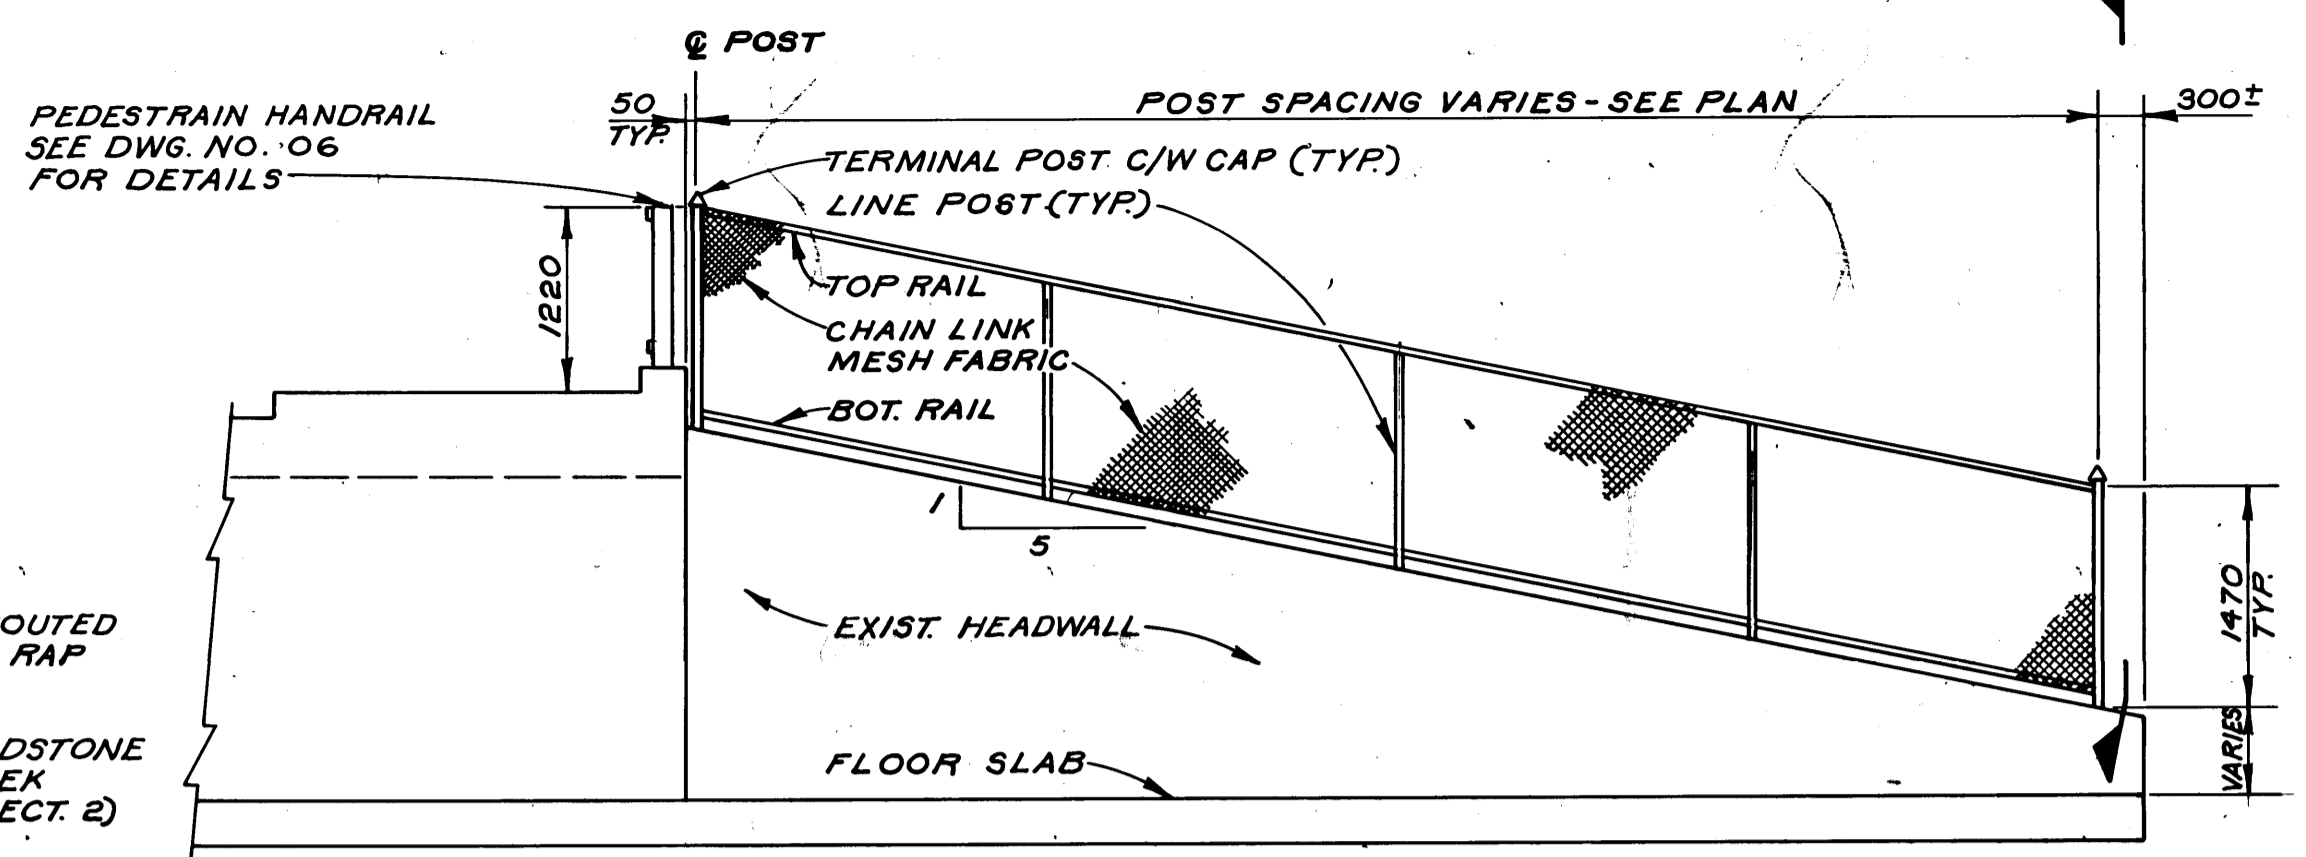


**ELEVATION - SHOWING CHAIN LINK FENCE**  
SCALE: 1:50

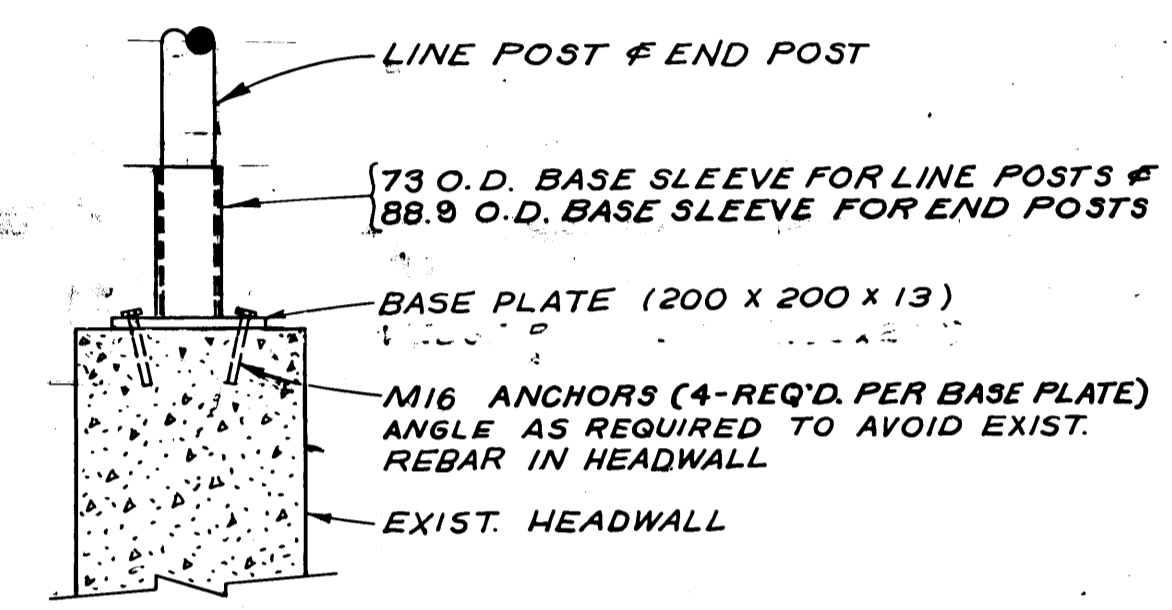


**SECTION 1**  
SCALE: 1:10

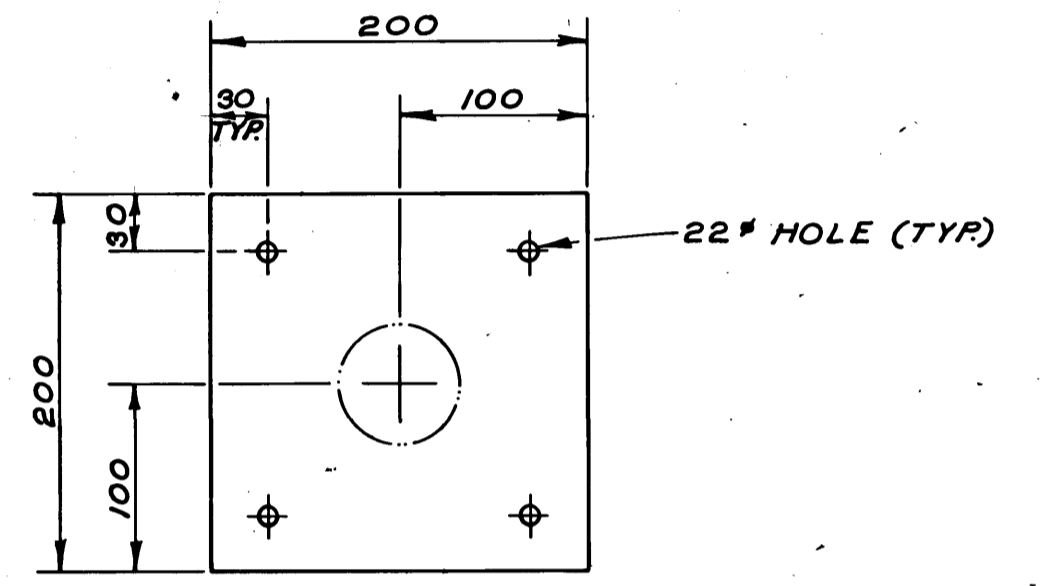


**BASE PLATE DETAIL**  
SCALE: 1:40

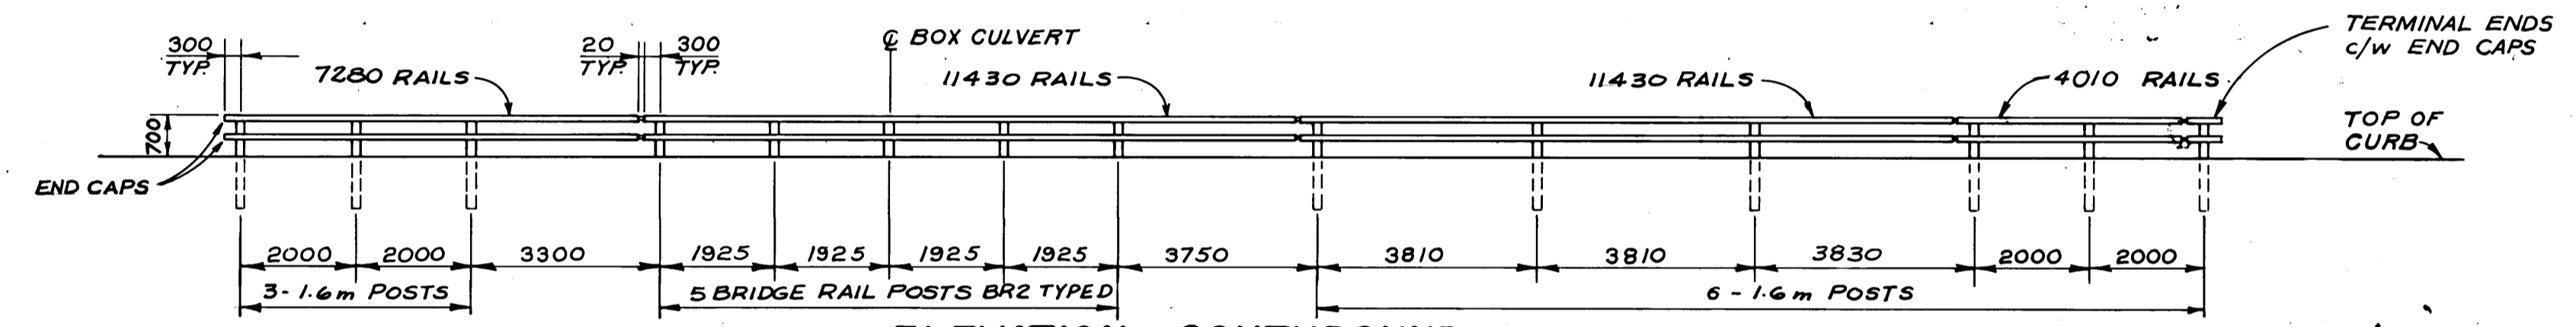


**ELEVATION - SOUTHBOUND (LOOKING WEST)**  
SCALE: 1:100

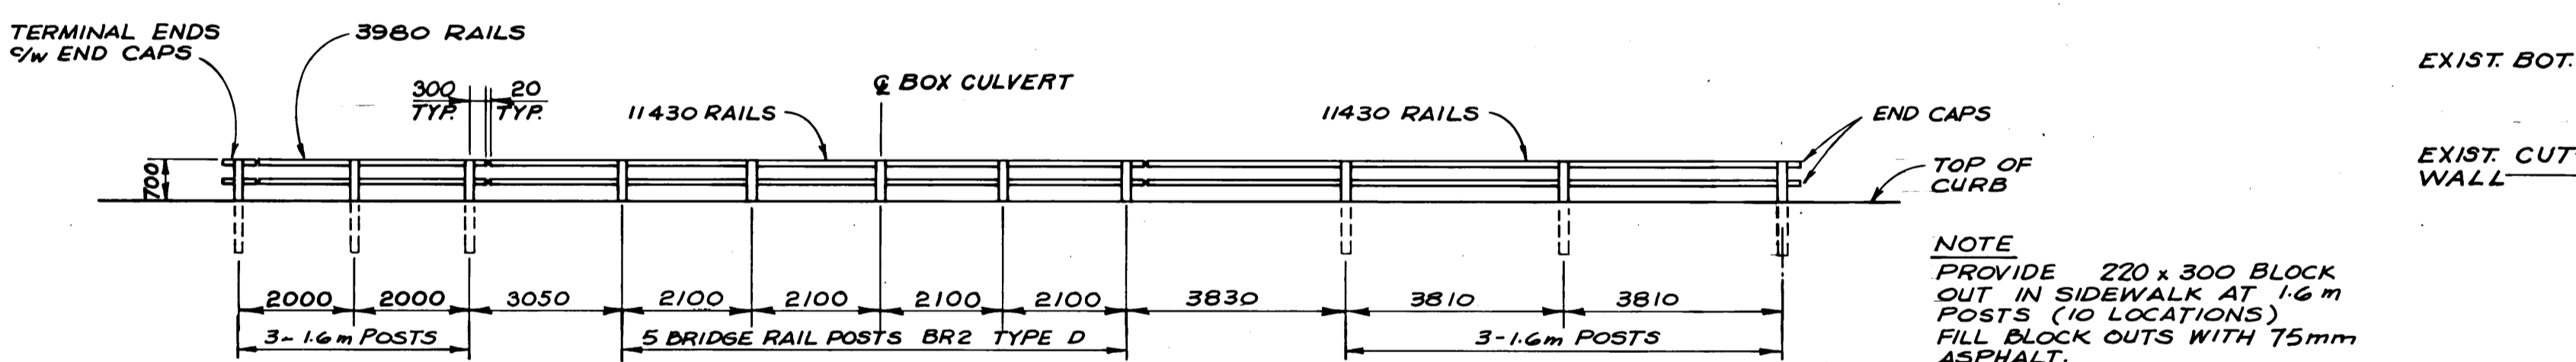

**ELEVATION - NORTHBOUND (LOOKING WEST)**  
SCALE: 1:100

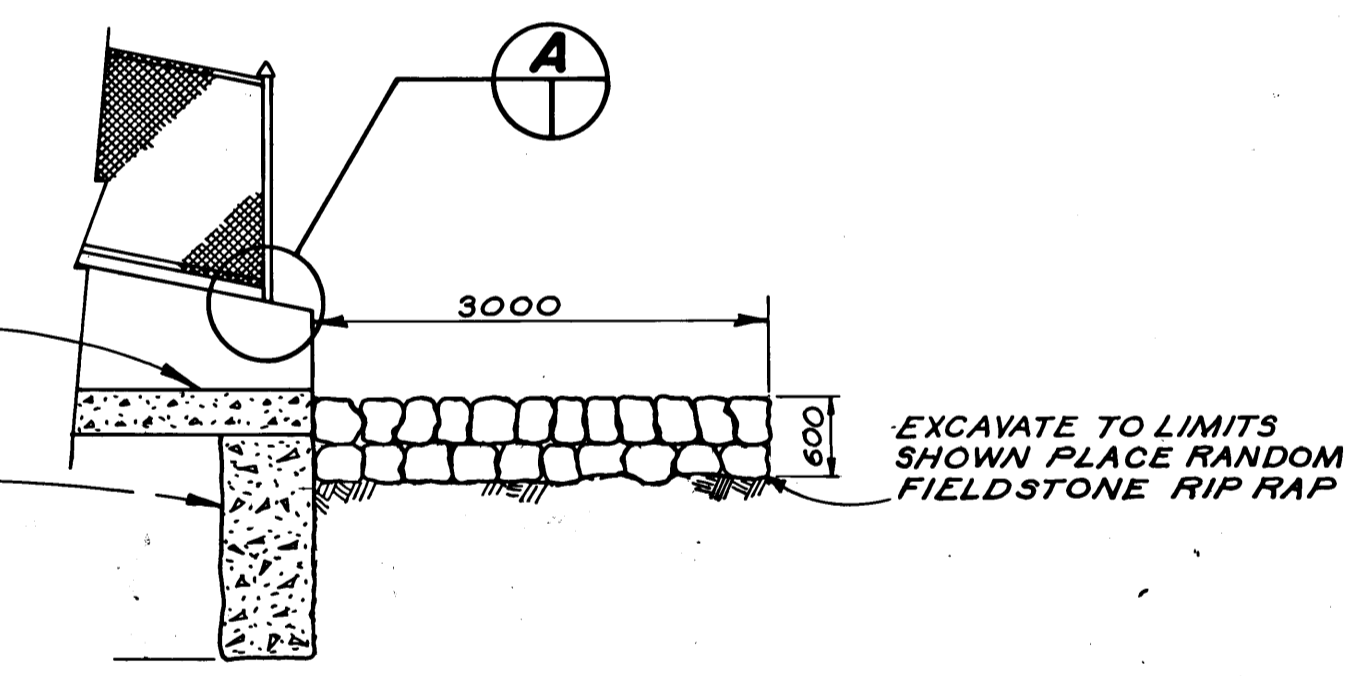


**SECTION 2**  
SCALE: 1:50

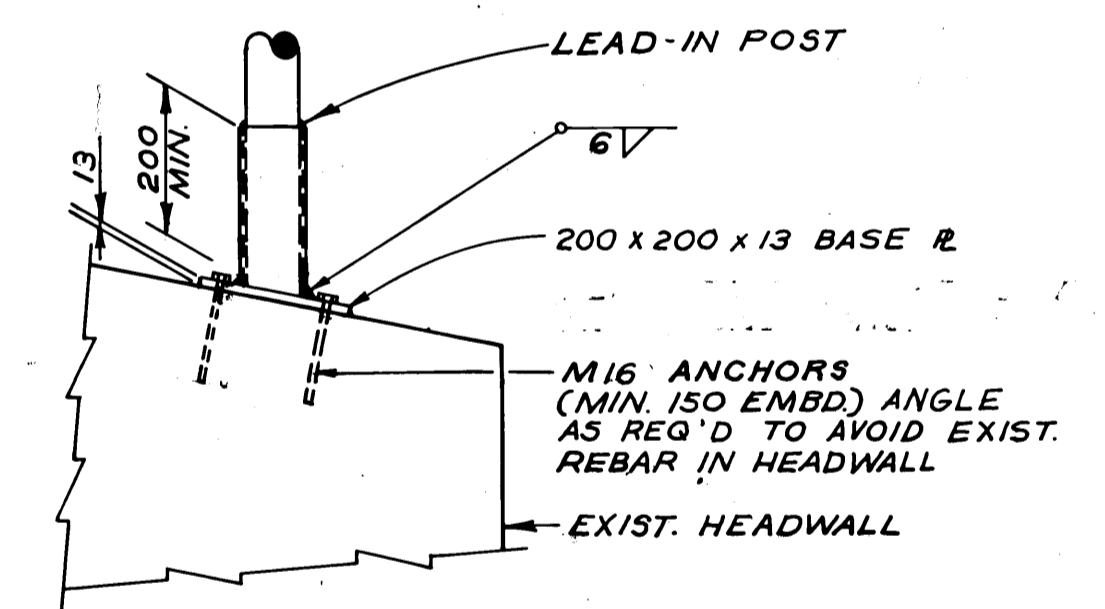

**DETAIL A**  
SCALE: 1:50

ALUMINUM TRAFFIC BARRIER RAIL COMPONENTS BILL OF MATERIALS		
ITEM	FOR INSTALLATION	FOR STANDBY
BARRIER RAIL 11430 (STRAIGHT)	4	-
BARRIER RAIL 11430 (PREBENT)	4	1
BARRIER RAIL 7280 (PREBENT)	2	1
BARRIER RAIL 4010 (PREBENT)	2	1
BARRIER RAIL 3980 (PREBENT)	2	1
TERMINAL ENDS	4	-
BRIDGE RAIL POSTS (BR 2 TYPE D)	10	-
BARRIER POST (1600)	15	1
STANDARD SPLICE BAR	14	-
RAIL CLAMP BAR	104	-
CAP SCREWS	264	-
WASHERS	264	-
SHIMS FOR RAIL POSTS	AS REQUIRED	-
SHIMS FOR RAIL END SECTION	AS REQUIRED	-
RAIL END CAPS	8	-
RAIL POST ANCHOR BOLTS	50	-

NOTE: RADIUS OF ALL PREBENT RAILS SHALL BE CHECKED WITH FIELD MEASUREMENTS TO SUIT FIELD CONDITIONS PRIOR TO FABRICATION

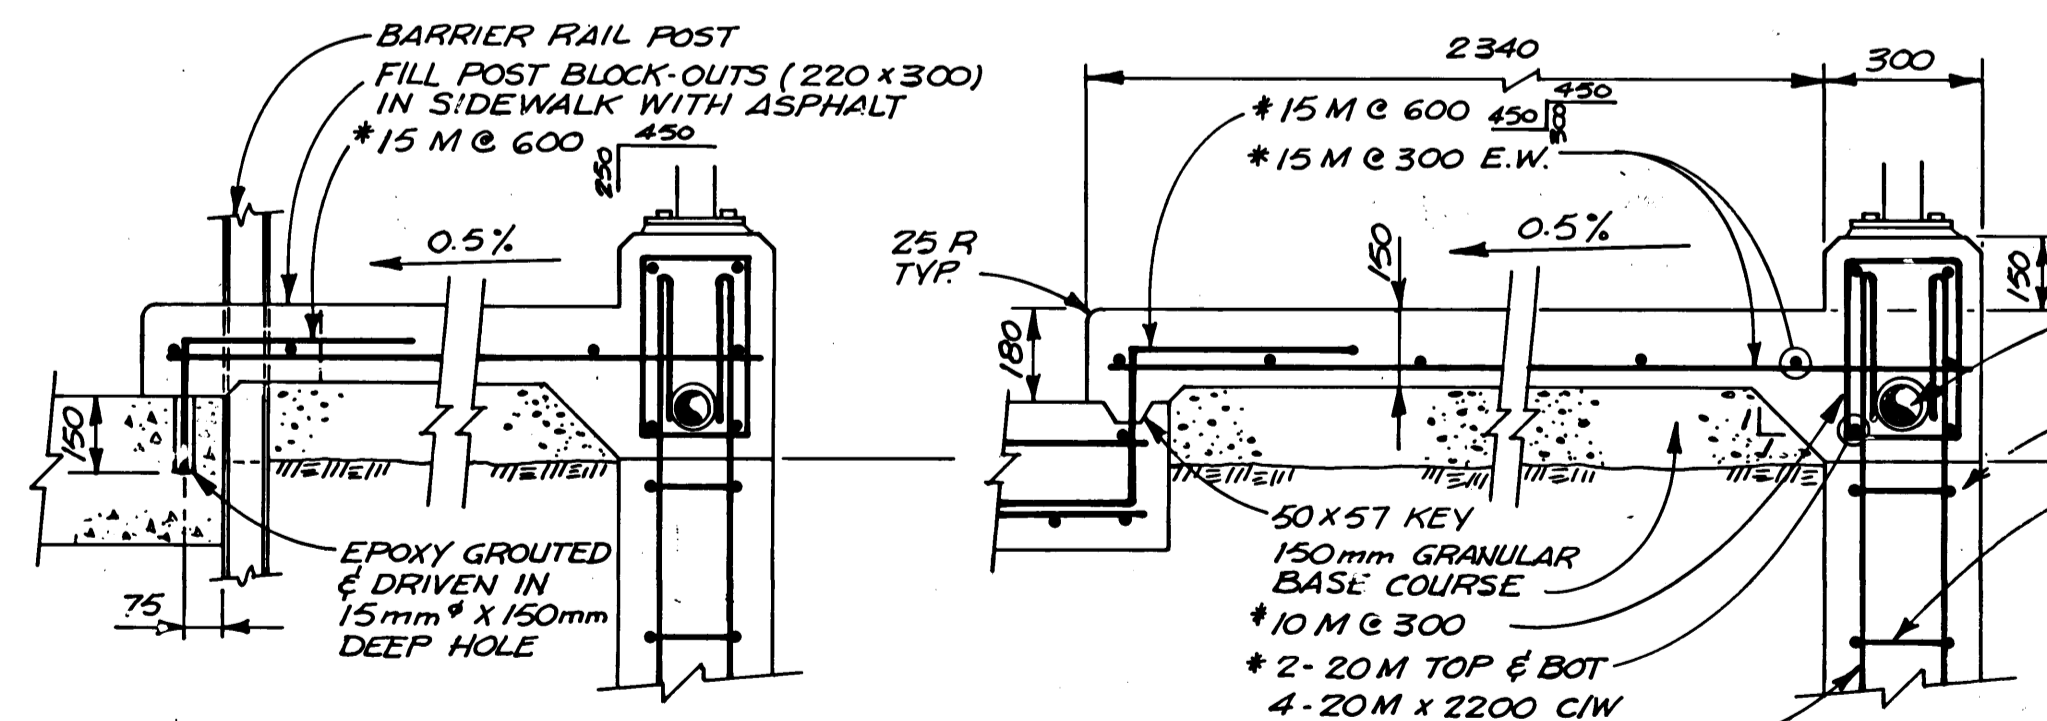

**SECTION 5**  
SCALE: 1:15

**SECTION 6**  
SCALE: 1:15

**CHAINLINK FENCE NOTES**

1. VERIFY ALL DIMENSIONS BY FIELD MEASUREMENTS PRIOR TO FABRICATION.
2. ALL FENCING MATERIALS TO BE GALVANIZED, AS SPECIFIED, AND TOUCHED UP USING "GALVALLOY".
3. CHAIN LINK MESH FABRIC TO BE CONNECTED TO POSTS AND RAILS WITH A "SLINKY" COIL.
4. NO SHARP POINTS SHALL REMAIN ON ENDS OF WIRE MESH FABRIC.
5. POSTS SHALL BE LEADED INTO GALVANIZED STEEL BASE SLEEVES.
6. POSTS AND RAILS TO BE SCH.40 PIPE.
7. ALL TERMINAL AND CORNER POSTS TO BE 73.0 mm O.D.
8. ALL LINE POSTS TO BE 60.3 mm O.D.
9. TOP AND BOTTOM RAILS TO BE 42.9 mm O.D.
10. FABRIC MESH TO BE 3.77 mm (9 GAUGE) WIRE.
11. ANCHOR BOLTS - TO BE S/S 20 mm Ø "KEYSTON ANCHOR SYSTEMS" EACH C/W S/S NUT AND S/S WASHER.

**AS BUILT**  
APPROVED BY: *[Signature]*

**B-5530-7 METRIC**

WHOLE NUMBERS INDICATE MILLIMETRES  
DECIMAL NUMBERS INDICATE METRES

ITEM	EXISTING	PROPOSED
POLES - HYDRO(M) MTS (T)	---	---
SIGNAL POLE	---	---
LIGHT STANDARD	---	---
SURVEY BAR	---	---
FIRE HYDRANT	---	---
WATER VALVE	---	---
EDGE OF PAV'T NO CURB	---	---
EDGE OF PAV'T CURBED	---	---
EDGE PAV'T CURB & GUTTER	---	---
PARAPLEGIC RAMP	---	---
ELEVATIONS	40265	40265
ASPHALT OVERLAY	---	---
PROPERTY LINE	---	---
MANHOLE	○	●
CATCH BASIN	□	■
CATCH BASIN INLET	▽	▼

**WARNING**  
IF POWER EQUIPMENT OR EXPLOSIVES ARE TO BE USED FOR EXCAVATION ON THIS PROJECT THE CONTRACTOR MUST:  
1) NOTIFY THE GAS COMPANY OF THE PROPOSED LOCATION OF EXCAVATION.  
2) TAKE PRECAUTION TO AVOID DAMAGE TO GAS COMPANY INSTALLATIONS.  
SEE PROVINCIAL REGULATION 210/72 FOR DETAILS

**LOCATION APPROVED UNDERGROUND STRUCTURES**  
DATE: \_\_\_\_\_ SUPERVISOR: \_\_\_\_\_  
LOCATIONS OF UNDERGROUND STRUCTURES AS SHOWN ARE BASED ON THE BEST INFORMATION AVAILABLE, BUT NO GUARANTEE IS GIVEN THAT ALL EXISTING UTILITIES ARE SHOWN OR THAT THE GIVEN LOCATIONS ARE EXACT. CONFIRMATION OF EXISTENCE AND EXACT LOCATION OF ALL SERVICES MUST BE OBTAINED FROM THE INDIVIDUAL UTILITIES BEFORE PROCEEDING WITH CONSTRUCTION.

PROVINCE OF MANITOBA  
REGISTERED ENGINEER  
N. B. ULYATT  
REGISTERED ENGINEER

**DILLON**  
Consulting Engineers & Planners  
DESIGNED BY: S.S.R. DRAWN BY: C.R.B.  
CHECKED BY: N.B.U. DATE: MAY 85  
APPROVED BY: *[Signature]* DATE: \_\_\_\_\_

THE CITY OF WINNIPEG  
WORKS & OPERATIONS DIVISION  
STREETS & TRANSPORTATION DEPARTMENT

ROUTE 90 CULVERT AT OMAND'S CREEK  
TOP SLAB REHABILITATION, STRUCTURAL STRENGTHENING AND RELATED WORKS  
LAYOUT OF BALANCED ALUMINUM SHOULDER BARRIER, HEADWALL CHAINLINK FENCE AND RIP RAP  
AUTHORIZED BY: *[Signature]* 1985-05-03  
ACCEPTED BY: *[Signature]* 1985-05-03  
SCALE: 1:100 OR AS NOTED DRAWING NO: C315-85-07