




PART ELEVATION-EXISTING WEST PIER

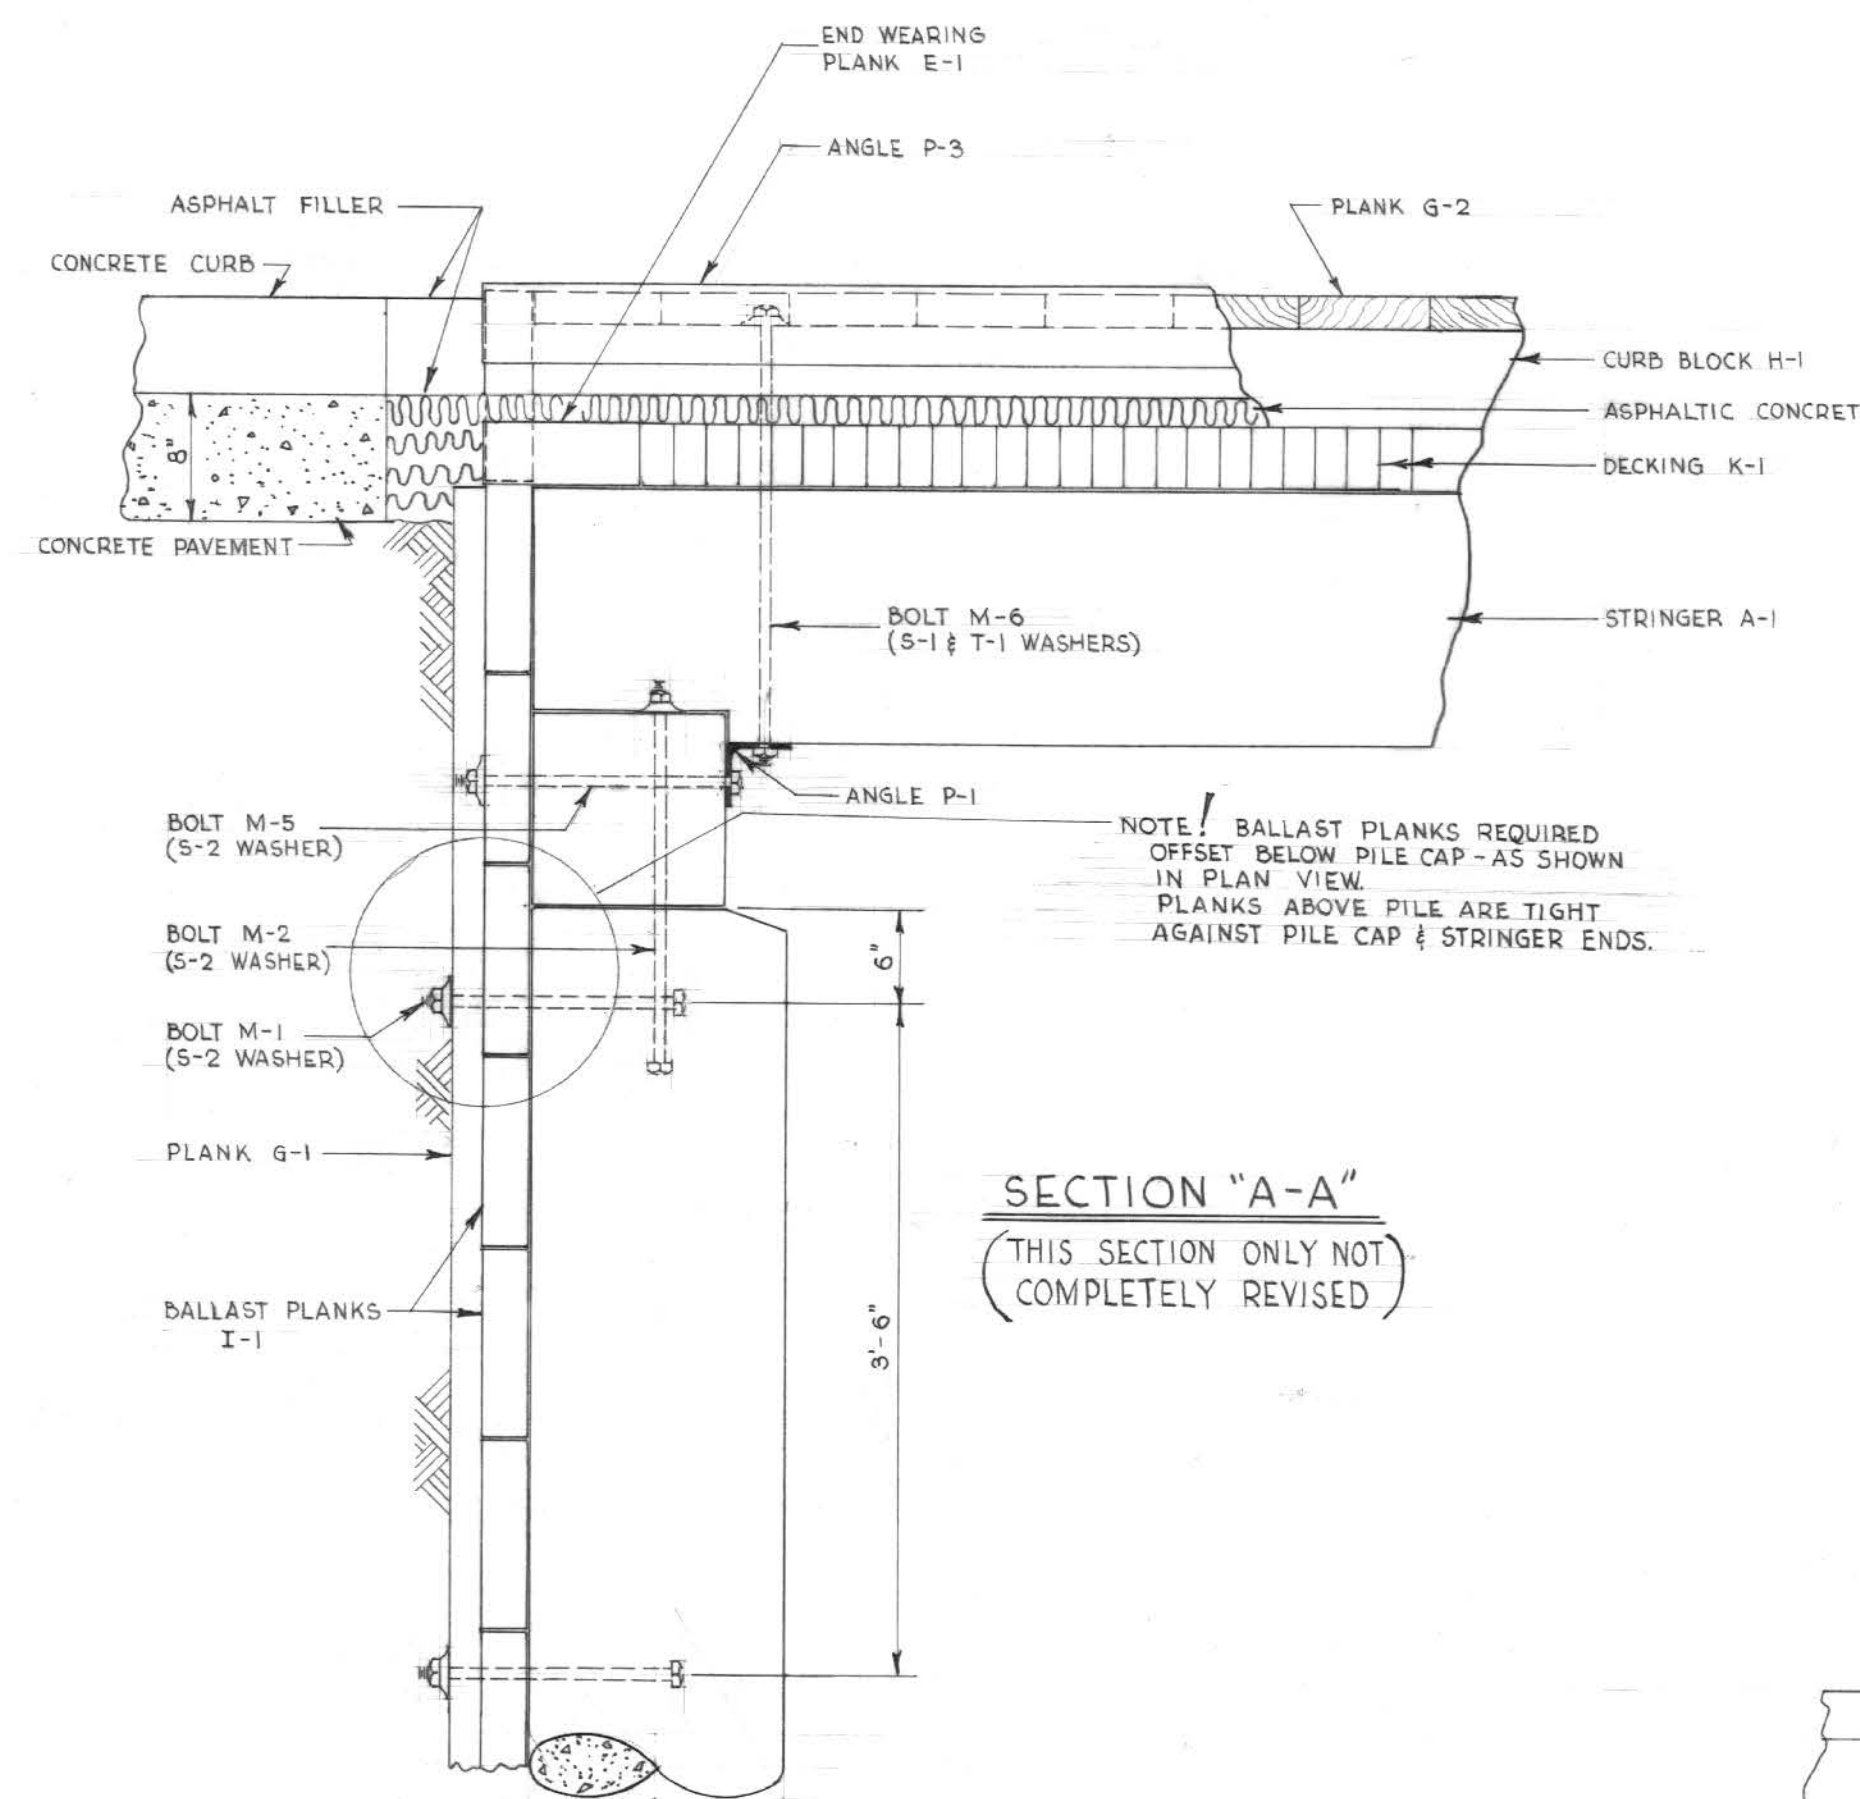


SECTION "A-A"
(THIS SECTION ONLY NOT COMPLETELY REVISED)

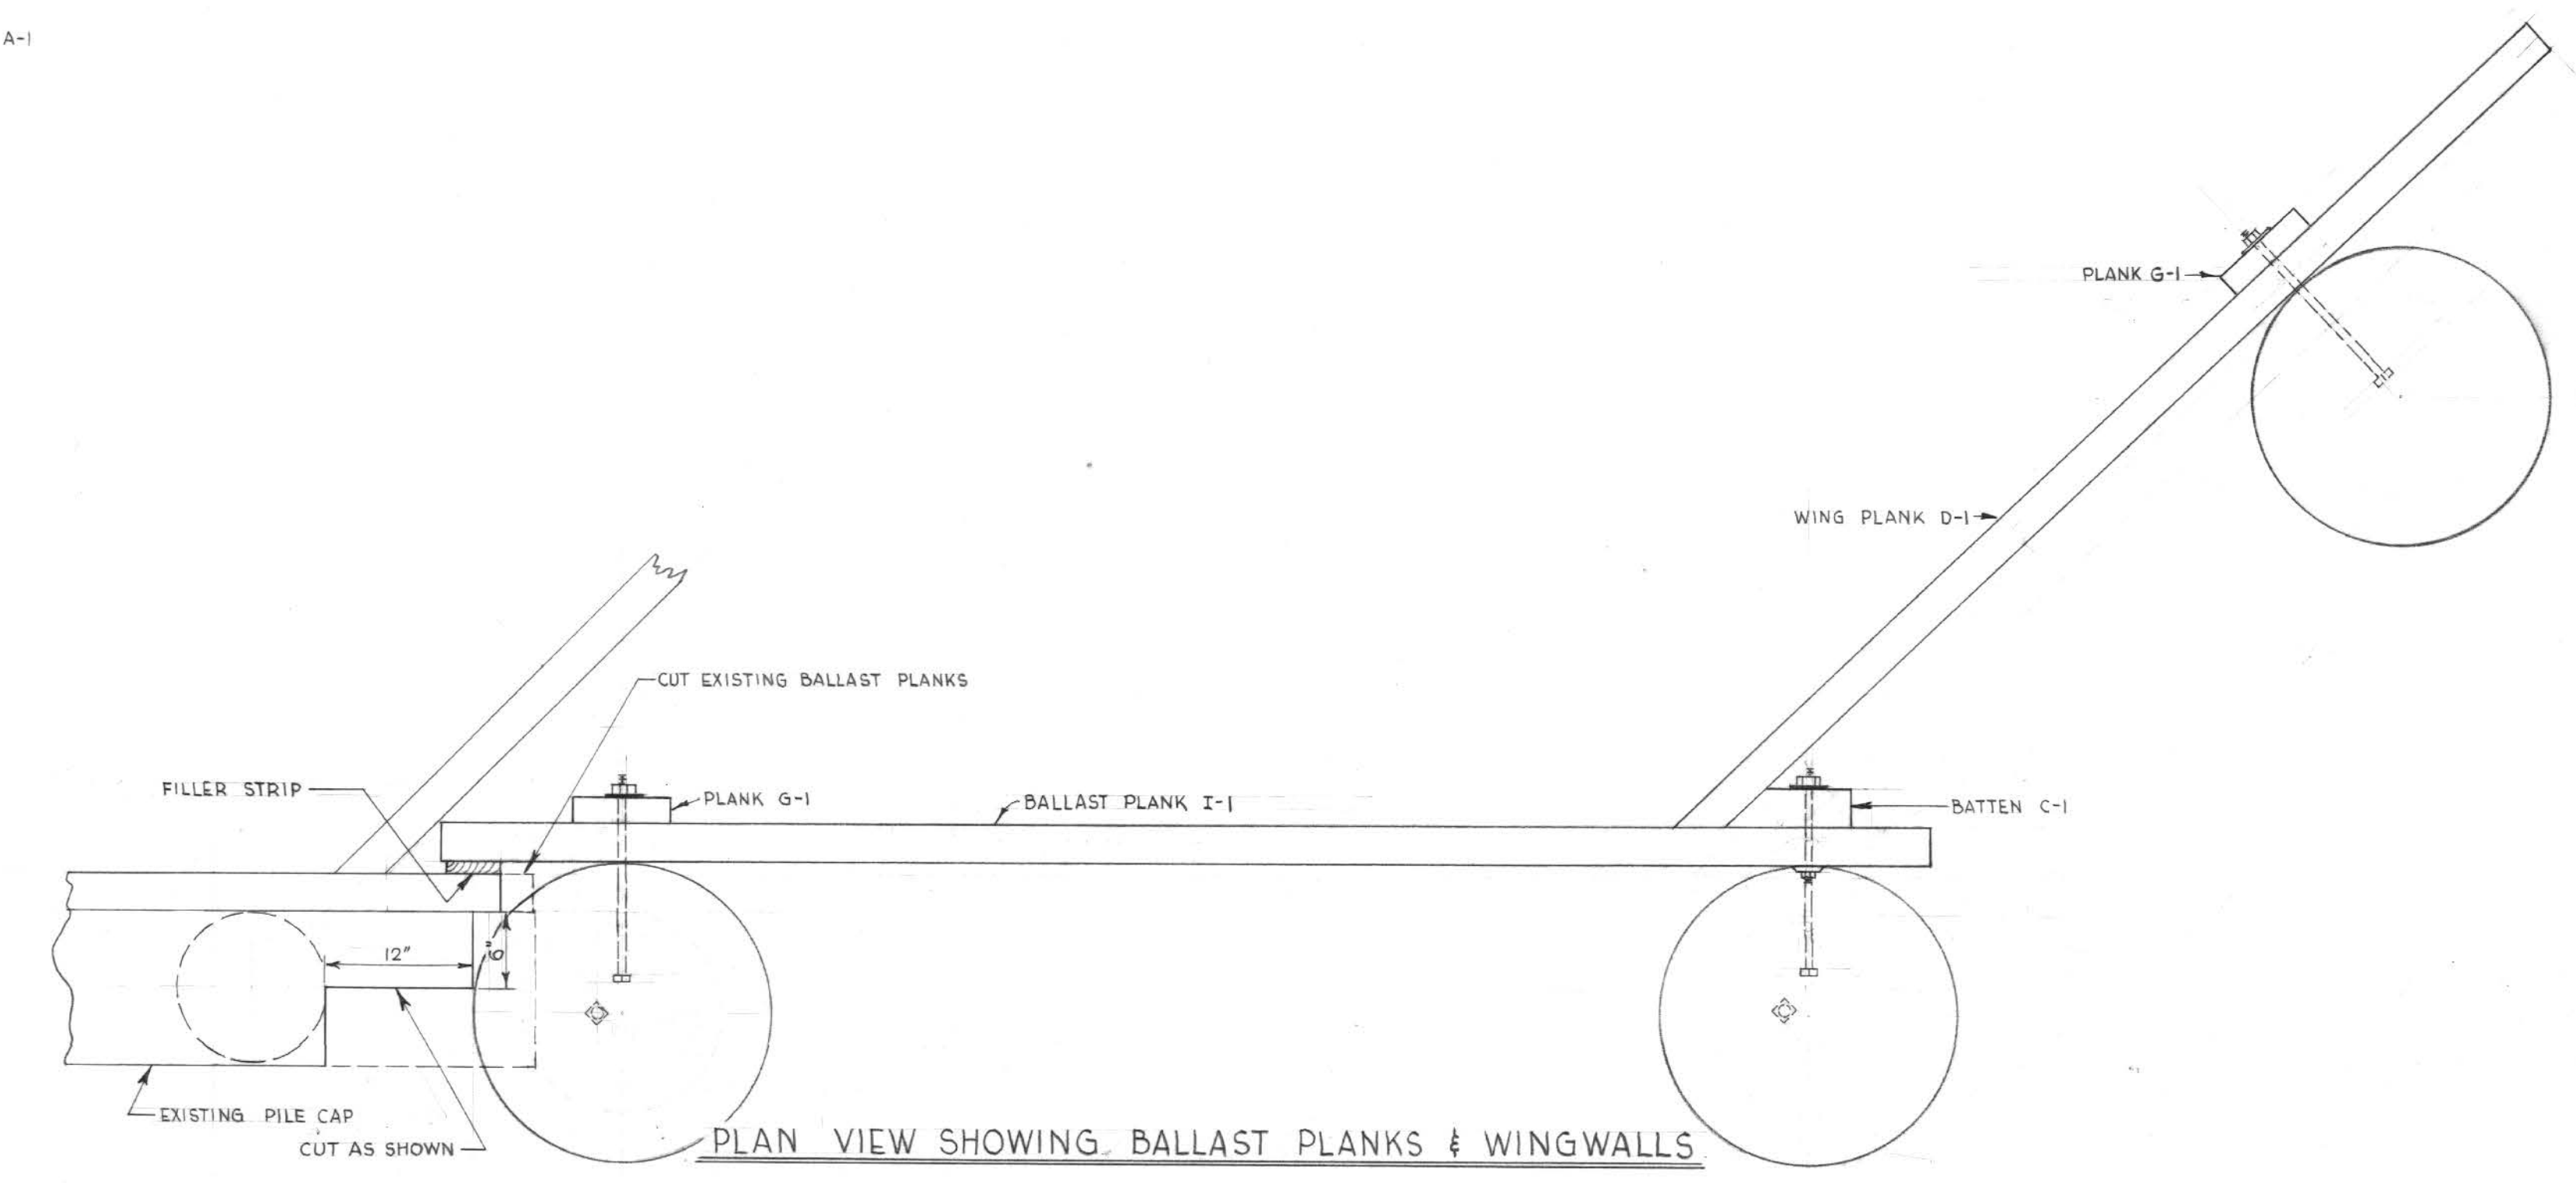

PLAN VIEW SHOWING BALLAST PLANKS & WINGWALLS

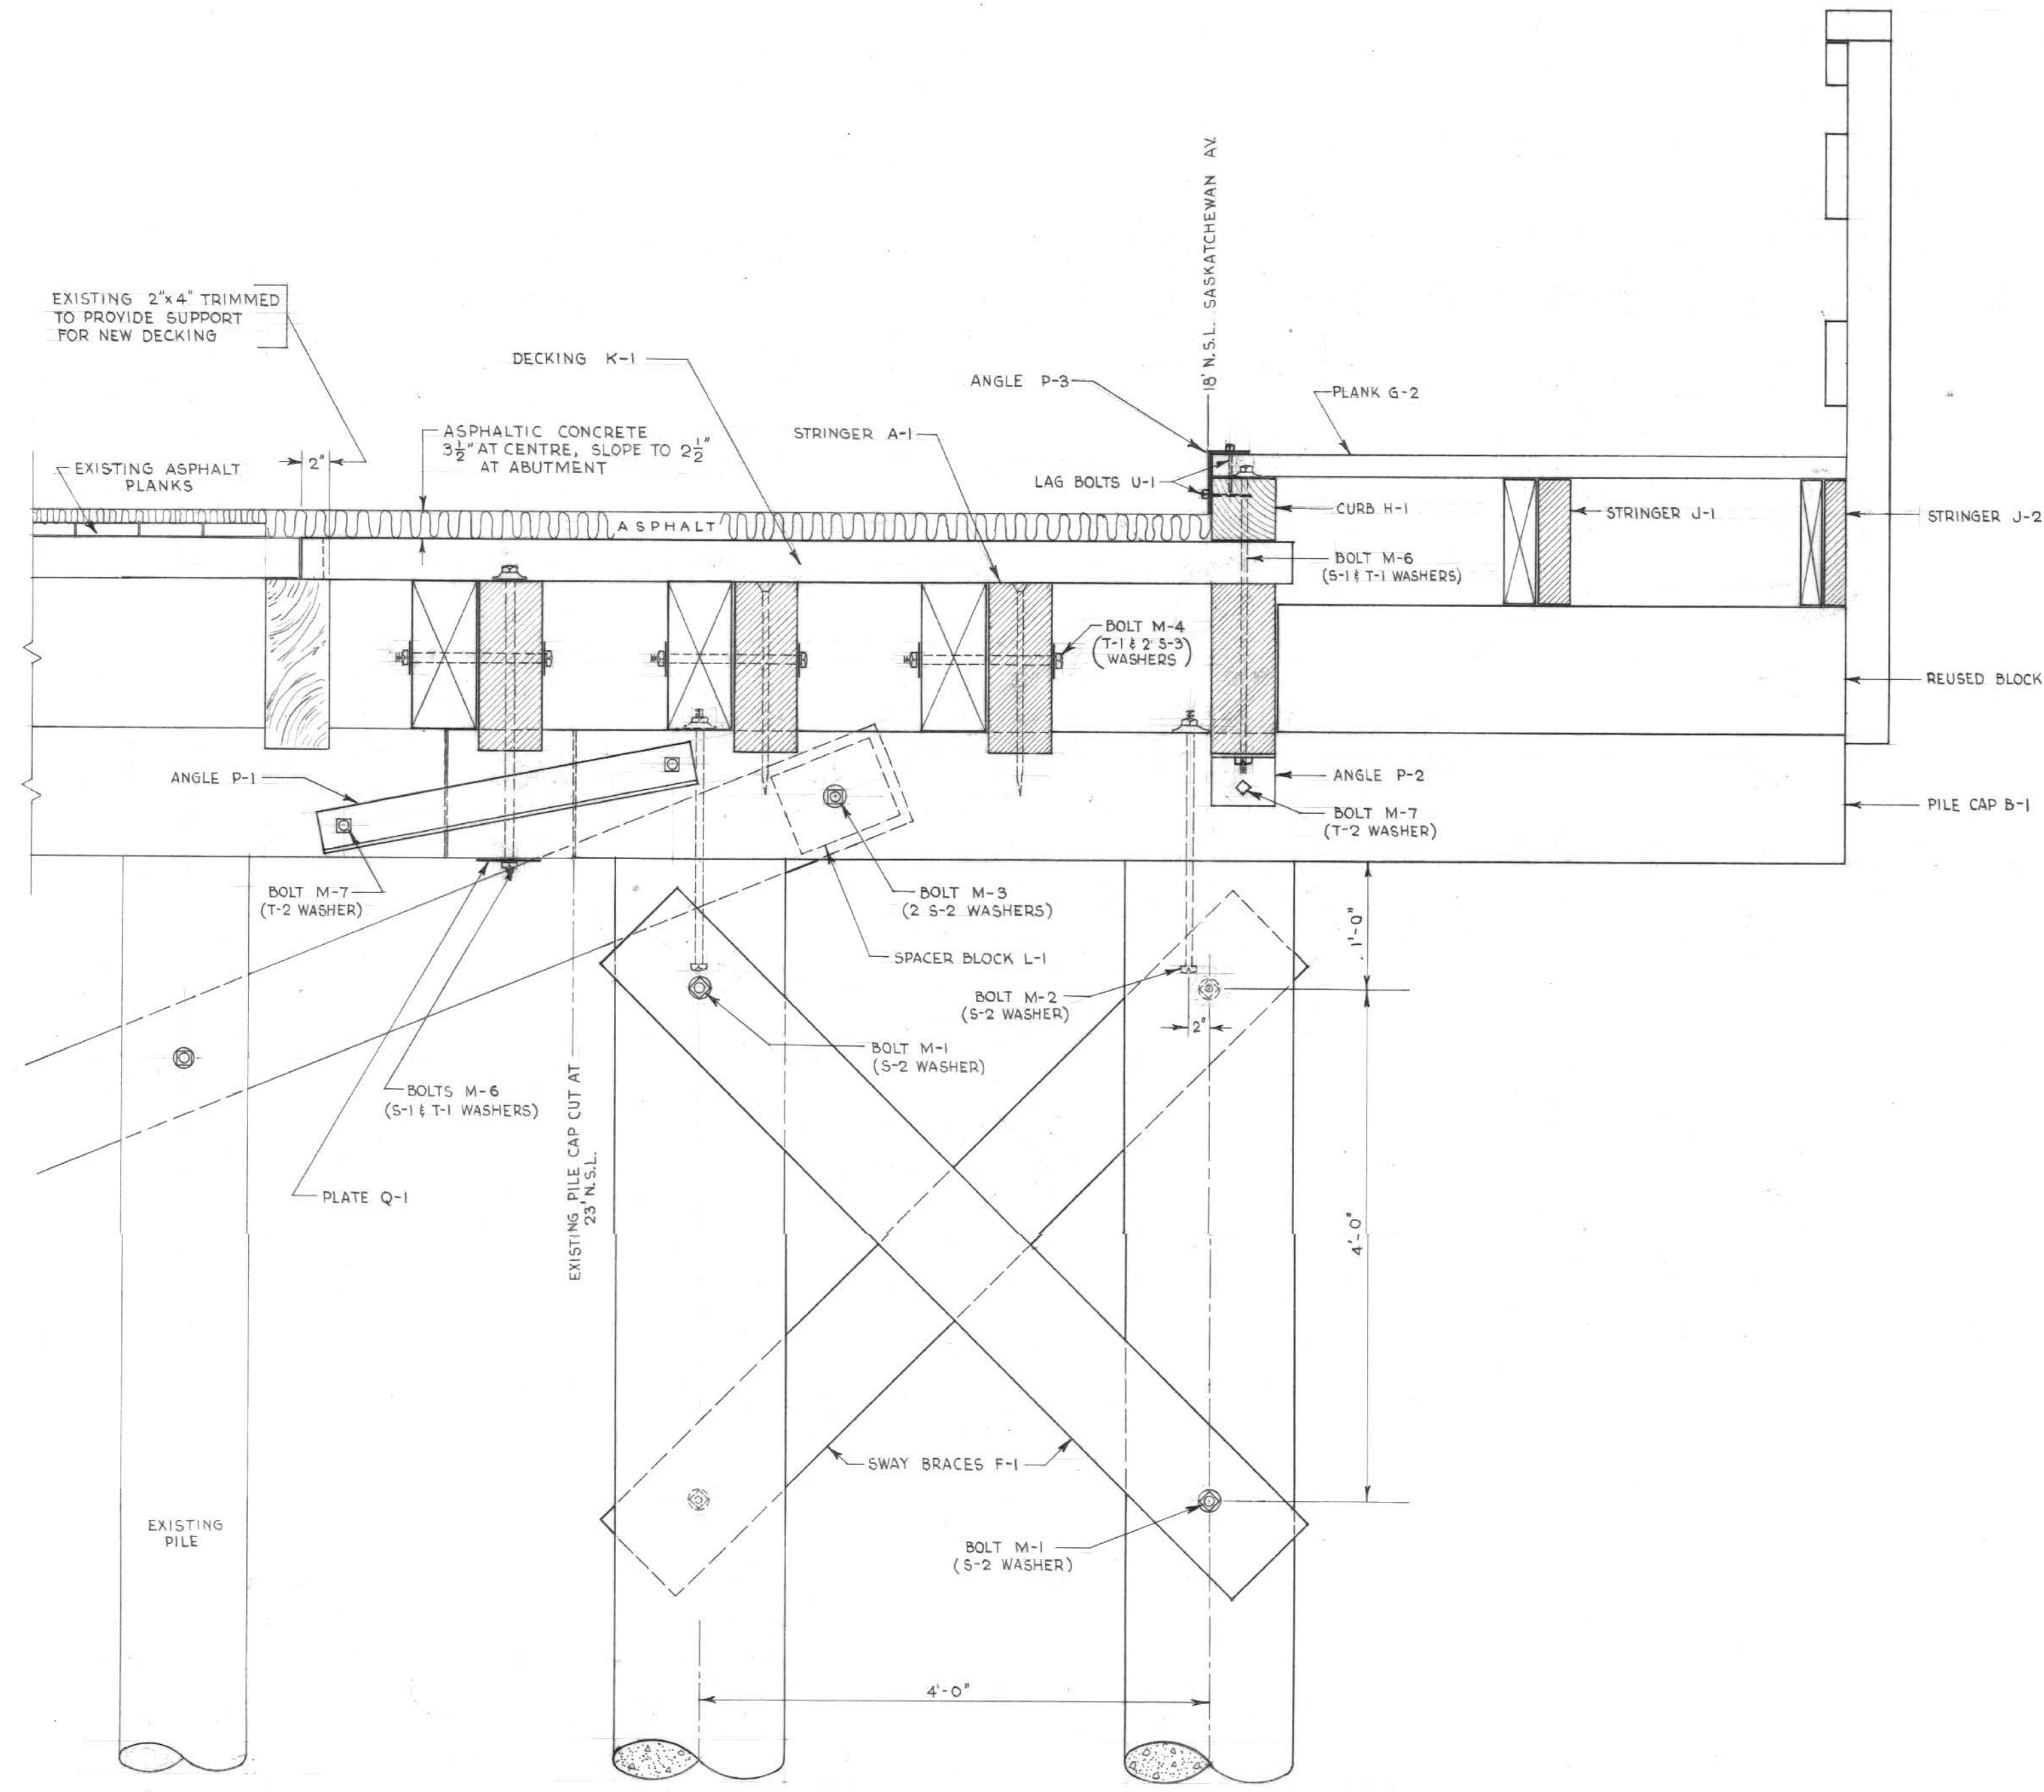

ELEVATION OF WEST PIER WIDENING

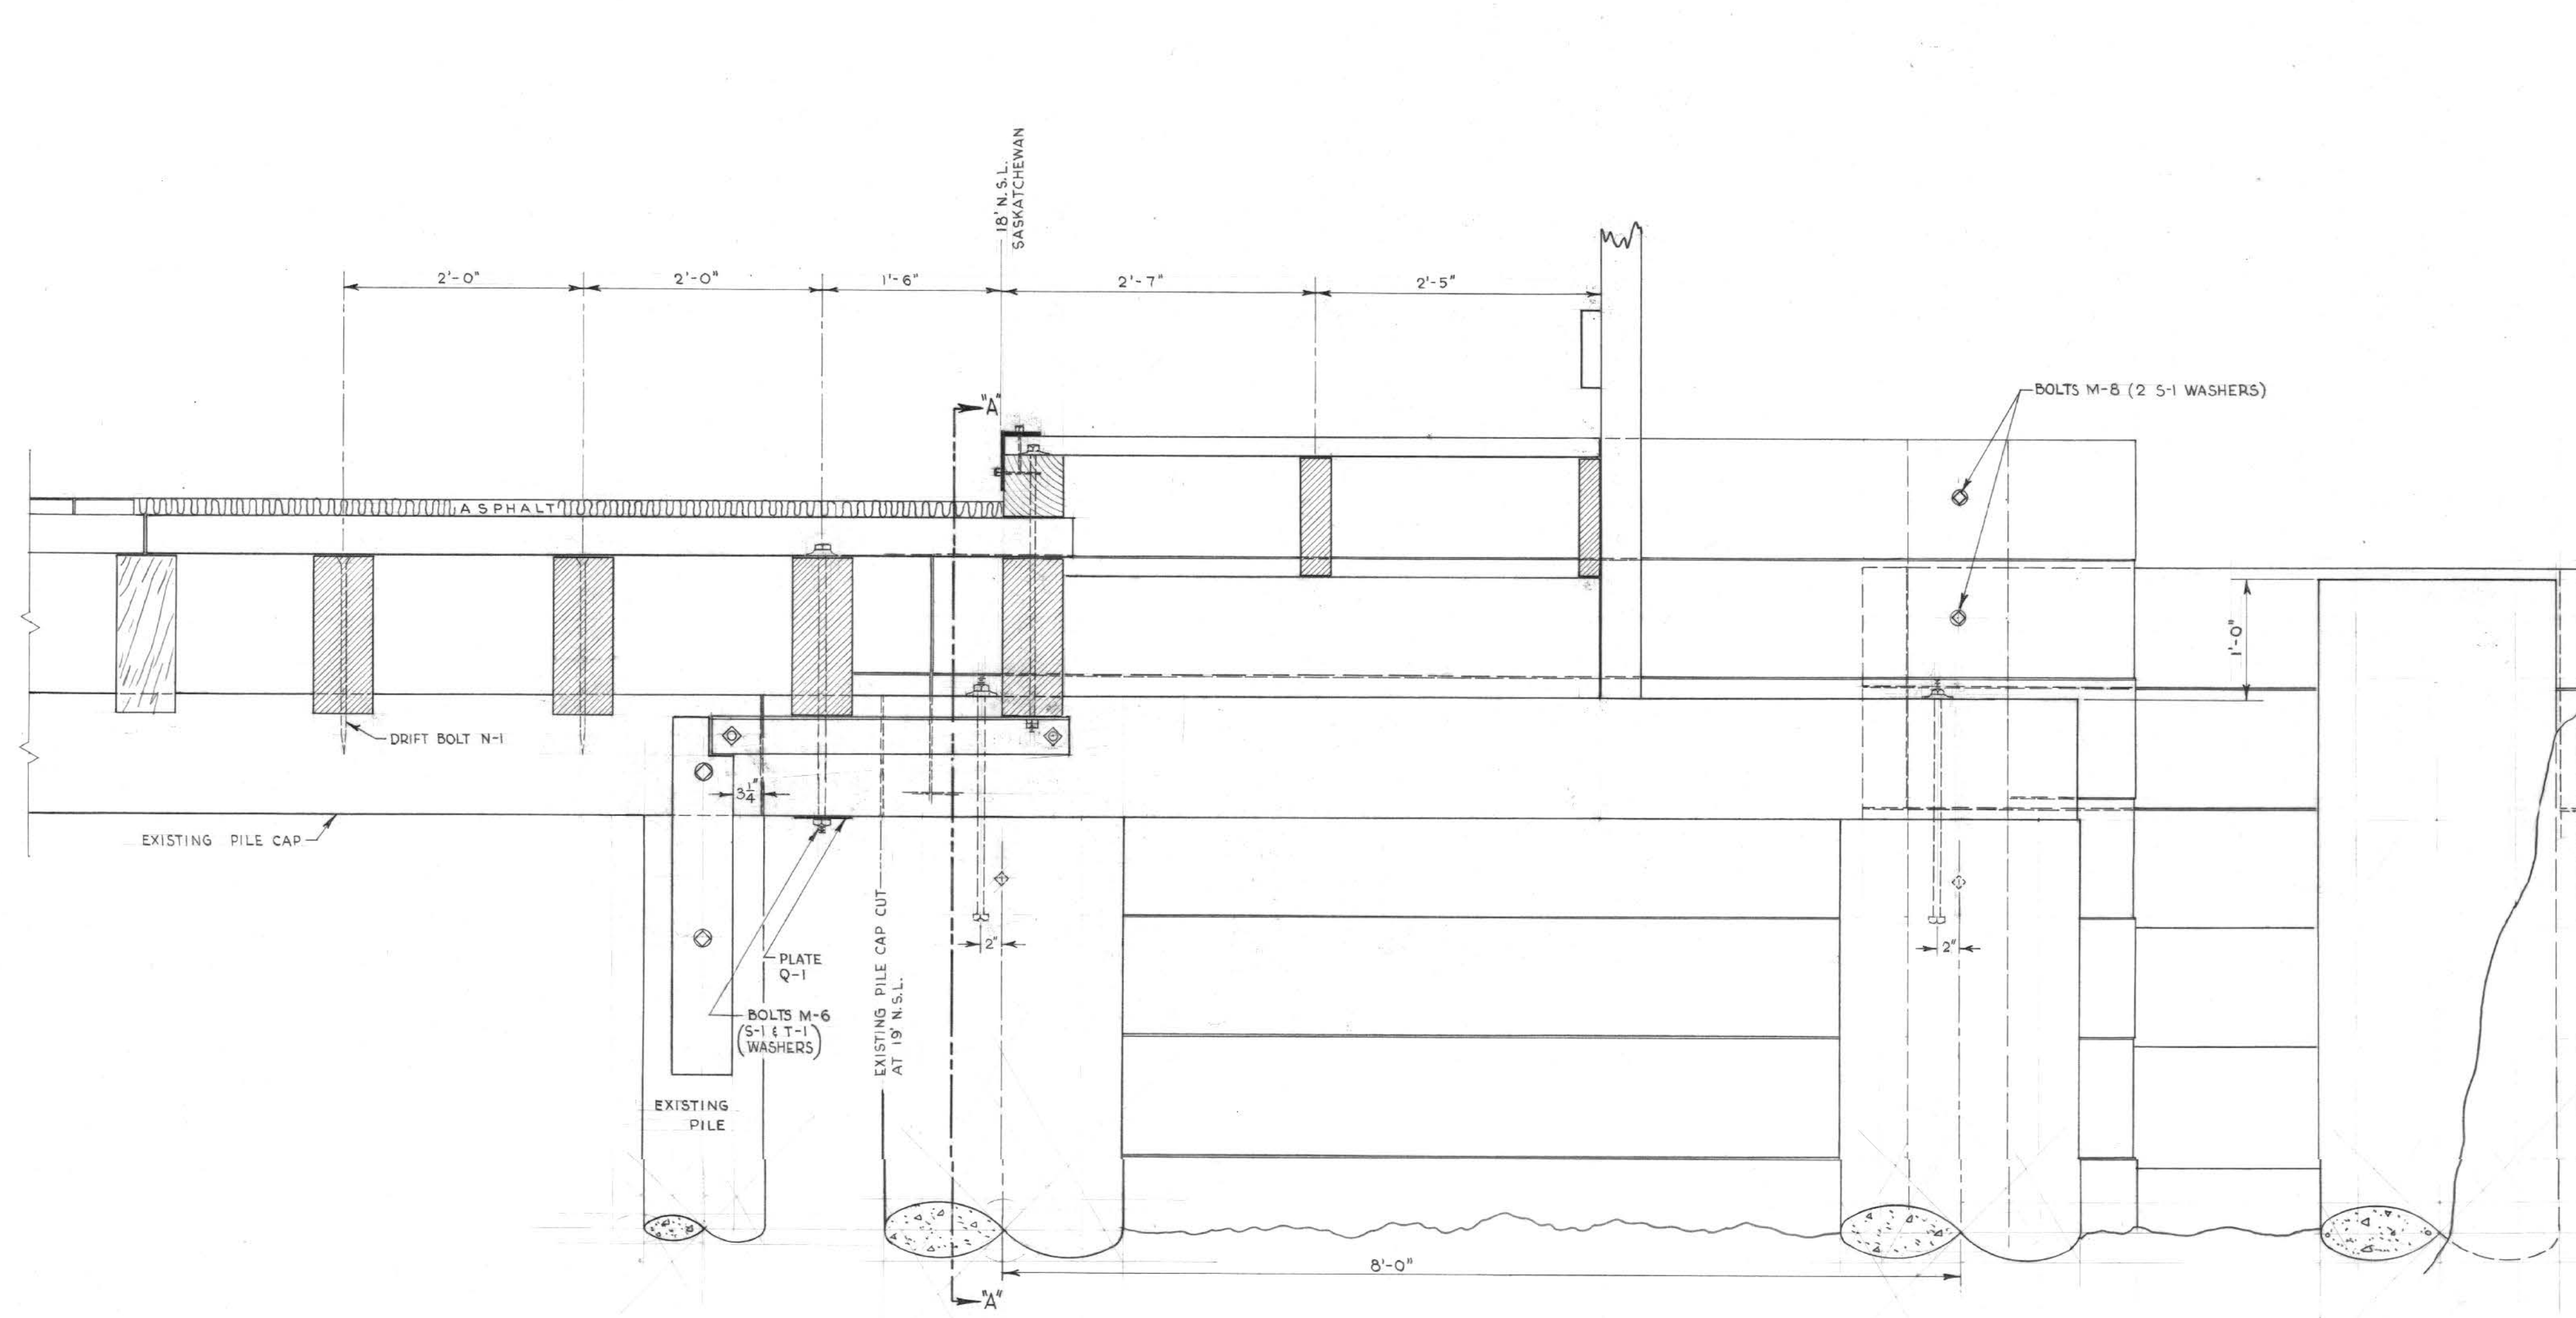

ELEVATION OF EAST ABUTMENT WIDENING

BENCH MARK: N.W. COR. STONE STEP AT ANTHEM IMPERIAL #1930 SASKATCHEWAN EL. 38.32

REVISED AS CONSTRUCTED
BY: DATE: SEPT. 15/70
CHECKED BY: DATE: 12/70

WHEN STARTING CONSTRUCTION NOTIFY
E. J. CONWAY
PROVINCIAL WATER CONTROL
PHONE 284-4470
CHARGES: a) Repairs to existing bridge only - change to 215-104-325
b) All work involved in widening - change to 100-122-512

NO.	DATE	TO
		G. DENSON
		J. ALLAN
6	JAN. 26/70	R. HOUGHTON
5		S. LIPKOVSKY
		J. McLEOD

DISTRIBUTION RECORD



APPROVED BY:
I.E. Weber - 22 Aug 68. (See file A-100-D) JH
For Water Control & Conservation Branch
DEPARTMENT OF HIGHWAYS

BRIDGE WIDENING ON SASKATCHEWAN AV.
OVER OMANDS CREEK
CROSS SECTION DETAILS

CITY OF WINNIPEG
ENGINEERING DEPARTMENT
W. D. HURST, CITY ENGINEER
J. B. STRICOWSKI, DEPUTY CITY ENGINEER
DRAWN BY: DATE: JULY 16/68
CHECKED BY: DATE: 1/70
APPROVED BY: DATE: 1/70
SCALE: 1" = 1'
DRAWING NO.: BC-4523