
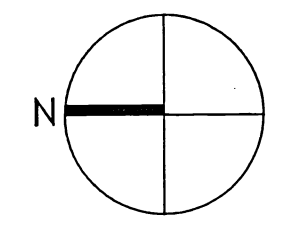


25 Rosebud  
 address  
 SCANNED  
 project no. M-1  
 sheet no.  
 crawl space (Mech)  
 description  
 Bass Am Pool Addition

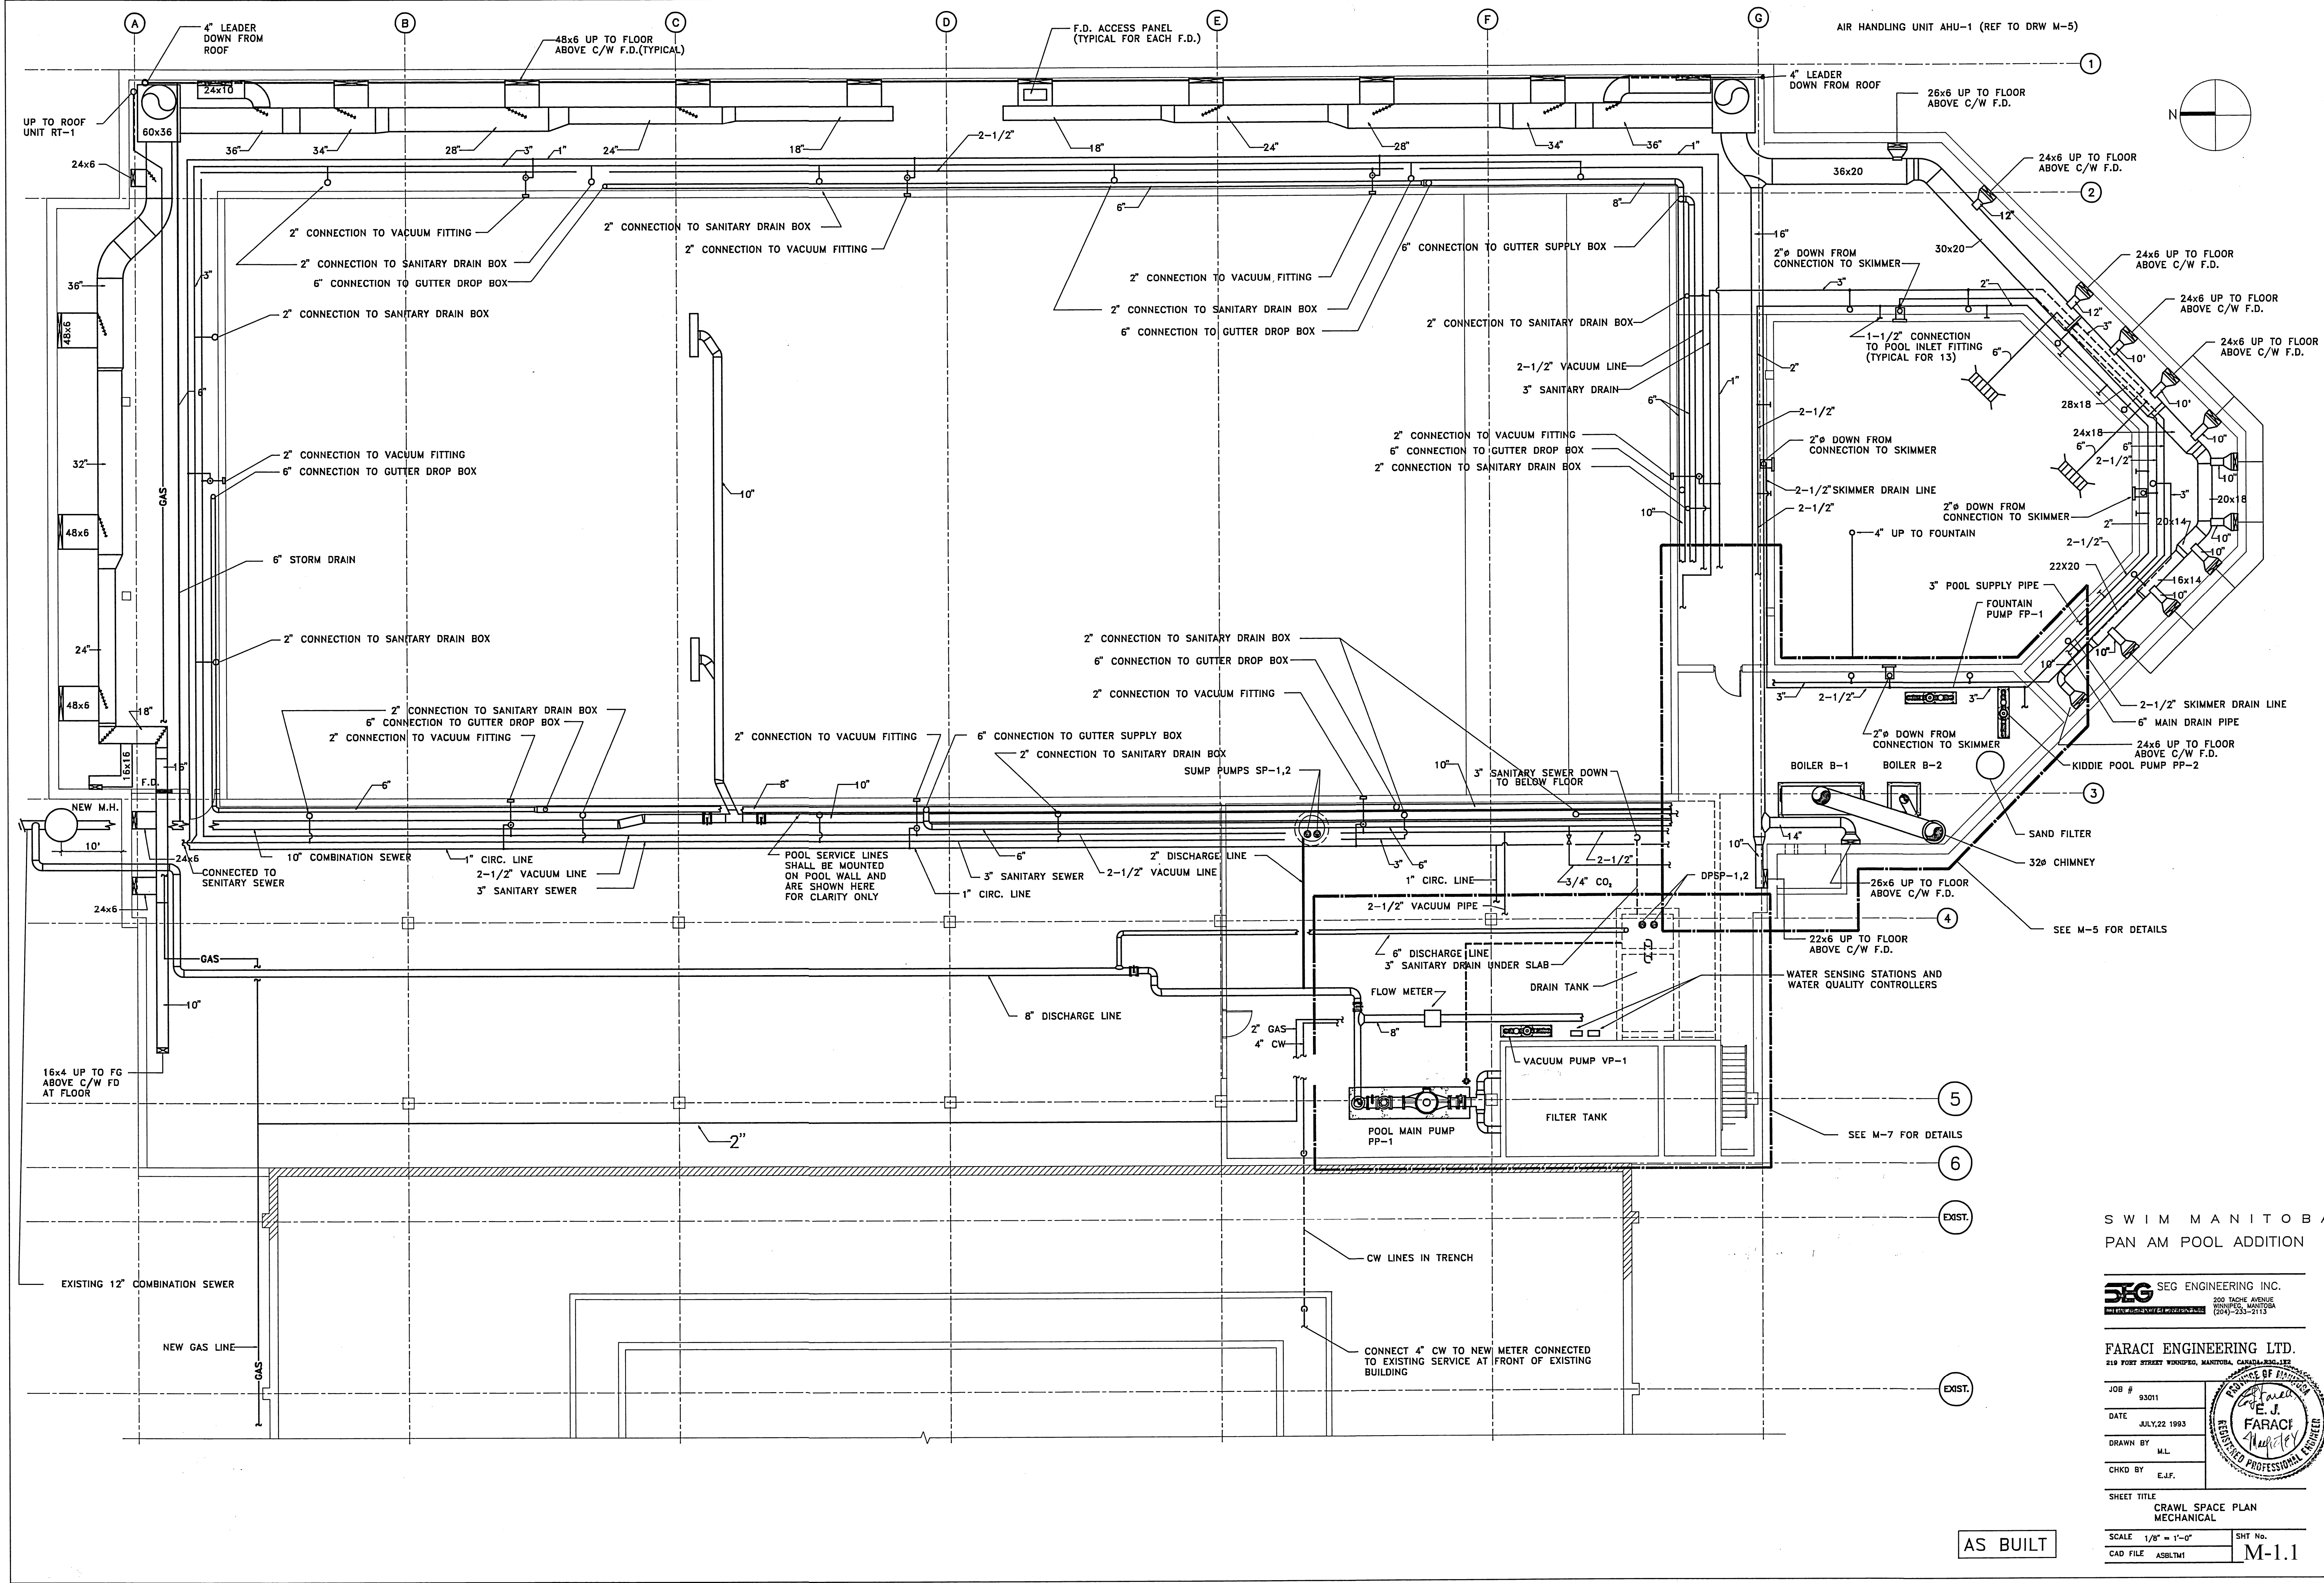

SWIM MANITOBA  
 PAN AM POOL ADDITION

SEG ENGINEERING INC.  
 200 TACHE AVENUE  
 WINNIPEG, MANITOBA  
 CANADA R3S 1L3

FARACI ENGINEERING LTD.  
 210 FORT STREET WINNIPEG, MANITOBA, CANADA R3B 1E9



JOB # 93011  
 DATE JULY 22 1993  
 DRAWN BY M.L.  
 CHKD BY E.J.F.

SHEET TITLE  
 CRAWL SPACE PLAN  
 MECHANICAL

SCALE 1/8" = 1'-0" SHT No. M-1.1  
 CAD FILE ASBLTM1

AS BUILT