


PAN AM POOL  
CONCOURSE HEATING & VENTILATION  
LEVEL

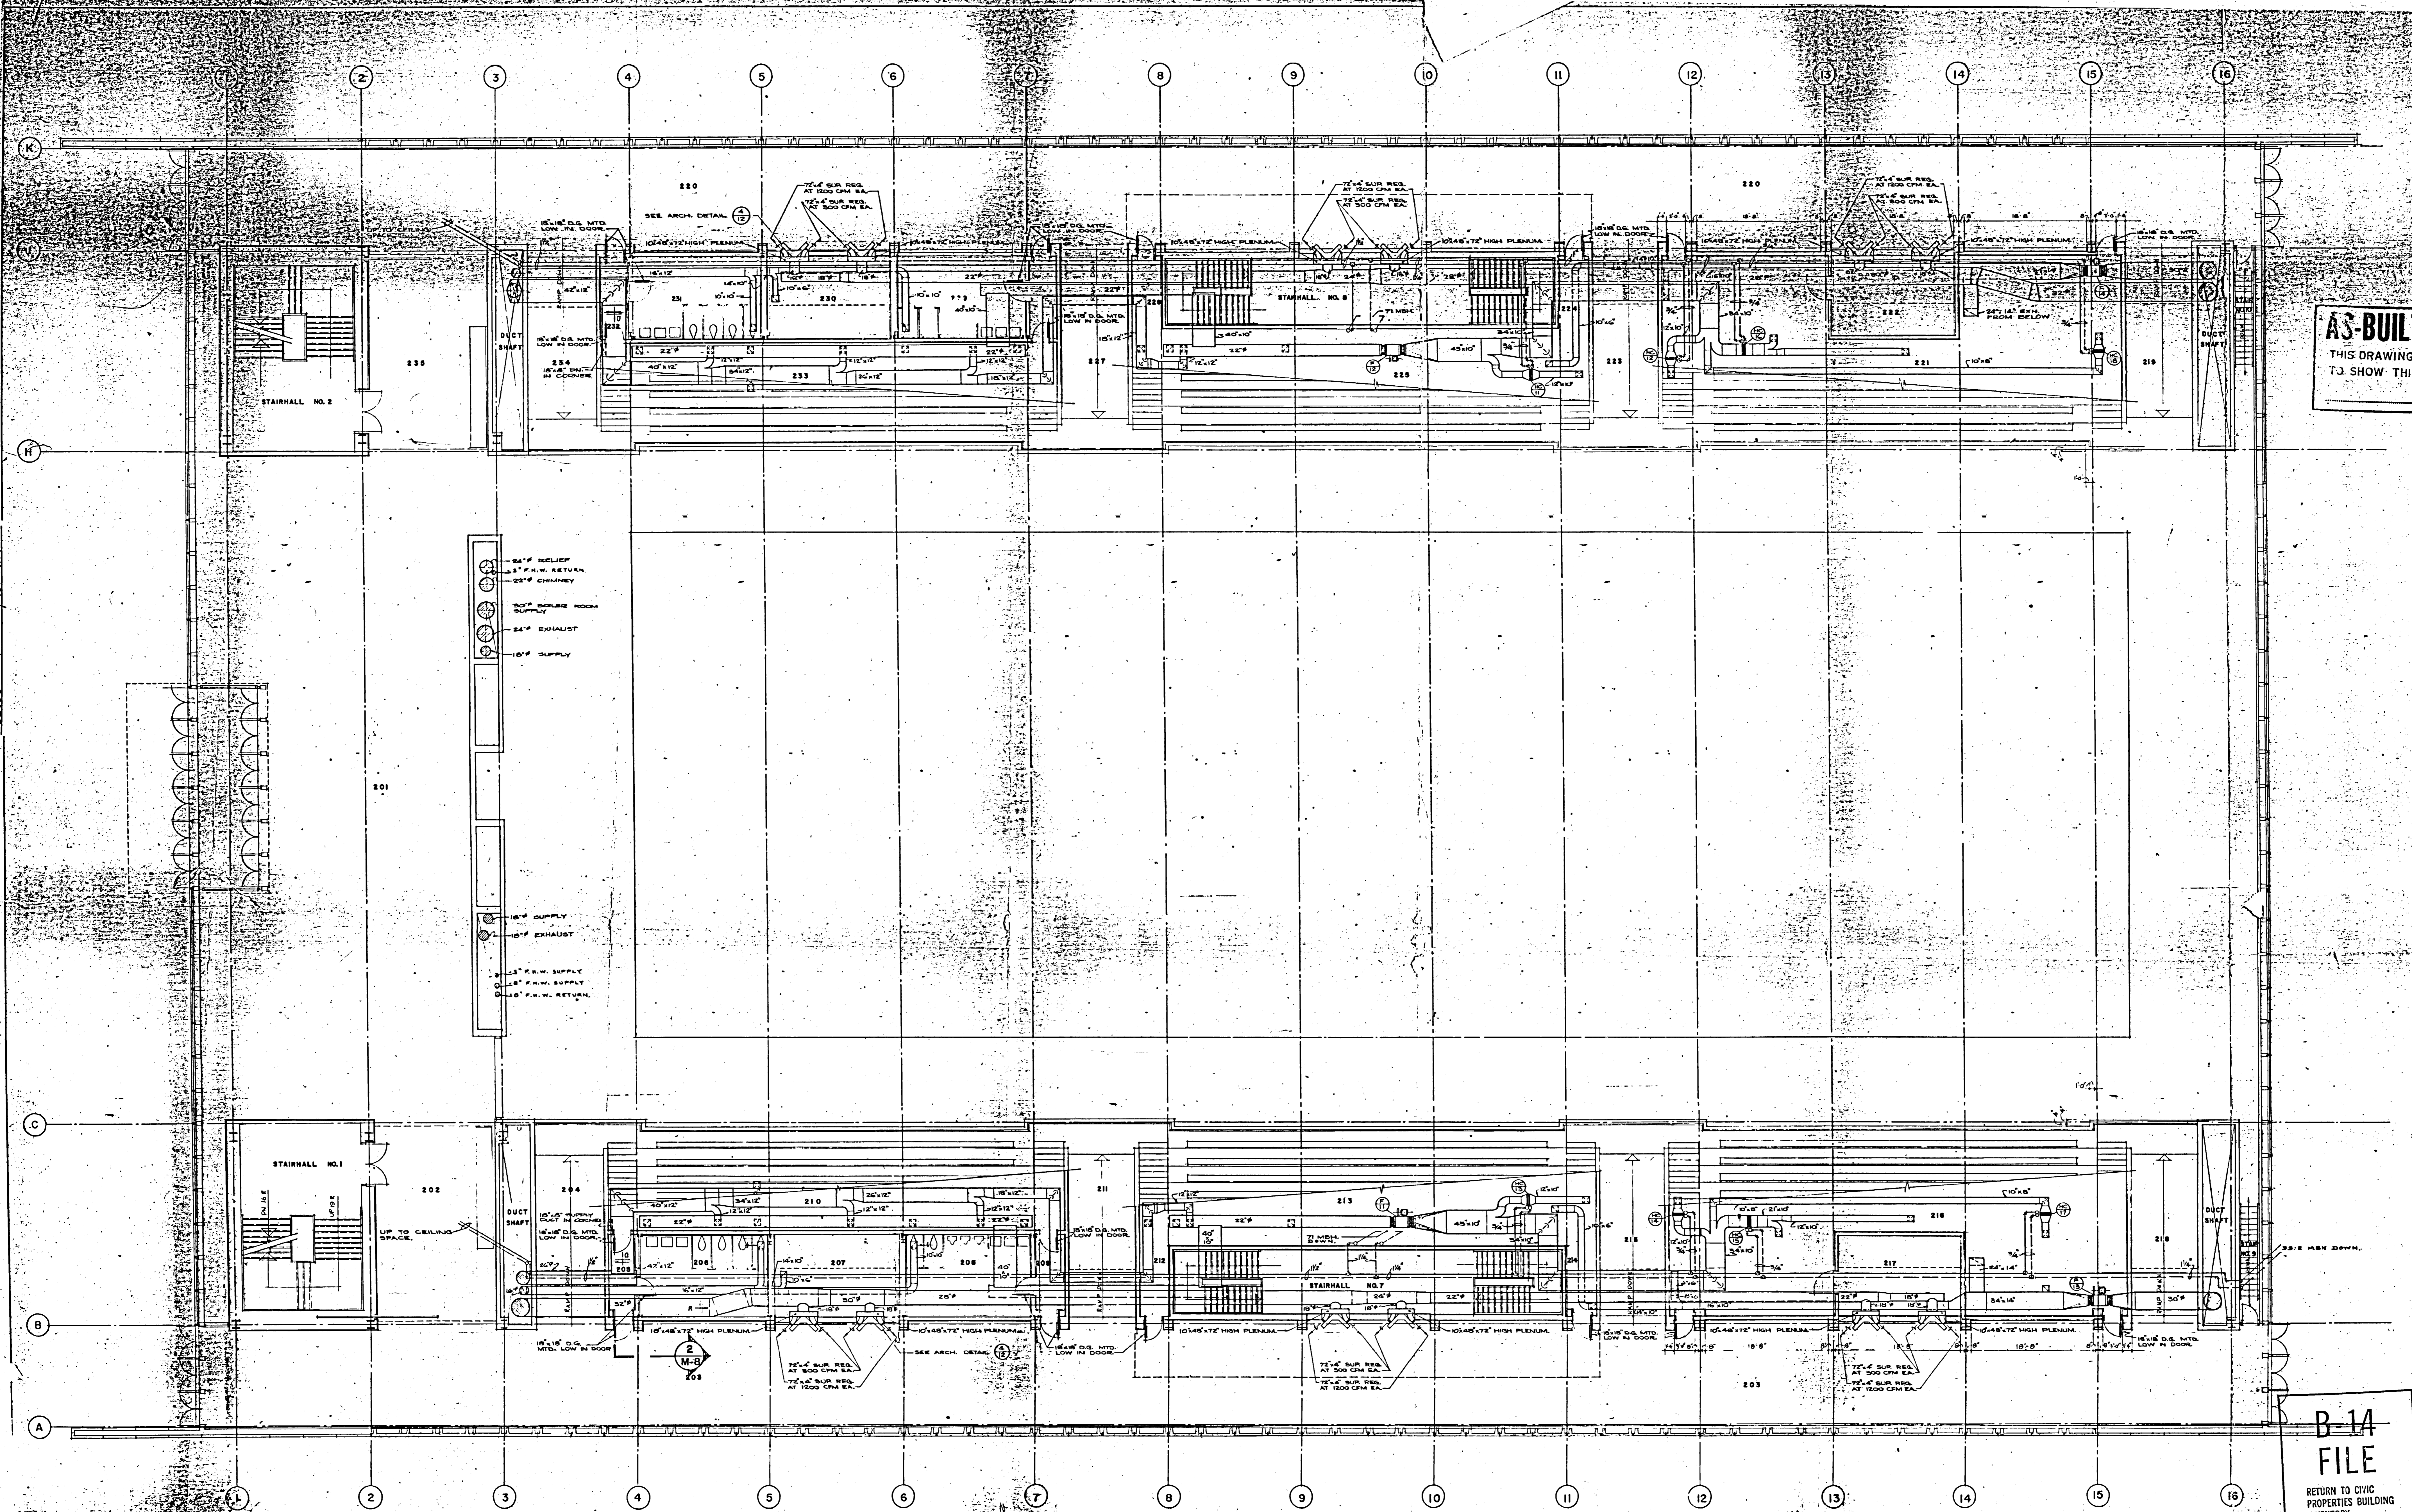


**AS-BUILT DRAWING**  
THIS DRAWING HAS BEEN REVISED  
TO SHOW THIS BUILDING AS-BUILT

NO.	REF.	DESCRIPTION	DATE
REVISIONS (READ UP)			

SMITH CARTER SEARLE ASSOCIATES  
ARCHITECTS AND CONSULTING ENGINEERS  
WINNIPEG BRANDBON PORT ARTHUR TORONTO

PROF. OF MANITOBA  
G. H. CURRIE  
REGISTERED ENGINEER

PROF. OF MANITOBA  
SMITH CARTER SEARLE  
REGISTERED ARCHITECT

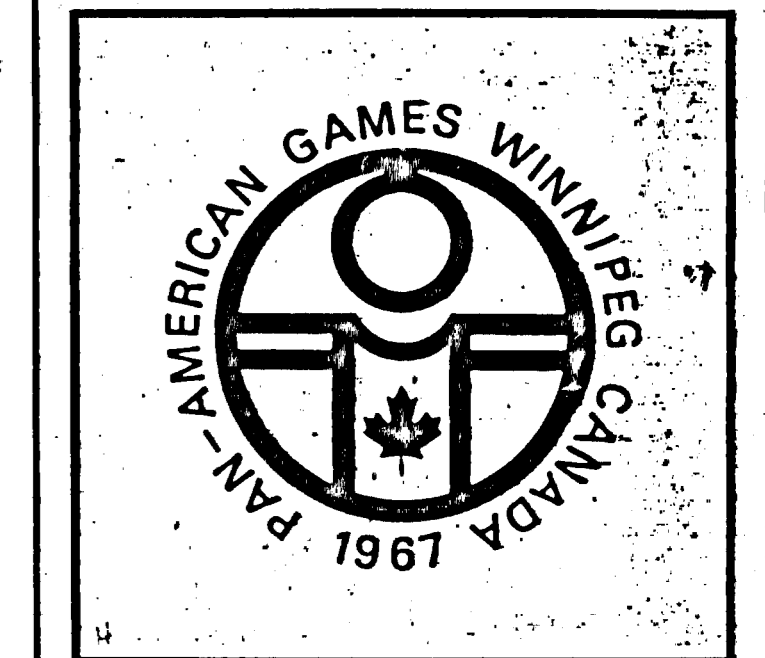

PAN-AMERICAN GAMES  
SWIMMING FACILITY  
WINNIPEG, MANITOBA

**B-14  
FILE**  
RETURN TO CIVIC  
PROPERTIES BUILDING  
INVENTORY.  
3-01-6

SCALE  
1/8" = 1'-0"  
FILE NUMBER  
65080  
PLATE NUMBER  
M-5