


- PHASE II - STAGE 3 NOTES:**
- SUGGESTED SCHEDULE**
- 13 MONTHS FOR PHASE II - STAGE 1, 2 AND 3 (STAGE 3 OCCURS OVER ONE WEEKEND DURING STAGE 1 OR 2)
 - OCTOBER (2017) TO OCTOBER (2018)
- MAJOR CONSTRUCTION ACTIVITIES**
- REPAVE DETOUR AT MAINLINE CROSSING
 - RAISE MAIN TRACK CROSSING (BY OTHERS)
 - SIGNAGE AND TRAFFIC CONTROL SETUP FOR WEEKEND CLOSURE (BY OTHERS)
- TRAFFIC AND PEDESTRIAN CONTROL**
- DETOUR ROADWAY CLOSED
 - EASTBOUND TAYLOR PERMITTED TO CONTINUE EAST

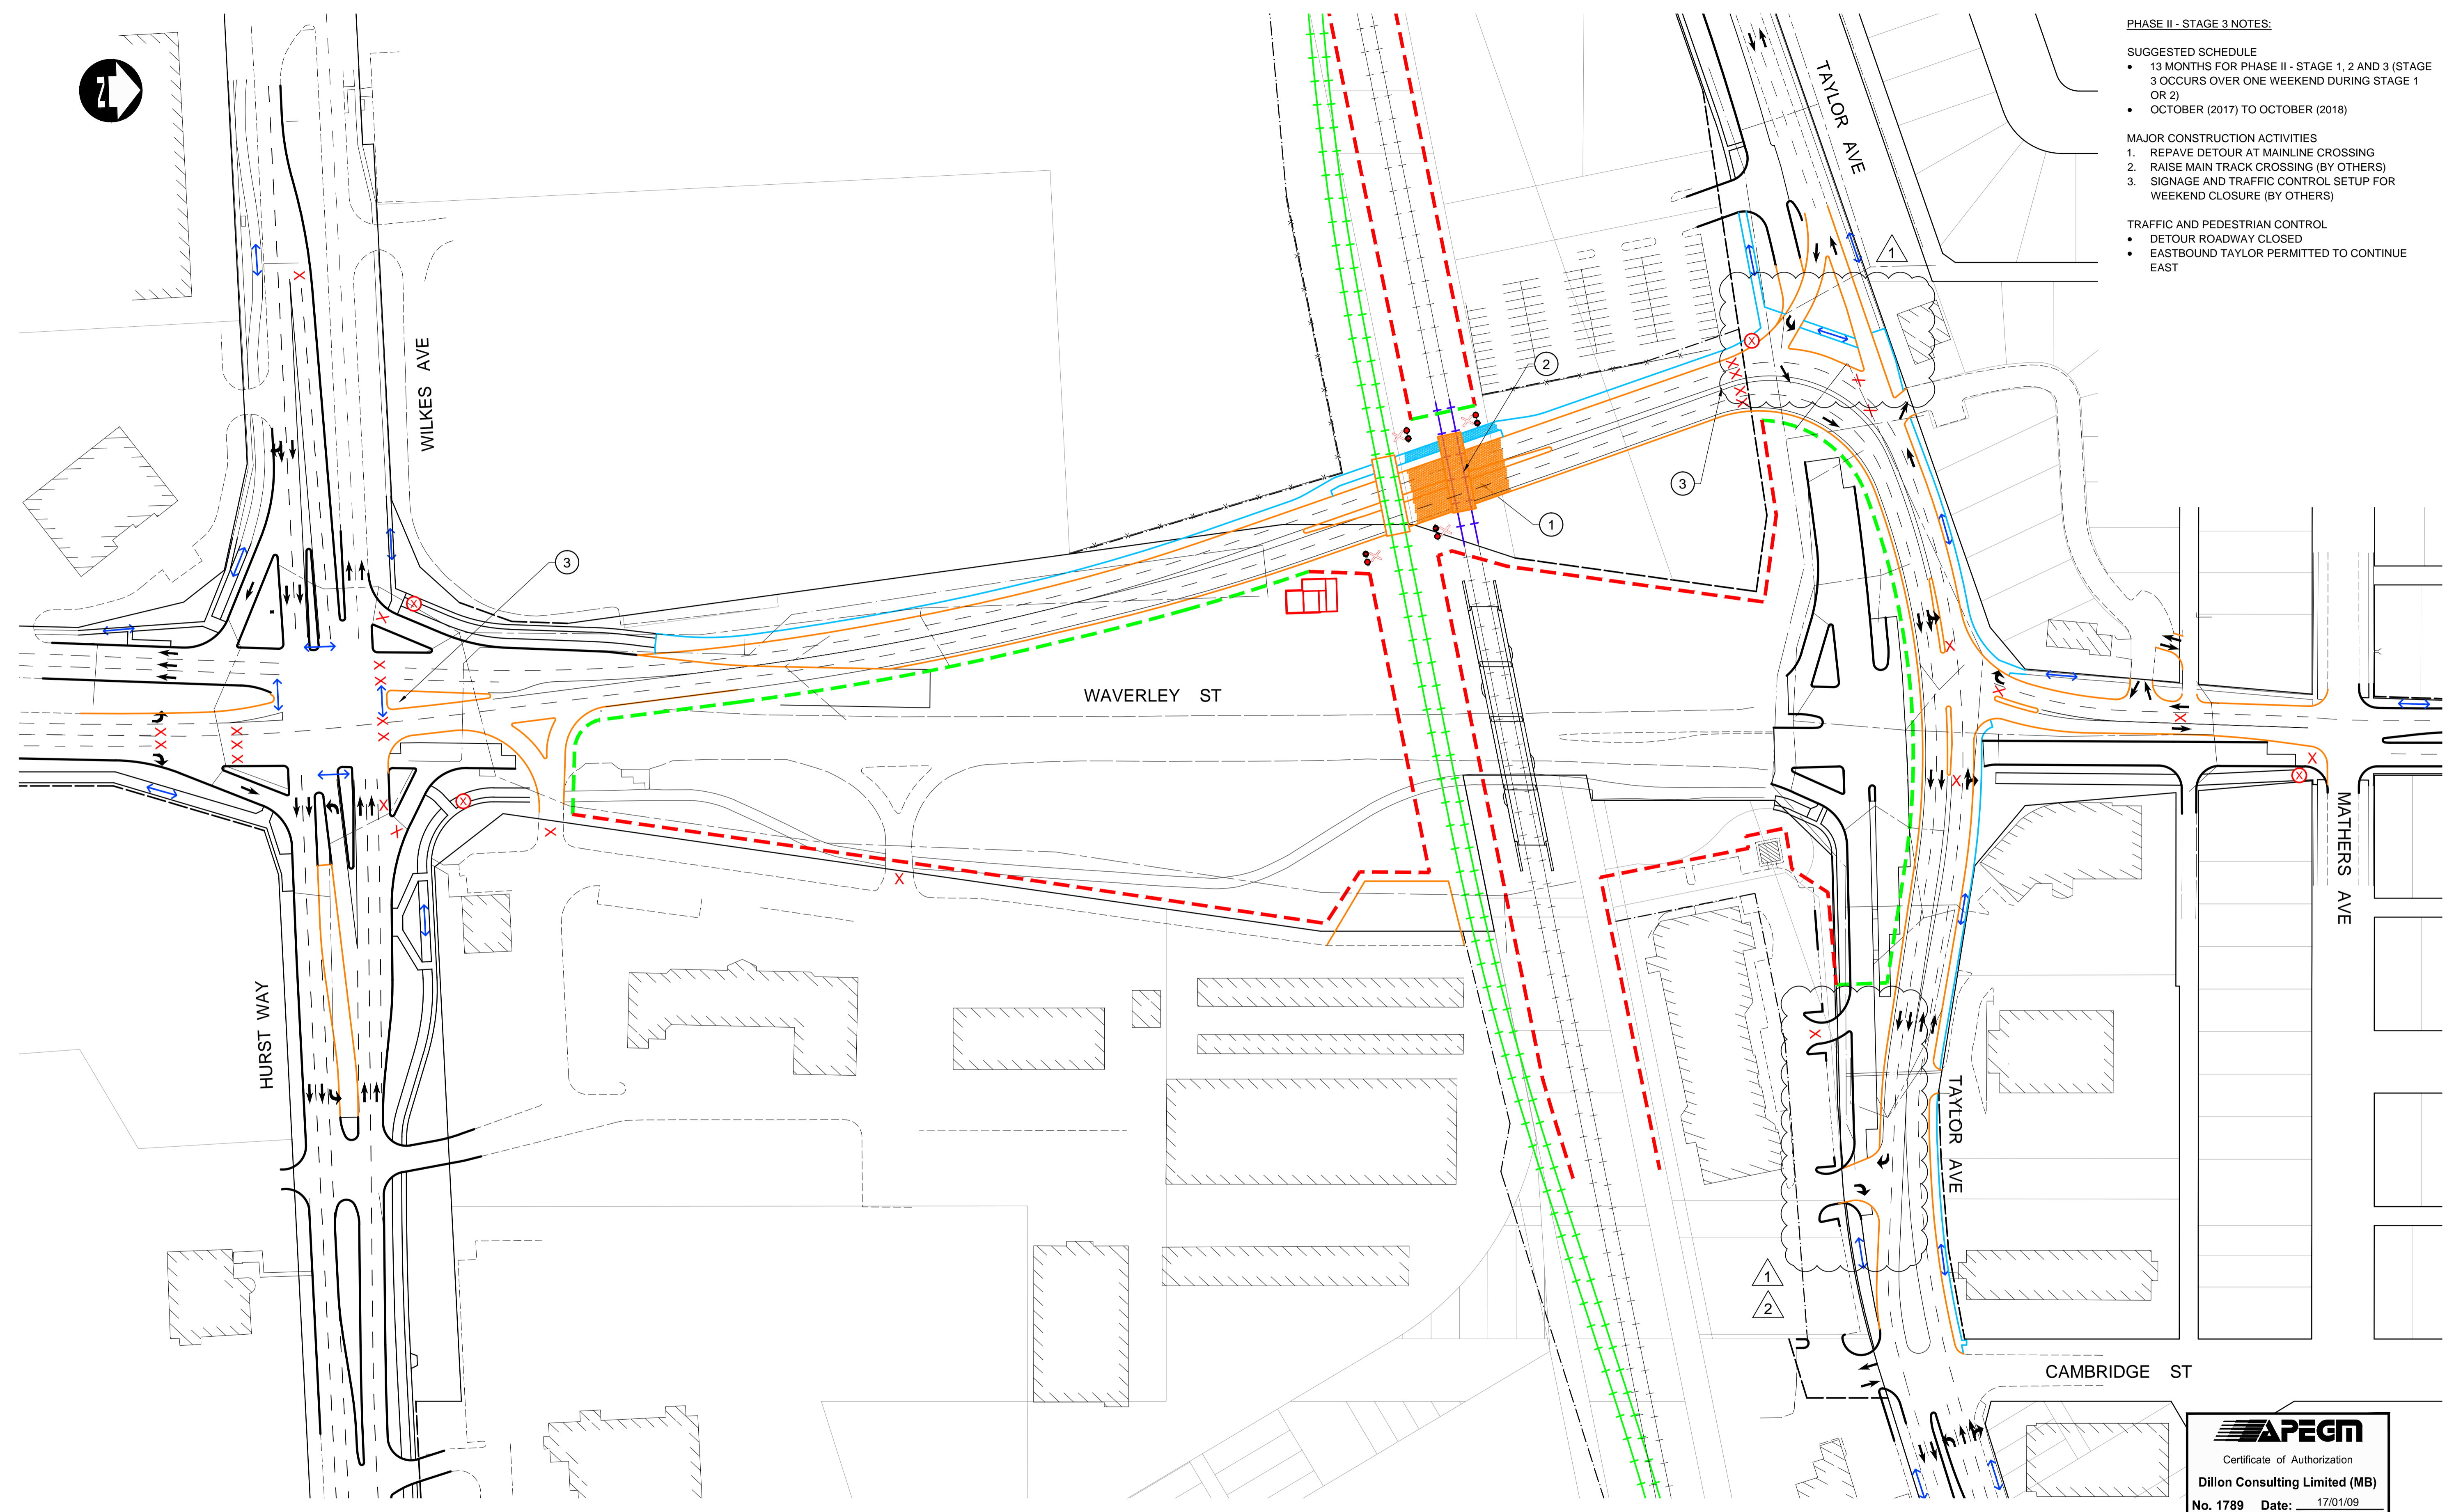

LEGEND - CONSTRUCTION STAGING

- | | | | | | |
|--|---------------------------------|--|-------------------------------------|--|----------------------------|
| | ACTIVE RAILWAY | | TEMPORARY ROADWAY CONSTRUCTION | | VEHICULAR TRAFFIC |
| | INACTIVE RAILWAY | | TEMPORARY MEDIAN CONSTRUCTION | | PEDESTRIAN/CYCLIST TRAFFIC |
| | SHOOFLY CONSTRUCTION | | PERMANENT ROADWAY CONSTRUCTION | | LANE CLOSED |
| | PERMANENT RAILWAY CONSTRUCTION | | PERMANENT MEDIAN CONSTRUCTION | | SIDEWALK CLOSED |
| | MAJOR UNDERGROUNDS CONSTRUCTION | | TEMPORARY SIDEWALK/MUP CONSTRUCTION | | TEMPORARY CROSSING SIGNALS |
| | EXISTING PROPERTY LINE | | PERMANENT SIDEWALK/MUP CONSTRUCTION | | |
| | PROPOSED PROPERTY LINE | | BRIDGE CONSTRUCTION | | |
| | CONSTRUCTION EASEMENT | | CONTRACTOR LAYDOWN AREA - ACCESS | | |
| | | | CONTRACTOR LAYDOWN AREA - NO ACCESS | | |

UNDERGROUND STRUCTURES

SUPPLY	U/G STRUCTURES	DATE

LOCATION OF UNDERGROUND STRUCTURES AS SHOWN ARE BASED ON THE BEST INFORMATION AVAILABLE. BUT NO GUARANTEE IS GIVEN THAT ALL EXISTING UTILITIES ARE SHOWN OR THAT THE GIVEN LOCATIONS ARE EXACT. CONFIRMATION OF EXISTENCE AND EXACT LOCATION OF ALL SERVICES MUST BE OBTAINED FROM THE INDIVIDUAL UTILITIES BEFORE PROCEEDING WITH CONSTRUCTION.

NO.	REVISIONS	DATE	BY	DATE
2	ADDENDUM #2	17/02/03	DBW	
1	ADDENDUM #1	17/01/25	DBW	
0	ISSUED FOR TENDER	17/01/09	DBW	

DESIGNED BY	TJH	CHECKED BY	RTP/DBW
DRAWN BY	TJH	APPROVED BY	DBW
HOR. SCALE	1:500	RELEASED FOR CONSTRUCTION	
VERTICAL		DATE	

ENGINEER'S SEAL

CONSULTANT PROJECT NUMBER
16-3353

THE CITY OF WINNIPEG
PUBLIC WORKS DEPARTMENT

WAVERLEY STREET UNDERPASS AT CN MILE 3.89 RIVERS SUB CONTRACT 2: UNDERPASS STRUCTURE, RAILWORKS, ROADWORKS, LAND DRAINAGE SEWER, PUMPING STATION AND LANDSCAPING WORKS

CONSTRUCTION STAGING
PHASE II - STAGE 3 (1 OF 1)

CITY DRAWING NUMBER
U-239-2016-C2-GE-041

SHEET
041 OF 052

CONSULTANT DRAWING NUMBER
C2-GE-041

G:\CAD\163353\Technical Workspace\Engineering\Drawings and Figures\Roadworks\Contract\163353-C2-CON-GE-STAGE-2.3.dwg