
## **BID OPPORTUNITY 261-2017** SEWER ASSET: S-MA70019746 (BARKER BLVD) **BARKER PUMPING STATION MODIFICATIONS**

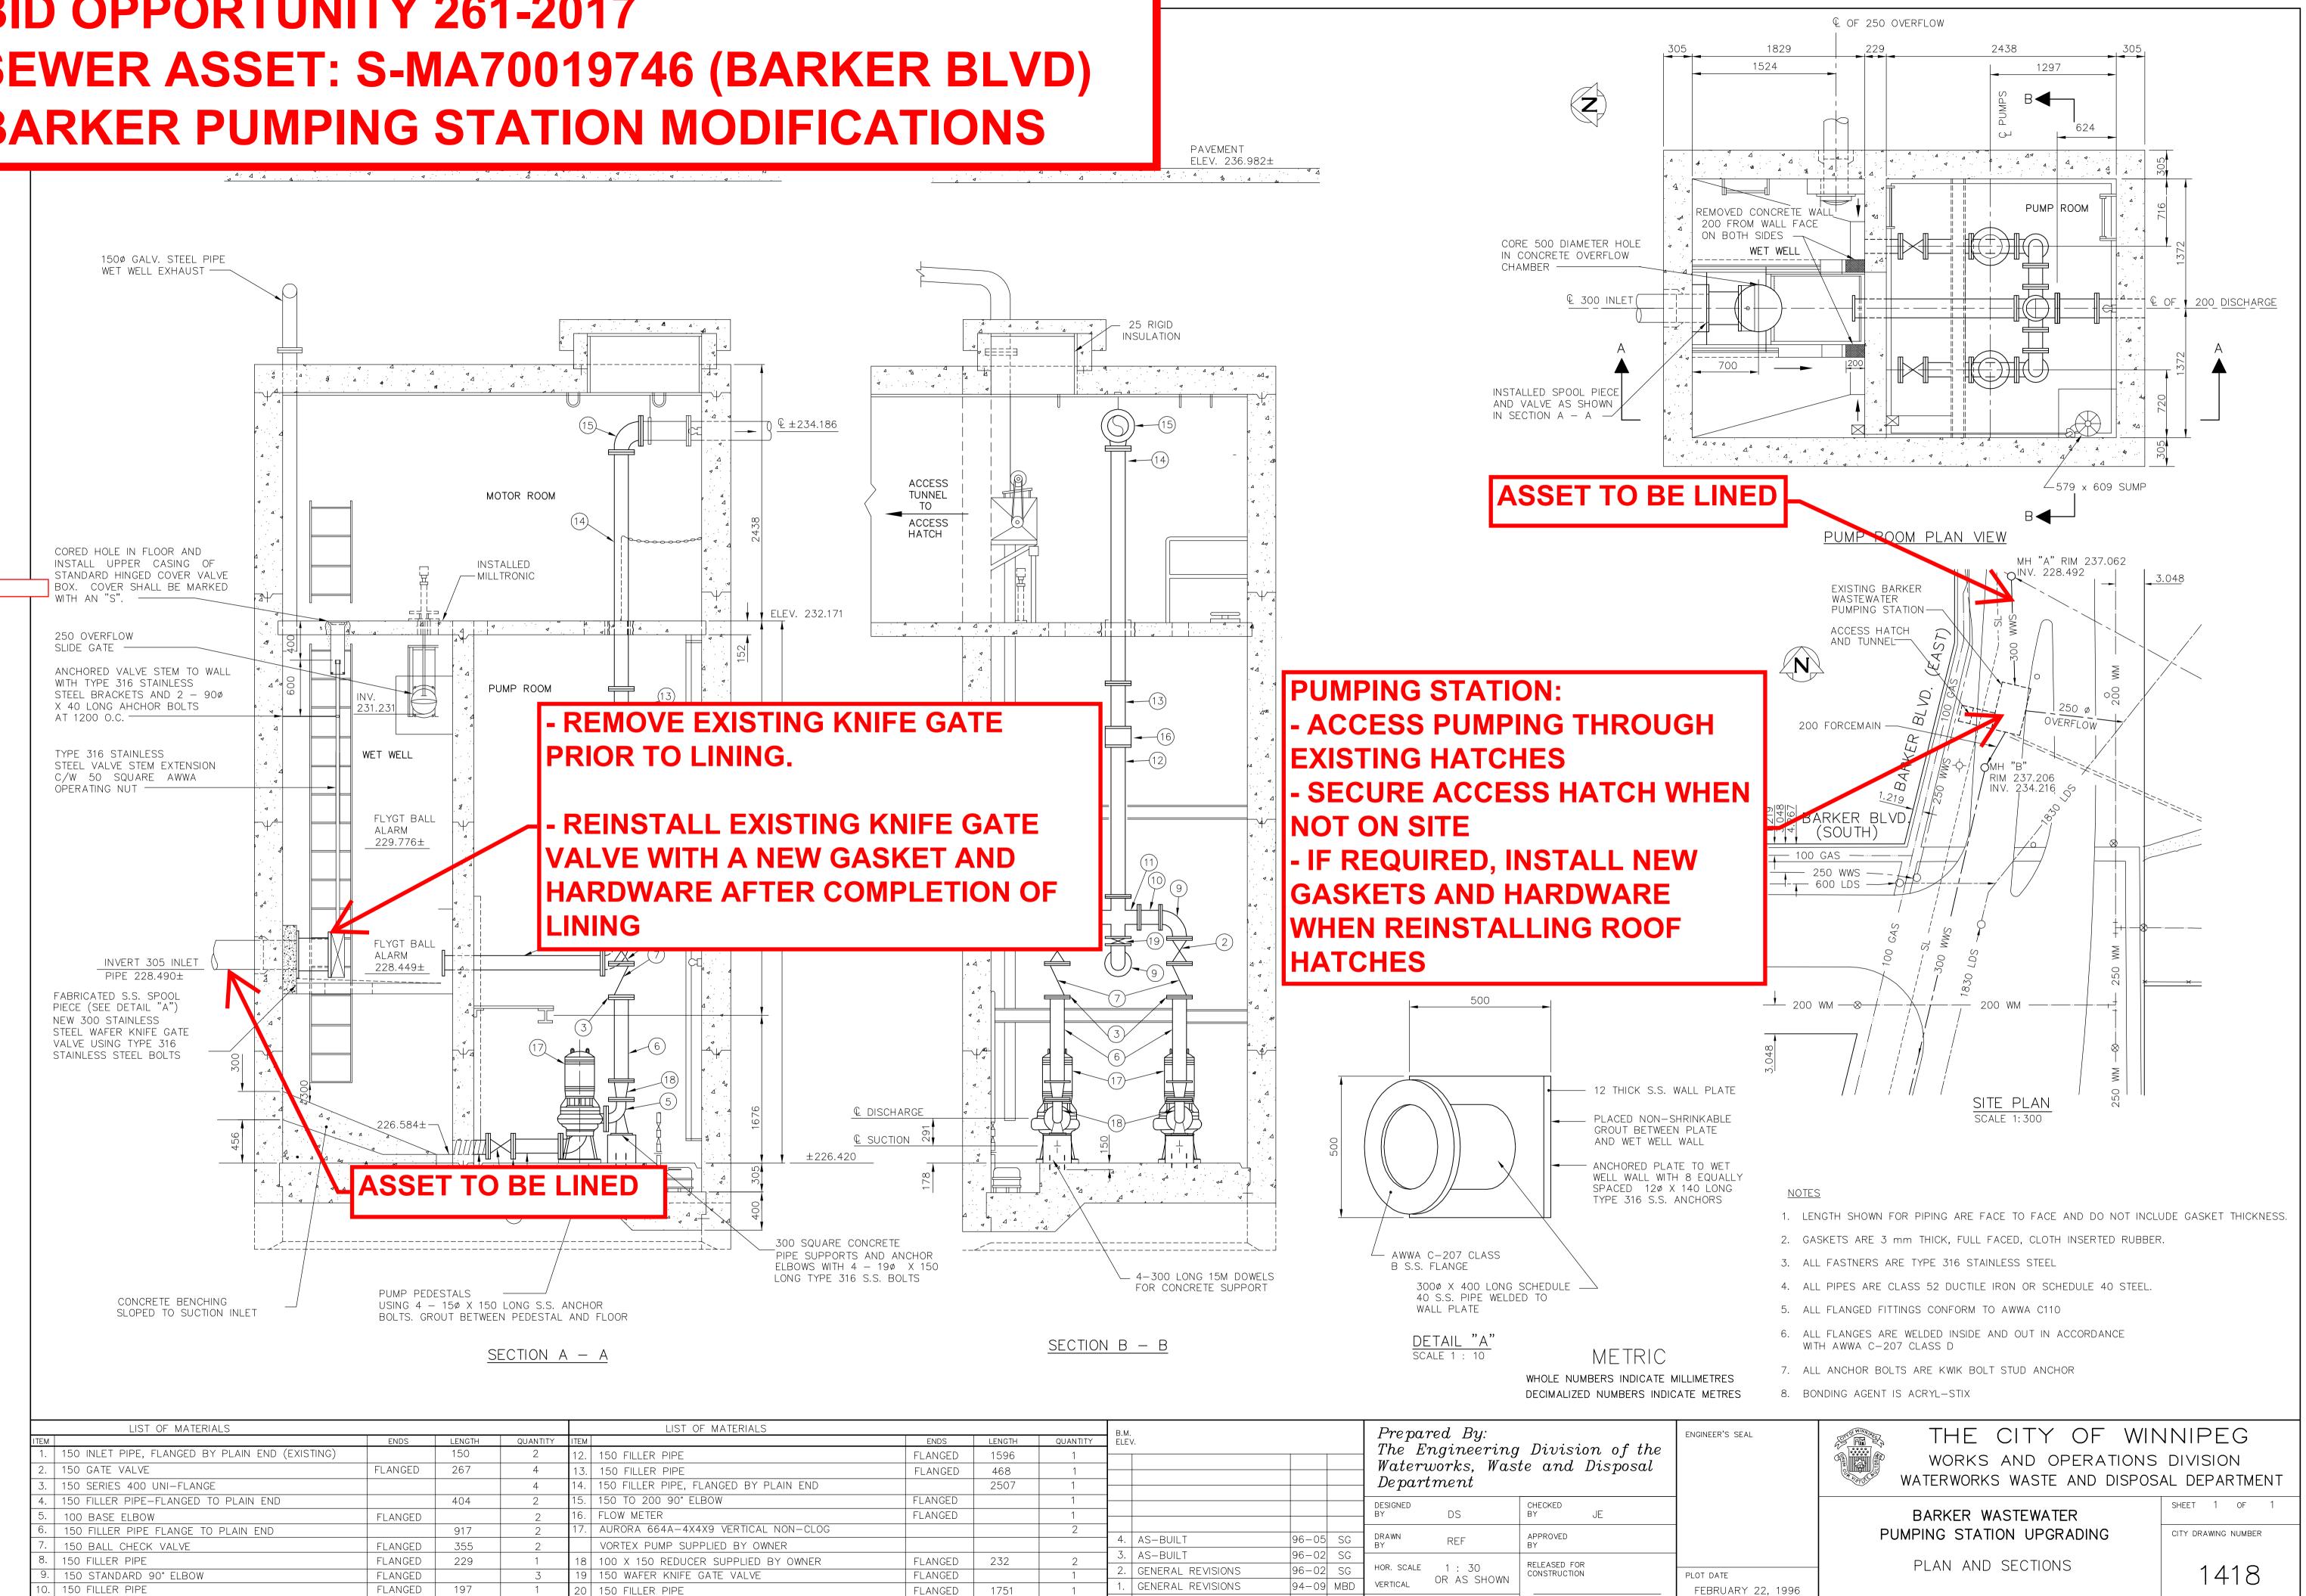

LIST OF MATERIALS				LIST OF MATERIALS			ВМ		Prepared By:		ENGINEER'S SEAL	
ITEM	ENDS	LENGTH	QUANTITY	ITEM	ENDS	LENGTH	QUANTITY	ELEV.				
1. 150 INLET PIPE, FLANGED BY	PLAIN END (EXISTING)	150	2	12. 150 FILLER PIPE	FLANGED	1596	1				ng Division of the	
2. 150 GATE VALVE	FLANGED	267	4	13. 150 FILLER PIPE	FLANGED	468	1				iste and Disposal	
3. 150 SERIES 400 UNI-FLANGE			4	14. 150 FILLER PIPE, FLANGED BY PLAIN END		2507	1			Department		
4. 150 FILLER PIPE-FLANGED TO	PLAIN END	404	2	15. 150 TO 200 90° ELBOW	FLANGED		1	]		DESIGNED	CHECKED	_
5. 100 BASE ELBOW	FLANGED		2	16. FLOW METER	FLANGED		1			BY DS	BY JE	
6. 150 FILLER PIPE FLANGE TO F	PLAIN END	917	2	17. AURORA 664A-4X4X9 VERTICAL NON-CLOG			2			DRAWN	APPROVED	_
7. 150 BALL CHECK VALVE	FLANGED	355	2	VORTEX PUMP SUPPLIED BY OWNER				4. AS-BUILT	90-03 30	BY REF	BY	
8. 150 FILLER PIPE	FLANGED	229	1	18 100 X 150 REDUCER SUPPLIED BY OWNER	FLANGED	232	2	3. AS-BUILT	96-02 SG		RELEASED FOR	
9. 150 STANDARD 90° ELBOW	FLANGED		3	19 150 WAFER KNIFE GATE VALVE	FLANGED		1	2. GENERAL REVISIONS	96-02 SG	HOR. SCALE 1 : 30	RELEASED FOR CONSTRUCTION	PLOT DATE
10. 150 FILLER PIPE	FLANGED	197	1	20 150 FILLER PIPE	FLANGED	1751	1	1. GENERAL REVISIONS	94-09 MBD	VERTICAL OR AS SHOW	`	FEBRUARY 22
11. 150x150x150 CAST IRON CROS	S FLANGED	464	1					NO. REVISIONS	DATE BY	DATE	DATE	

T:\WASTEWTR\SEWPUMP\1418.DWG

