


B SIZE 11" X 17" (279mm x 432mm)

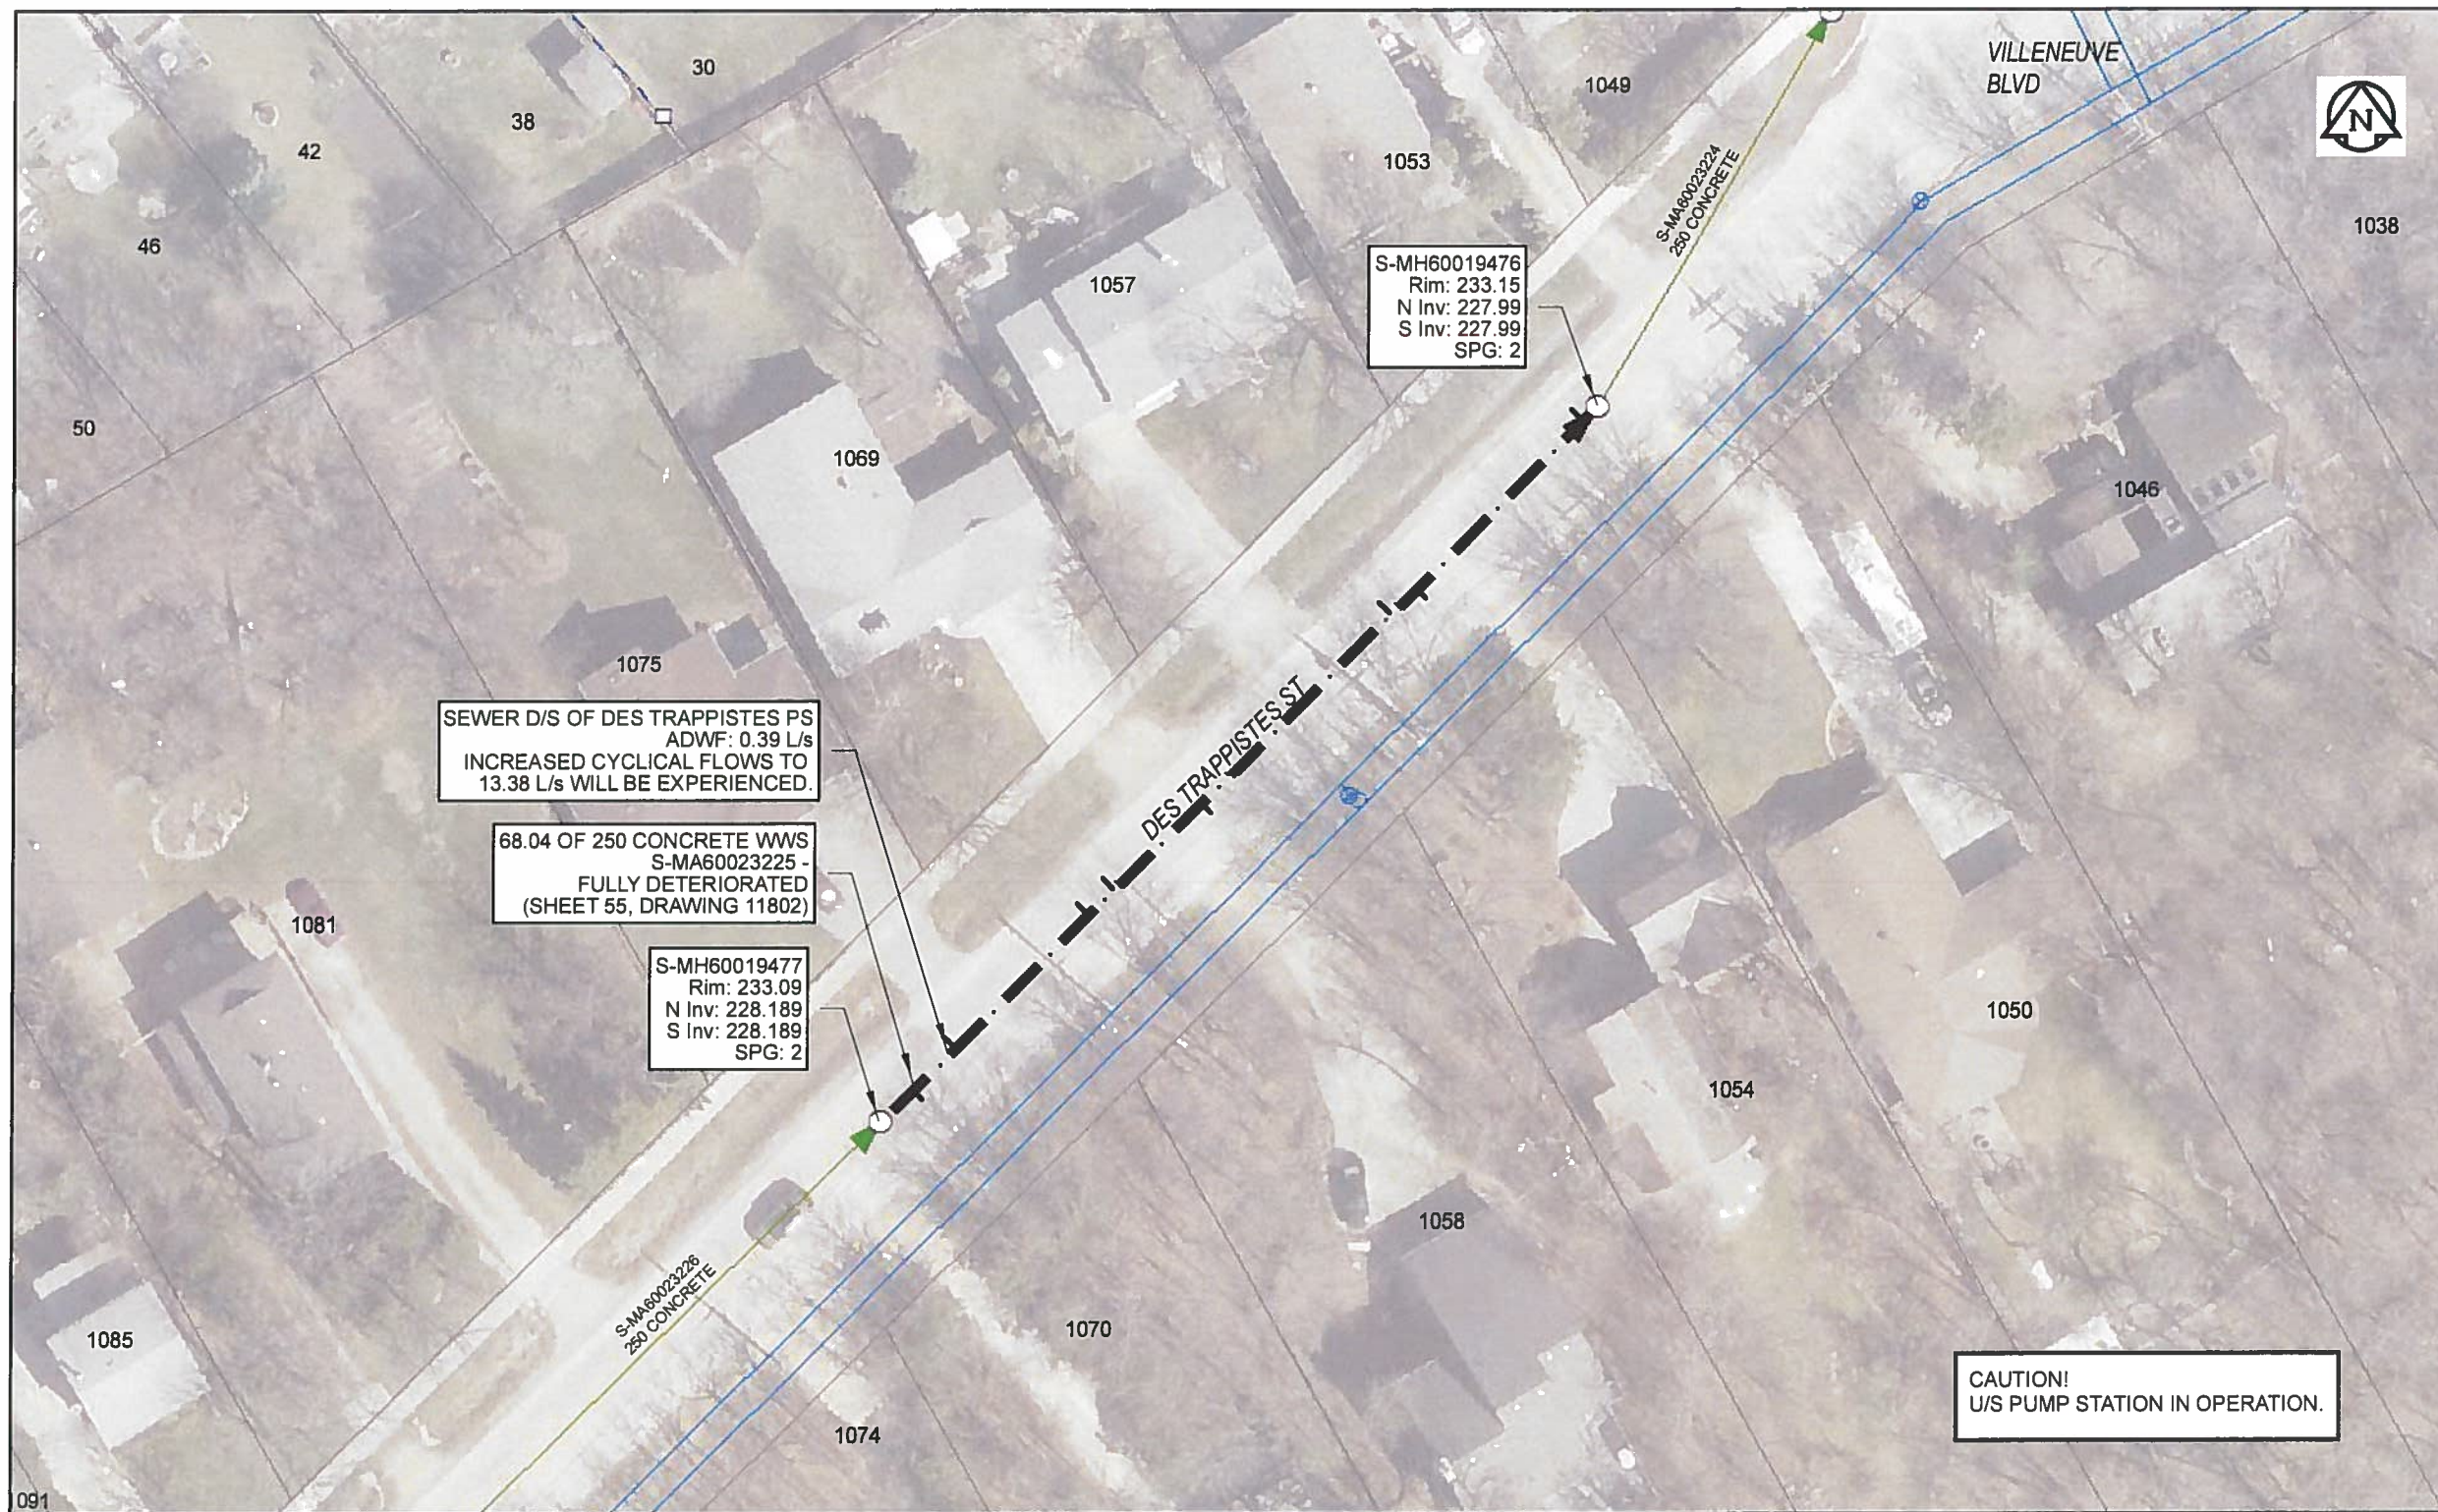

**Sewer Junction Information**

(From Video Inspection)

Reference MH	Distance	Size	Clock
S-MH60019477	003.1	150	02
-	007.1	150	11
-	019.7	150	11
-	022.1	150	11
-	030.3	150	01
-	048.2	150	11
-	050.6	150	01
-	066.5	150	11

**Traffic Controls**  
 Regional Street Lane Closure Required: No  
 Impacted Regional Street: N/A

**General Requirements:**  
 Residential Street Restrictions

**WARNING**

IF POWER EQUIPMENT OR EXPLOSIVES ARE TO BE USED FOR EXCAVATION ON THIS PROJECT, THE CONTRACTOR MUST:  
 1) NOTIFY THE GAS COMPANY OF THE PROPOSED LOCATION OF EXCAVATION.  
 2) TAKE PRECAUTION TO AVOID DAMAGE TO GAS COMPANY INSTALLATIONS.  
 SEE PROVINCIAL REGULATION 140/92 FOR DETAILS



Certificate of Authorization

AECOM Canada Ltd.

No. 4671 Date: *May 24/18*

**METRIC**

WHOLE NUMBERS INDICATE MILLIMETRES  
 DECIMALIZED NUMBERS INDICATE METRES

0 2.5 5 10 15 20

Meters

**RECORD DRAWING**

BID OPPORTUNITY NO. 224-2018

CAUTION!  
 U/S PUMP STATION IN OPERATION.

AECOM REVIEW DRAFT CHK

FILE NAME: 2017 Lining.mxd SAVED BY: ES

**LOCATION APPROVED UNDERGROUND STRUCTURES**

SUPR. U/G STRUCTURES COMMITTEE DATE

**NOTE:**  
 LOCATION OF UNDERGROUND STRUCTURES AS SHOWN ARE BASED ON THE BEST INFORMATION AVAILABLE. BUT NO GUARANTEE IS GIVEN THAT ALL EXISTING UTILITIES ARE SHOWN OR THAT THE GIVEN LOCATIONS ARE EXACT. CONFIRMATION OF EXISTENCE AND EXACT LOCATION OF ALL SERVICES MUST BE OBTAINED FROM THE INDIVIDUAL UTILITIES BEFORE PROCEEDING WITH CONSTRUCTION.

NO.	ISSUED FOR CONSTRUCTION	18/05/24	ES
NO.	REVISIONS	YY/MM/DD	BY

**AECOM**

DESIGNED BY	NK	CHECKED BY	<i>[Signature]</i>
DRAWN BY	ES	APPROVED BY	<i>[Signature]</i>
HOR. SCALE	1:500	RELEASED FOR CONSTRUCTION	<i>[Signature]</i>
VERT. SCALE	N/A	DATE	<i>May 24/18</i>

PROFESSIONAL'S SEAL

CONSULTANT DRAWING NO.  
 60561478-01-C-2017 Lining-RGX.mxd

**THE CITY OF WINNIPEG WATER AND WASTE DEPARTMENT**

2017 SEWER RENEWALS  
 BY CIPP LINING  
 CONTRACT 4  
 S-MA60023225  
 DES TRAPPISTES ST  
 1ST MH W OF VILLENEUVE BLVD TO 2ND MH W OF VILLENEUVE BLVD

SHEET 55 OF 59  
 CITY DRAWING NUMBER  
**11802** REV 0