
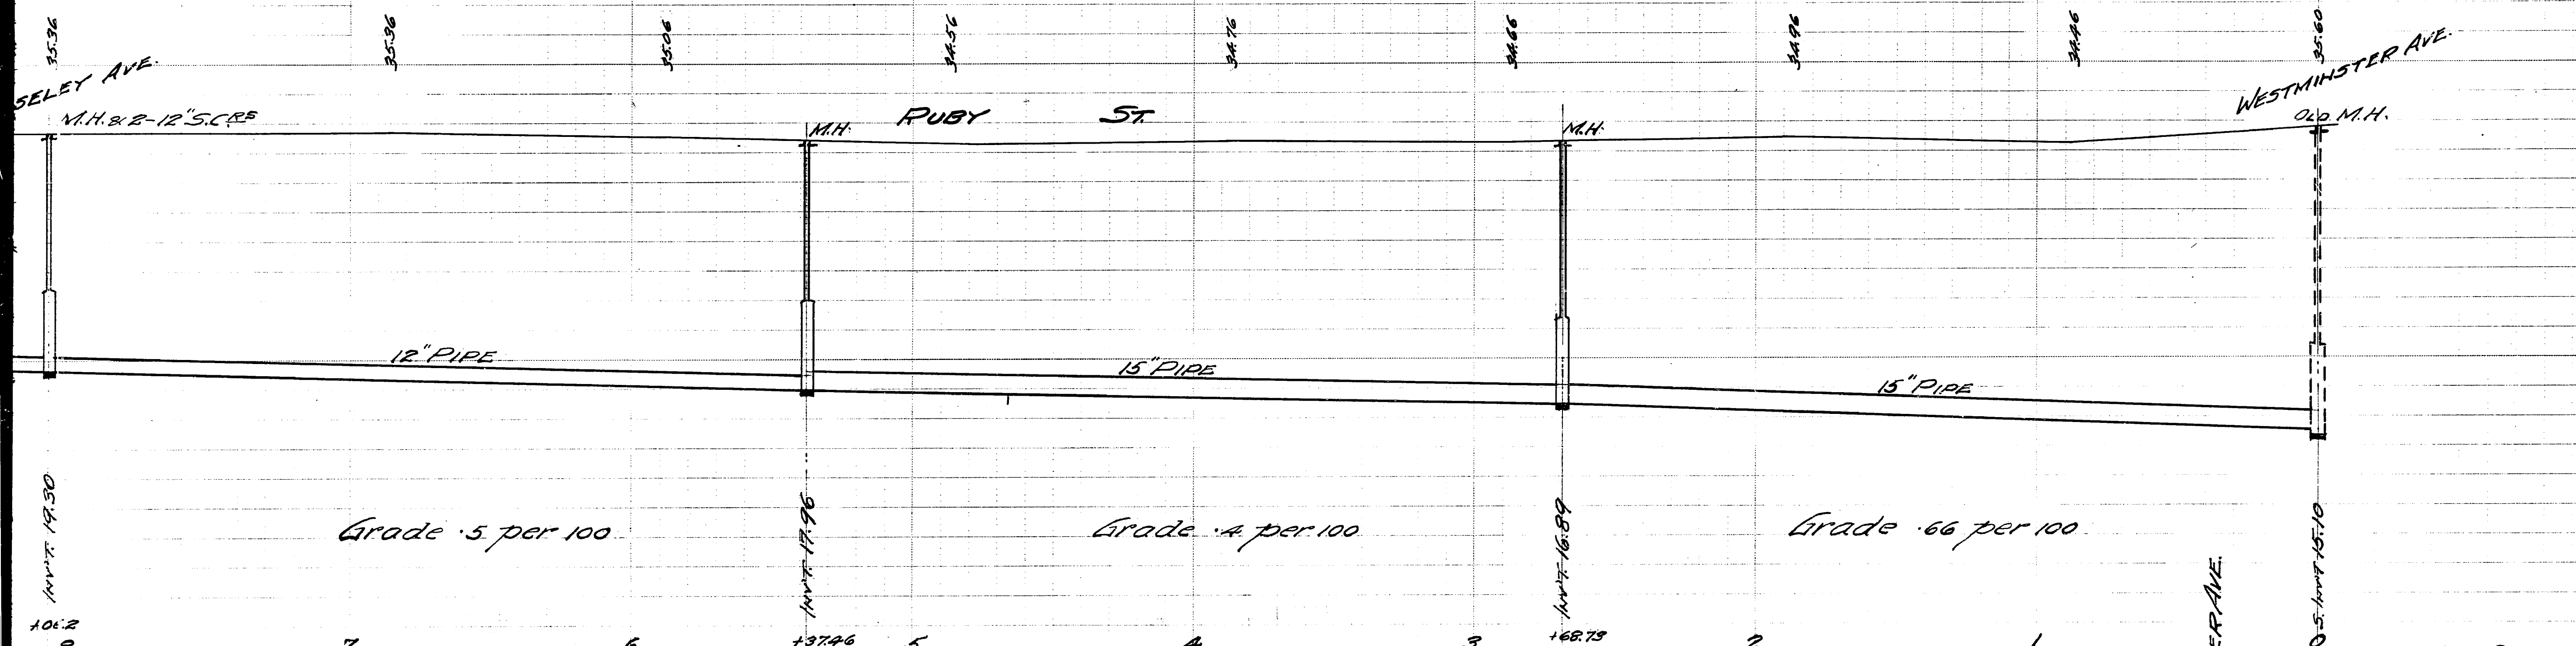


APPENDIX D


REFERENCE DRAWINGS

B.M. 35.60 Nail in W.E. Ry Co. Pole N.W. Cor. Buell & Leamore Sts.
Book 203 Page 55.

Plotted
Q 10.11.12
H.T.

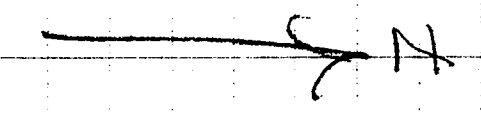


106.2	7	6	5	4	3	2	1	0
19.50			17.96		16.89			15.10
	Grade .5 per 100			Grade .4 per 100			Grade .66 per 100	

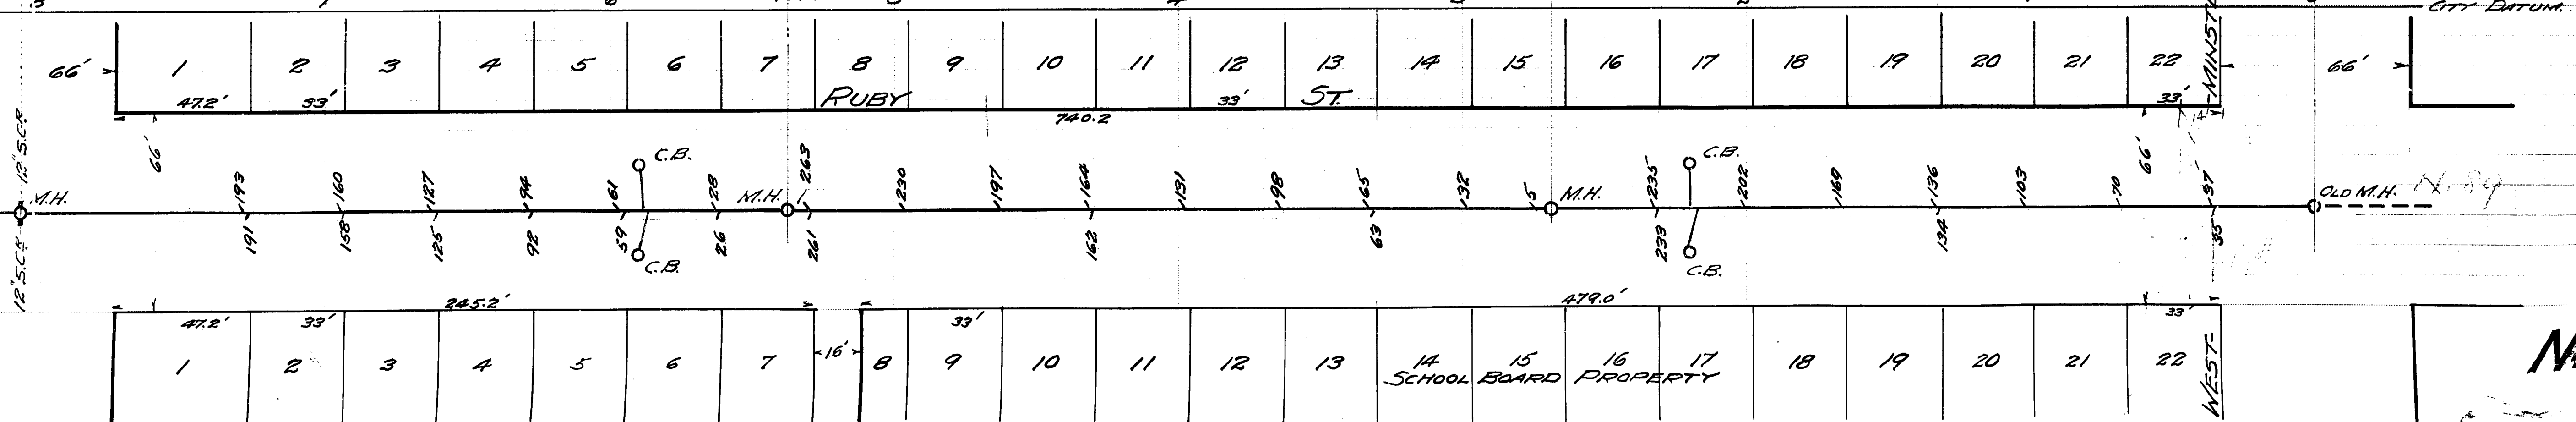

SCHOOL BOARD PROPERTY

N 89

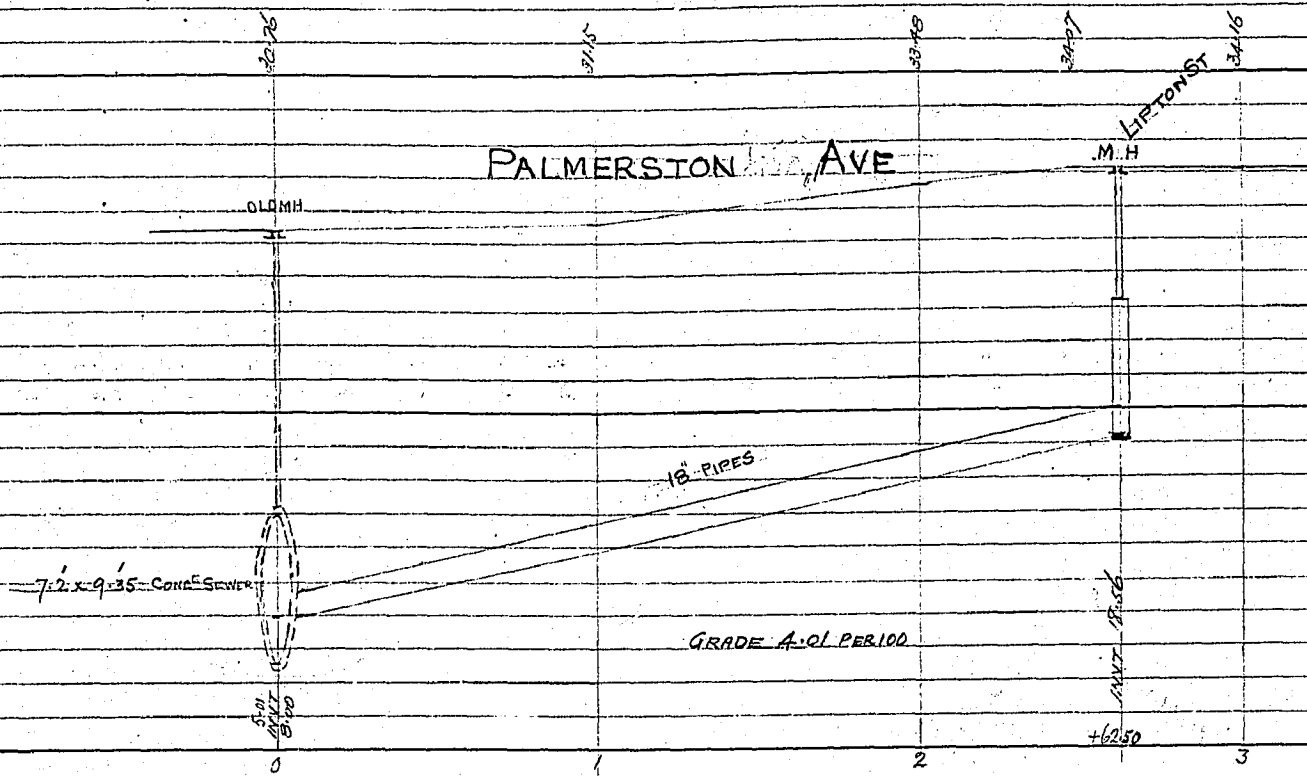

$$\begin{array}{r} 262.5 \\ 41.81 \\ \hline 262.5 \\ 105.000 \\ \hline 105.2625 \end{array}$$

$$\begin{array}{r} 18.56 \\ 10.83 \\ \hline 9.73 \end{array}$$


 18.56
 10.83
 9.73

PLAN 5602 TUBE 501
 S.M. 236 PAGE 15
 S.L. 127 PAGE 63
 INSPECTOR 1086
 B.M. 32.14 NAIL IN NW CORNER HENHOUST
 E OF AUBREY SEWER OUTLET
 Aug 17 1912

FORMERLY IDA
SEWER PALMERSTON AVE
 LIPTON TO AUBREY ST

SCALES HOR 40' }
 VER 8 1/2" } INCH

LOCATION OF UNDERGROUND STRUCTURES AS SHOWN
 ARE BASED ON BEST INFORMATION AVAILABLE, BUT
 NO GUARANTEE IS GIVEN THAT ALL EXISTING
 UTILITIES ARE SHOWN AND EXACT LOCATIONS OF
 ALL UNDERGROUND INCLUDING SERVICE CONNECTIONS
 MUST BE CHECKED WITH THE UTILITY CONCERNED
 BEFORE PROCEEDING WITH CONSTRUCTION.

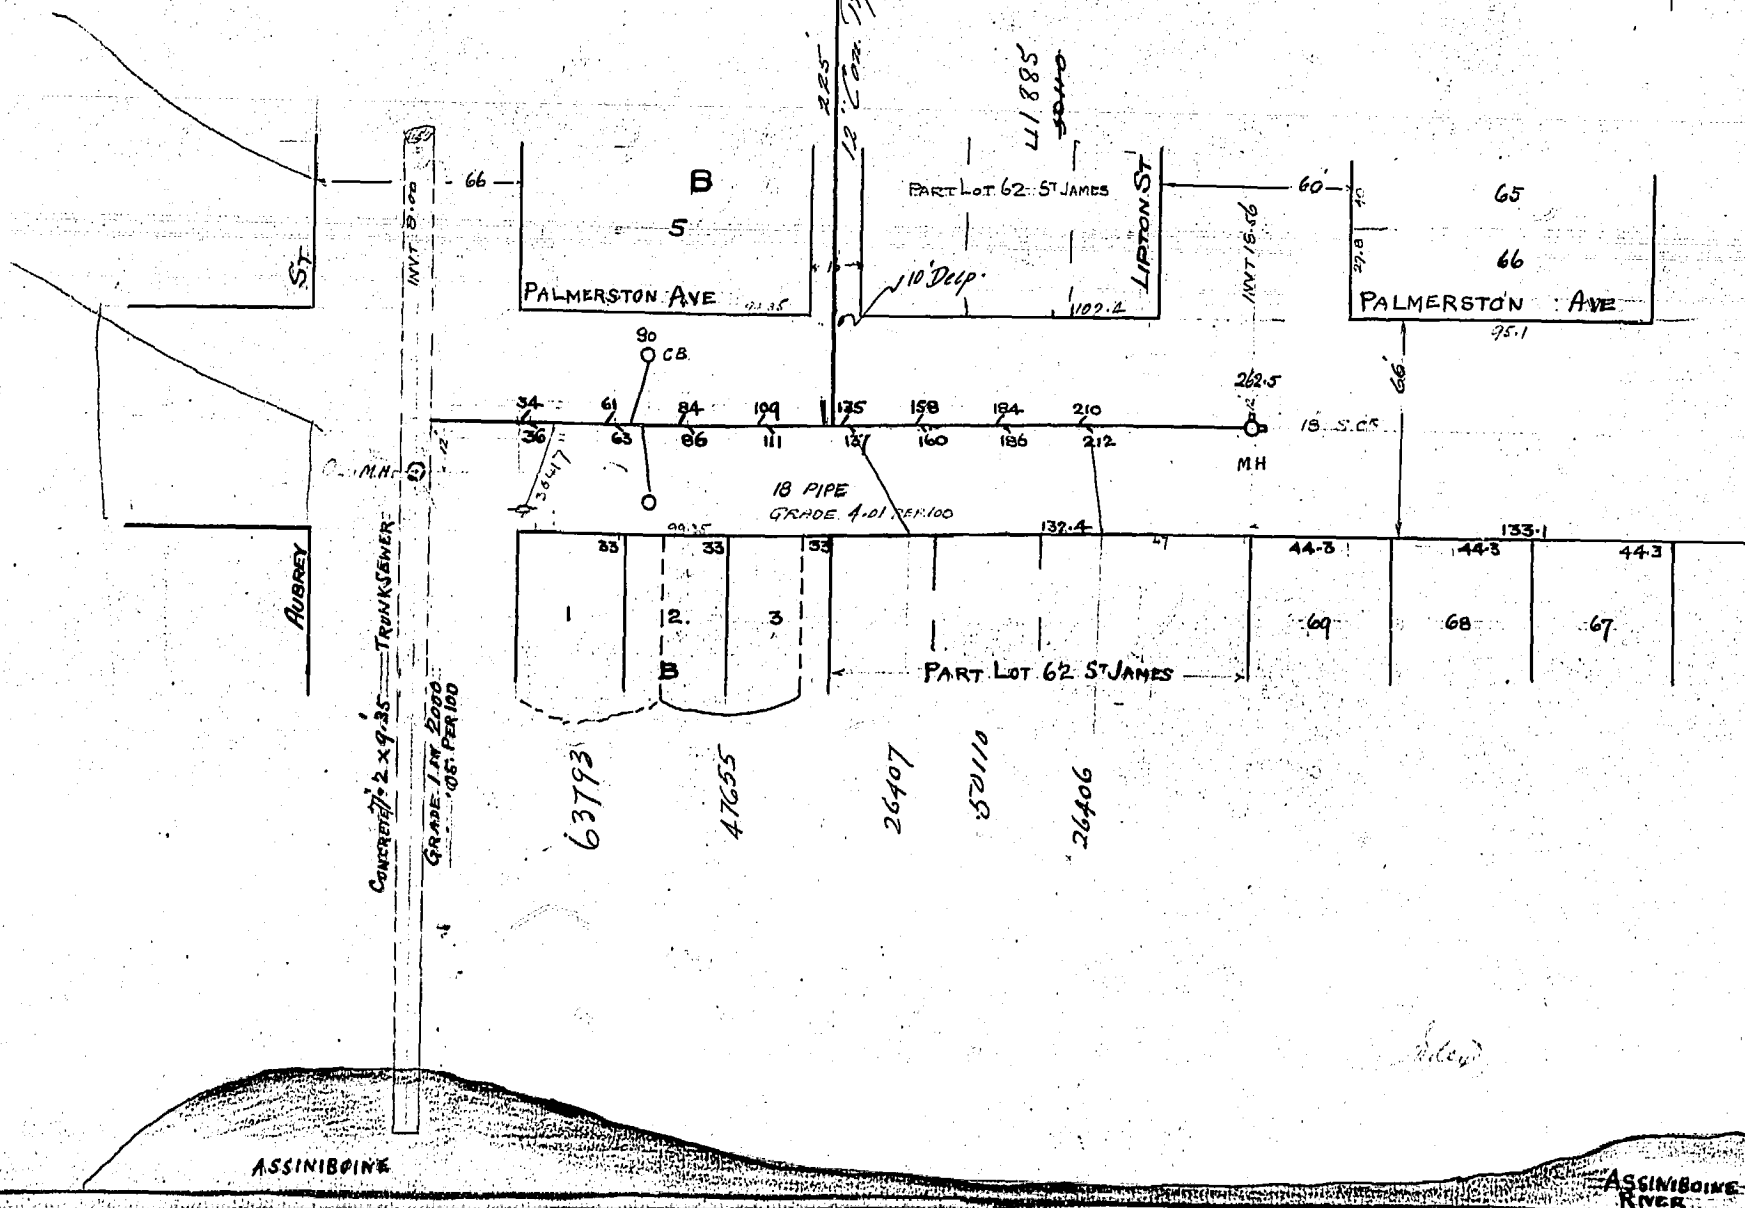

LOCATION OF UNDERGROUND STRUCTURES AS SHOWN ARE BASED ON BEST INFORMATION AVAILABLE, BUT NO GUARANTEE IS GIVEN THAT ALL EXISTING UTILITIES ARE SHOWN AND EXACT LOCATIONS OF ALL UNDERGROUND INCLUDING SERVICE CONNECTIONS MUST BE CHECKED WITH THE UTILITY CONCERNED BEFORE PROCEEDING WITH CONSTRUCTION.

Inspectors Book 1719
 Field Book 420
 Page 43
 March 9th 1932
 Scale 1" = 40'-0"

SHERBURN ST.

MR. AUBREY ST.

PALMERSTON AVE.
 184.95

66

old M.H.
 Inv. 24.12

New 12" Sewer
 12" Pipe Sewer


F.B. 461
 P. 46


AVE.

C.B.

Inv. 25.04

50	50	50	50	50	50	38.25				
6	5	4	3	2	1		44587	44583	2	3
									4	

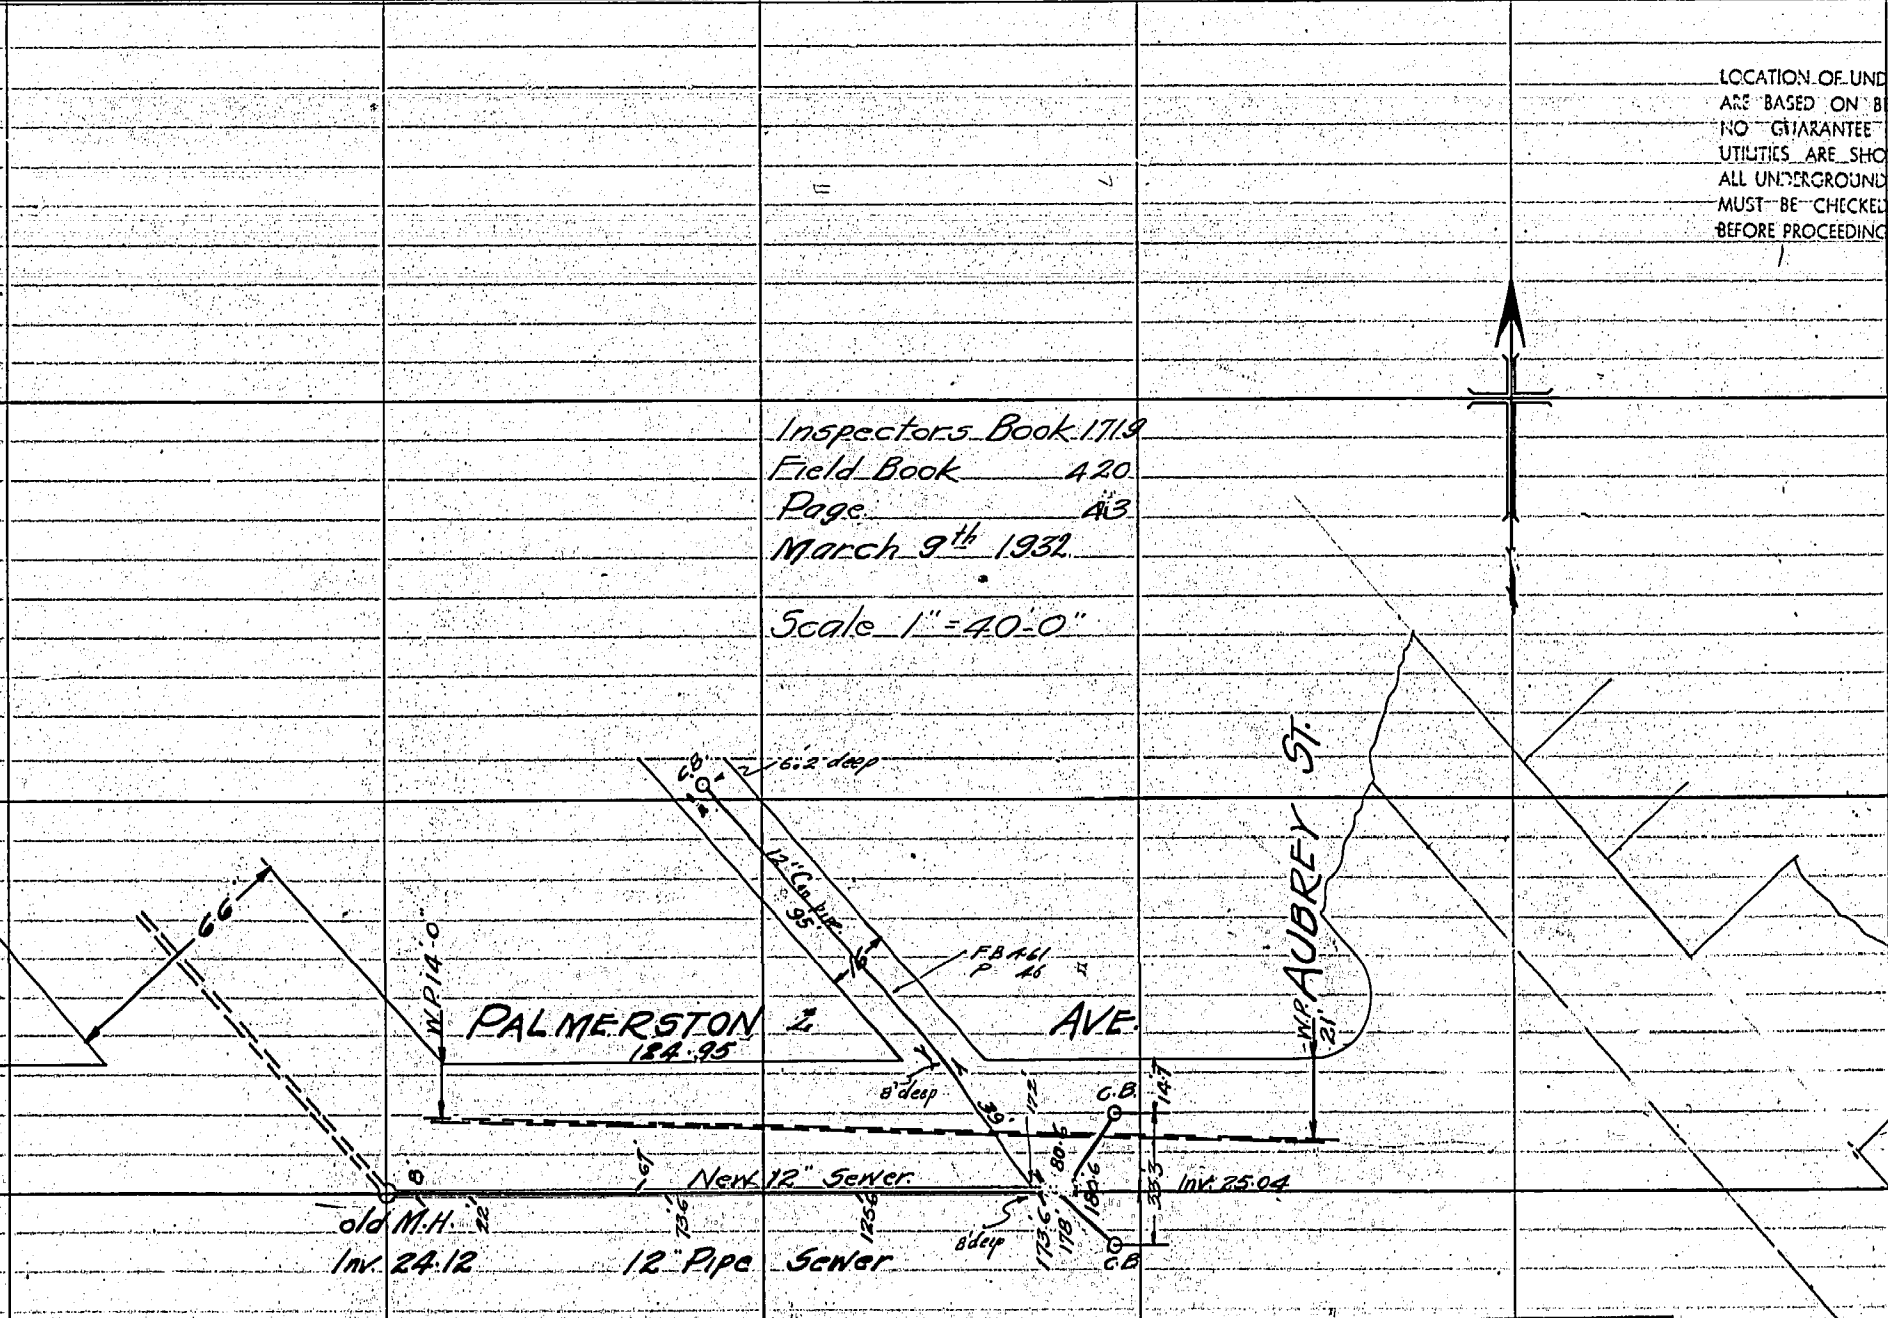

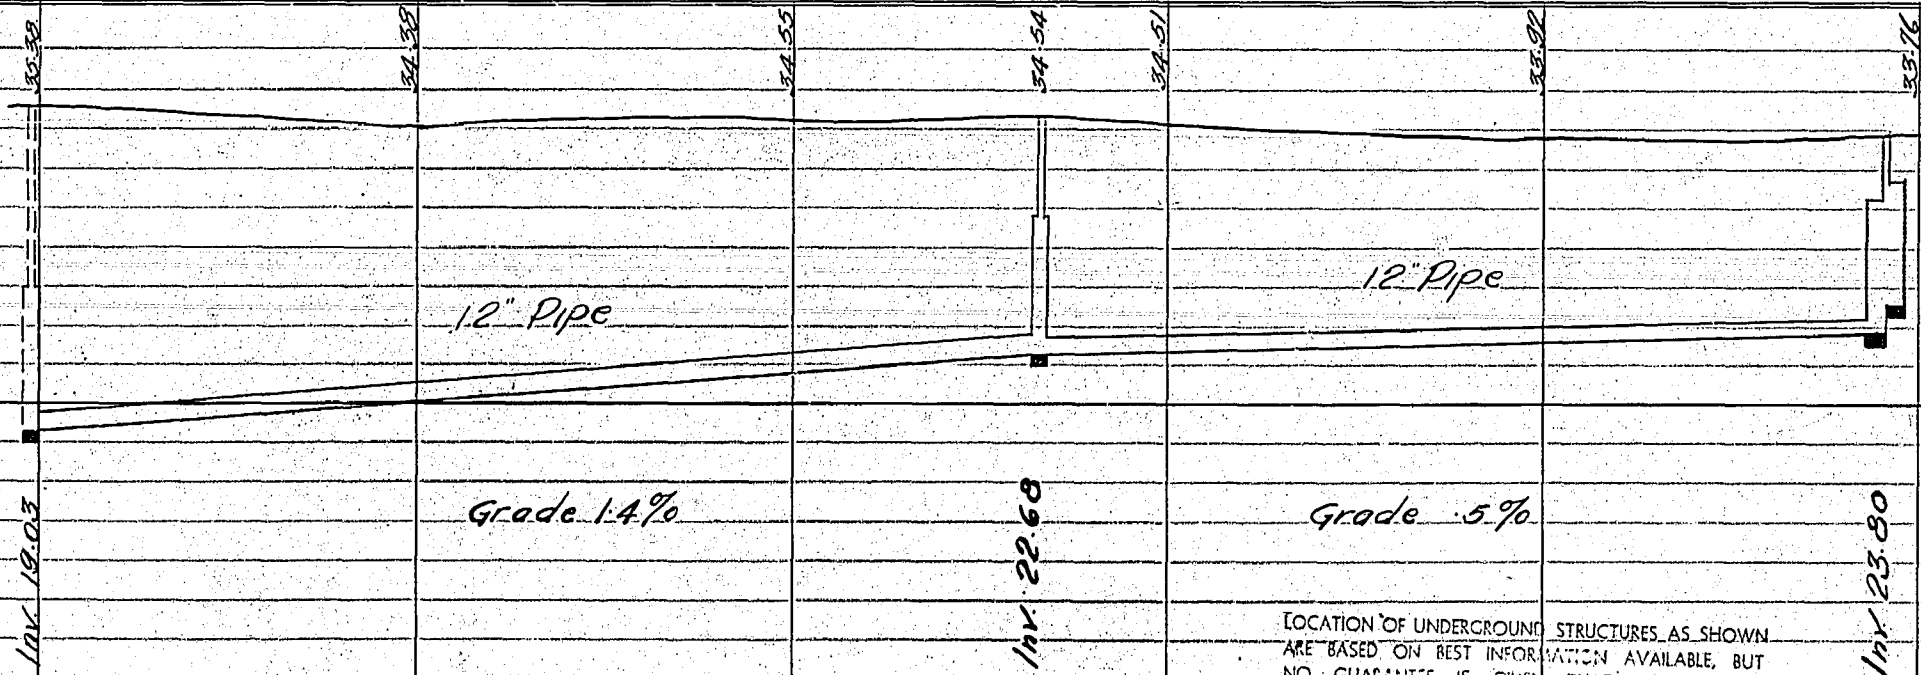

Grade 1.4%

Grade 5%

LOCATION OF UNDERGROUND STRUCTURES AS SHOWN ARE BASED ON BEST INFORMATION AVAILABLE, BUT NO GUARANTEE IS GIVEN THAT ALL EXISTING UTILITIES ARE SHOWN AND EXACT LOCATIONS OF ALL UNDERGROUND INCLUDING SERVICE CONNECTIONS MUST BE CHECKED WITH THE UTILITY CONCERNED BEFORE PROCEEDING WITH CONSTRUCTION.

Inspectors Book 1725
 Field Book 420
 Page 47
 March 11th 1938

scales 1" = 8'0" Vert
 1" = 40'0" Hor

DATUM 0+00


LIPTON ST

RUBY ST


LENORE ST


LAURA SECORD SCHOOL

PALMERSTON AVE

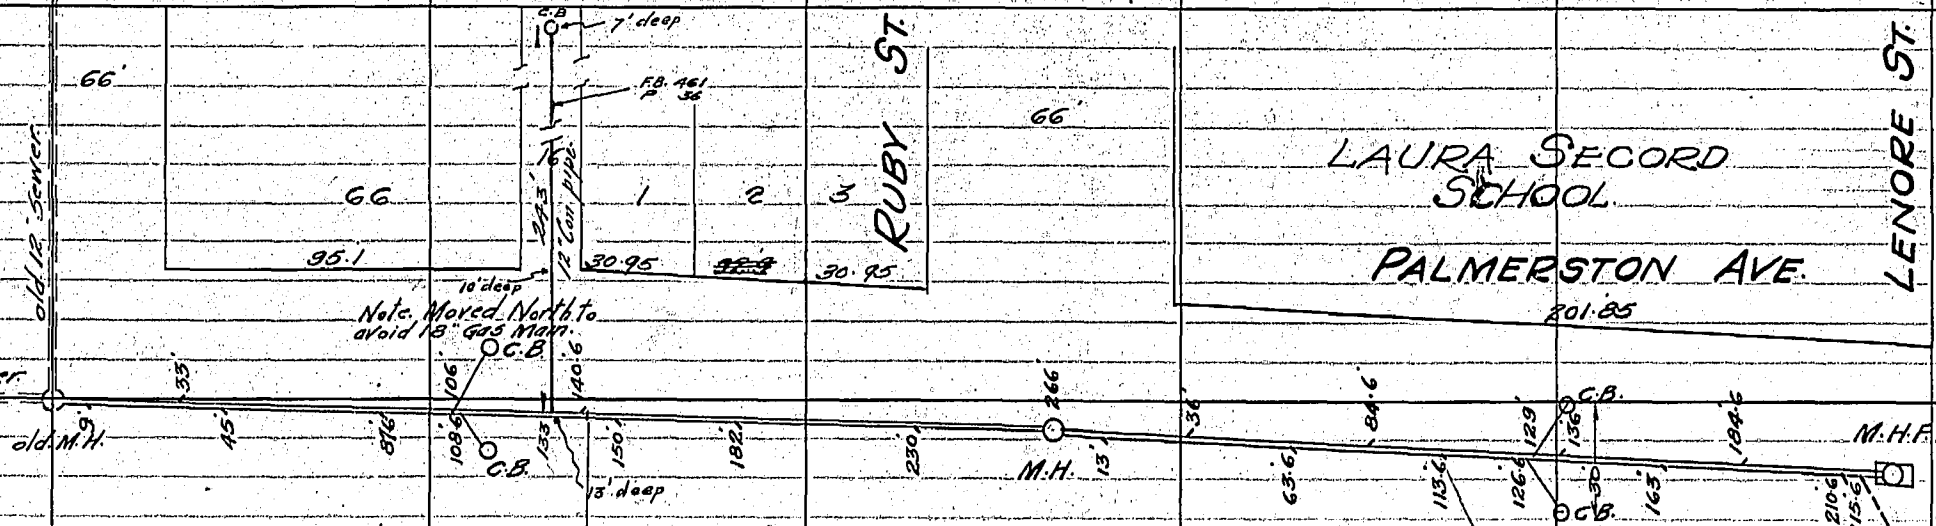

Note: Moved North to avoid 18" Gas Main

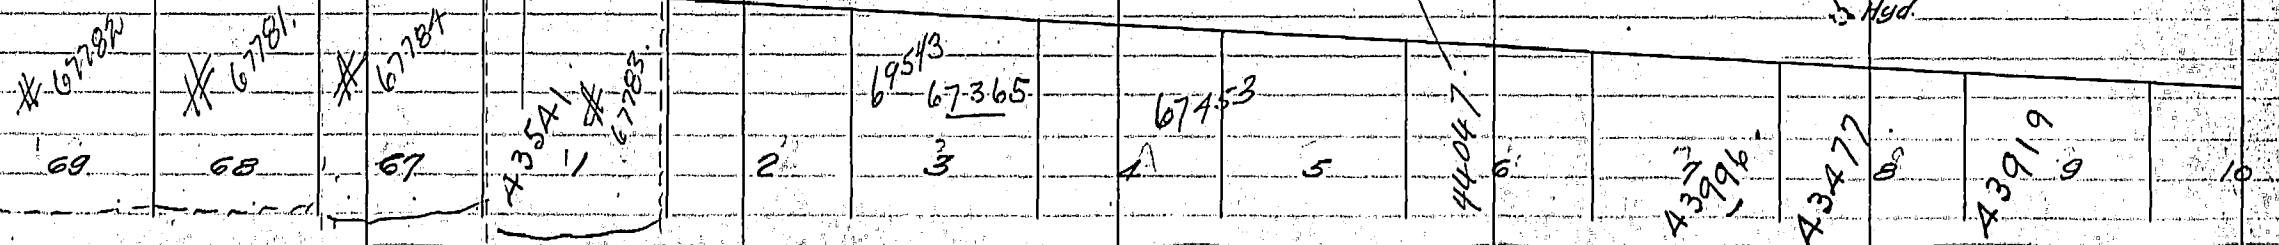

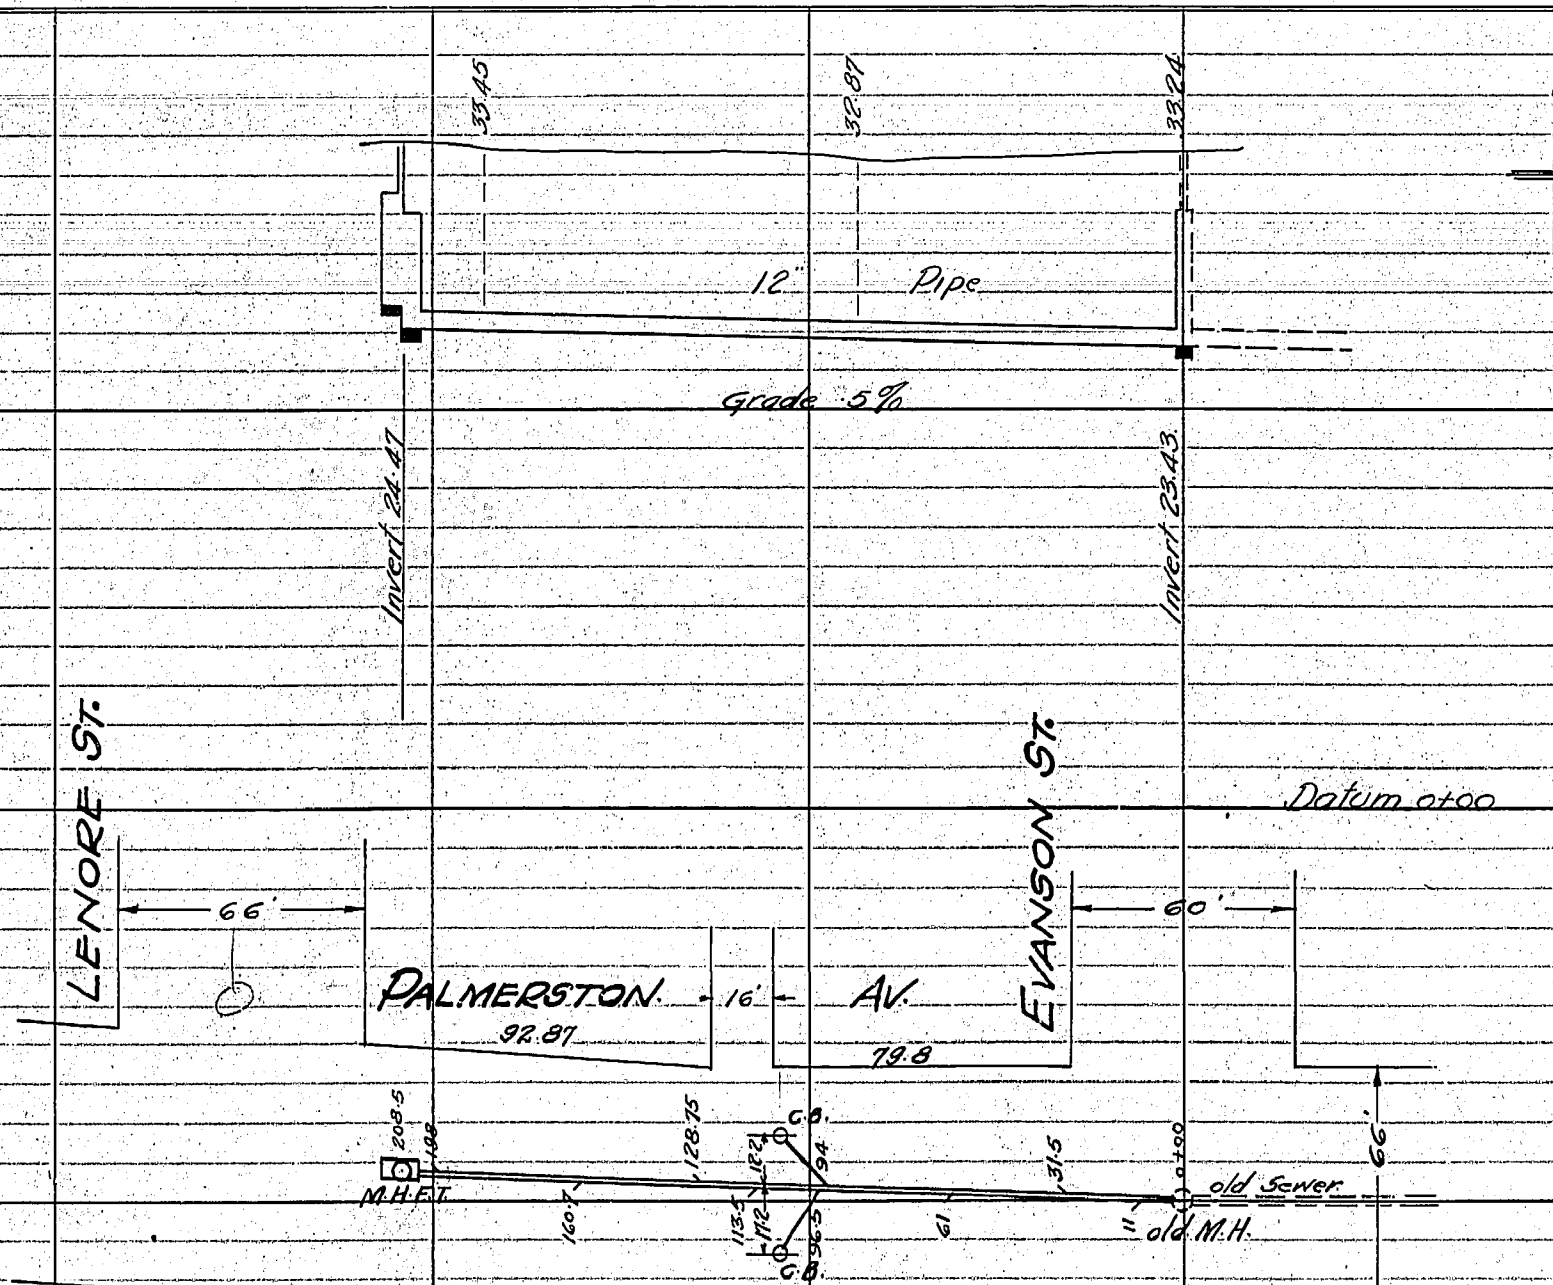

LOCATION OF UNDERGROUND STRUCTURES AS SHOWN ARE BASED ON BEST INFORMATION AVAILABLE. BUT NO GUARANTEE IS GIVEN THAT ALL EXISTING UTILITIES ARE SHOWN AND EXACT LOCATIONS OF ALL UNDERGROUND INCLUDING SERVICE CONNECTIONS MUST BE CHECKED WITH THE UTILITY CONCERNED BEFORE PROCEEDING WITH CONSTRUCTION.

Inspector's Book 1725
 Field Book 420
 Page 47
 March 14th 1932

Scales 1" = 8'-0" Vert.
 1" = 40'-0" Hor.

494	494	494	50'	50'	50'
9	10	11	6	5	4
A2919	A2593	44856	H3535	H3533	H3366