




BASIN DETAIL FOR CLOCKWISE COMMINUTOR
SCALE 1/4" = 1'-0"

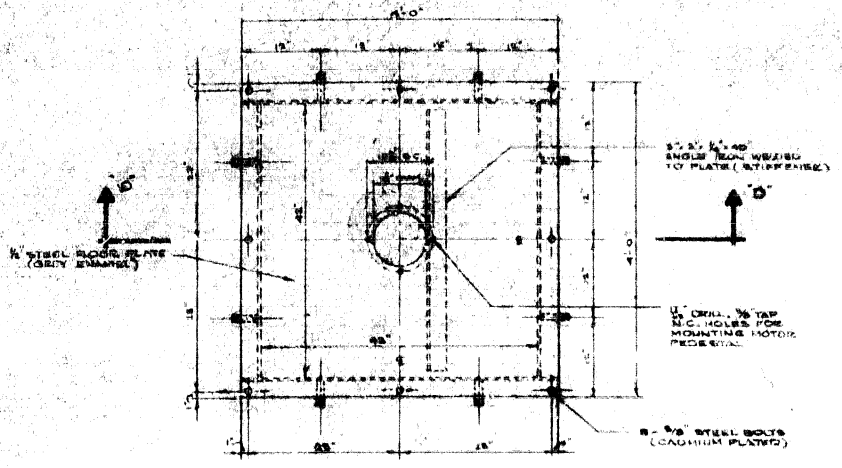


FLOOR PLATE DETAIL
SCALE 1/4" = 1'-0"

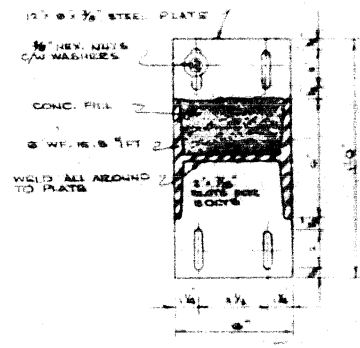


STEADY BEARING SUPPORT
SCALE 1/4" = 1'-0"

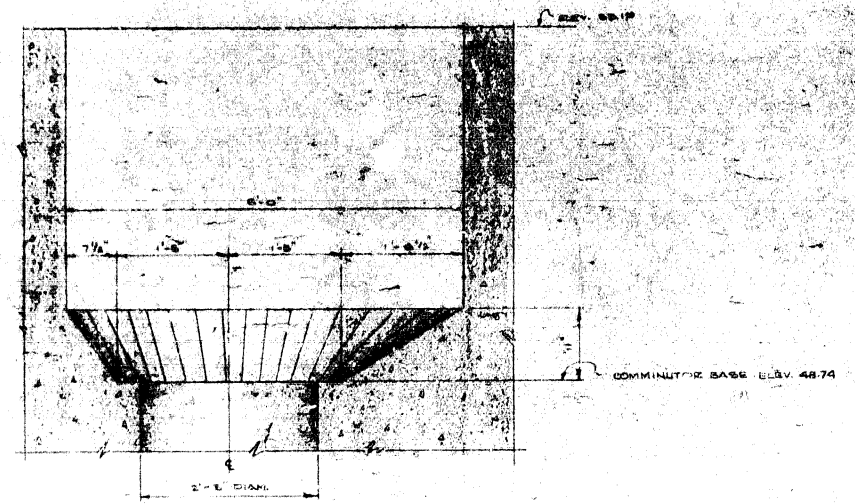


SECTION B-B
SCALE 1/4" = 1'-0"

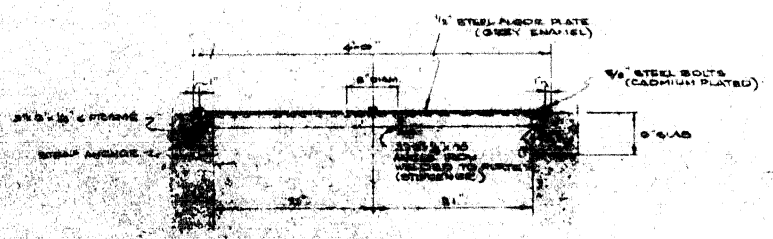


SECTION D-D
SCALE 1/4" = 1'-0"

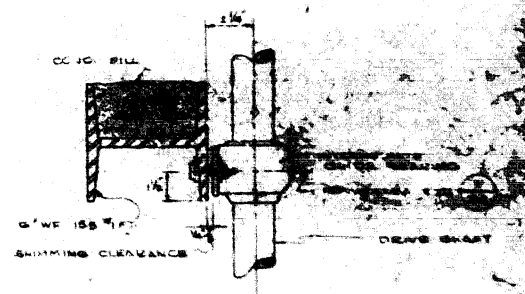


ANCHOR BOLT DETAIL (COMMINUTOR)
SCALE 1/4" = 1'-0"

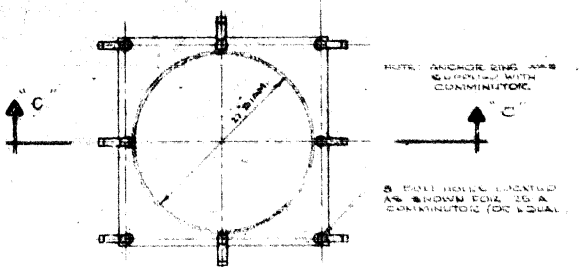

ANCHOR RING DETAIL
SCALE NOT TO SCALE

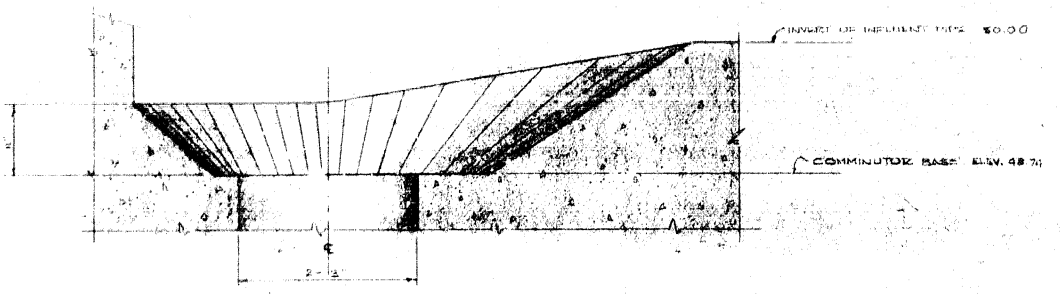

SECTION A-A COMMINUTOR BASIN
SCALE 1/4" = 1'-0"

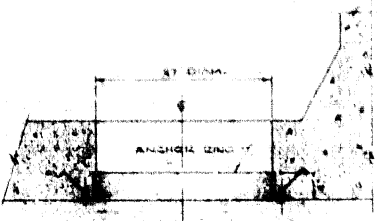

SECTION C-C
SCALE NOT TO SCALE

MUNICIPALITY OF ASSINIBOIA			
RECORD DRAWING			
COMMINUTOR			
DRAWN BY:		UNDERWOOD McLELLAN & ASSOCIATES LIMITED	
TRACED BY:		LIMITED	
CHECKED BY:		CONSULTING PROFESSIONAL ENGINEER	
DESIGNED BY:		CALGARY - SASKATOON - WINDSOR	
LAYOUT BY:		MAY 21, 57	
NO.	DESCRIPTION	DATE BY	REVISIONS
			SCALE AS SHOWN