



SECTION 2
SCALE 1:10

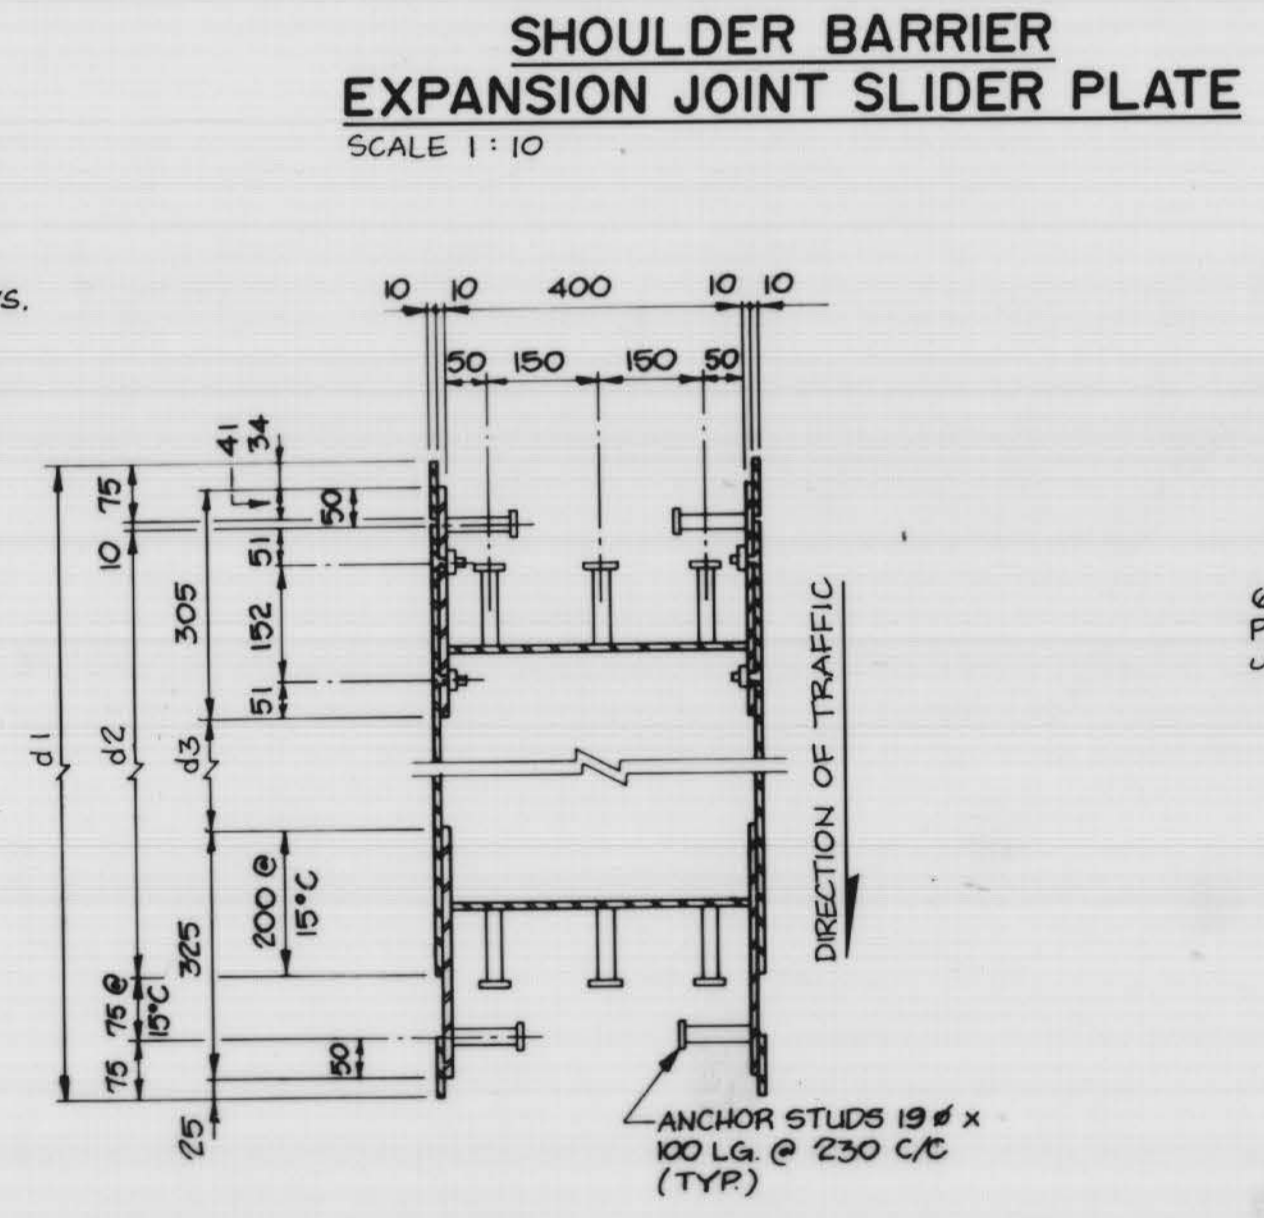

SECTION 3
SCALE 1:10

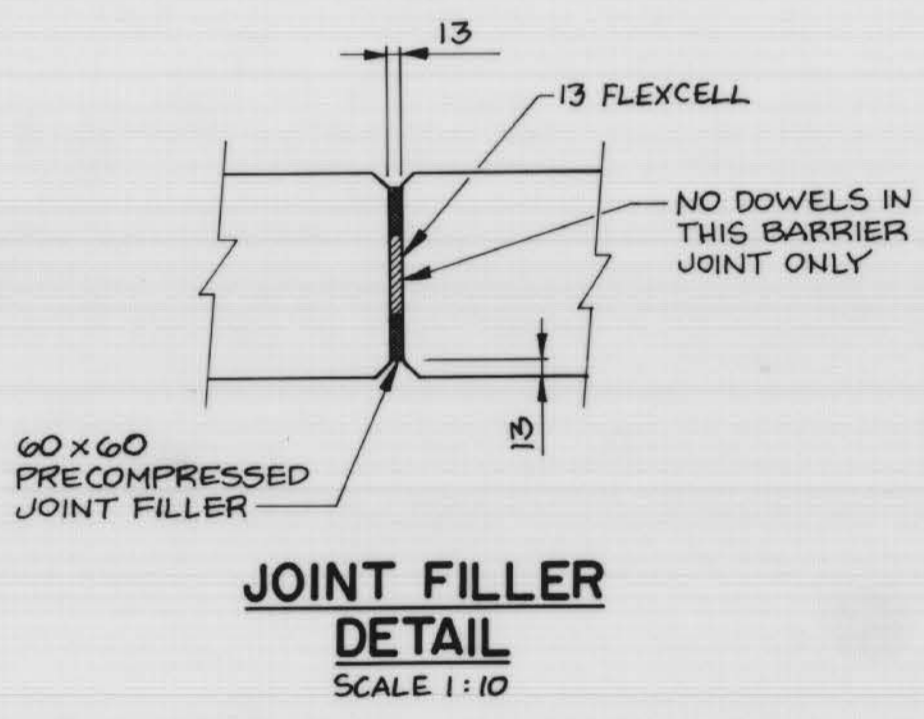

JOINT FILLER DETAIL
SCALE 1:10

RECORD DRAWING
APPROVED BY: *[Signature]* DATE: 96.01.12

DIMENSION	EXISTING	PROPOSED *
d1	1900 @ 15°C	1516 @ 15°C
d2	1665	1281
d3	1057 + J	673 + J

* PROPOSED DIMENSIONS TO BE CONFIRMED BY FIELD MEASUREMENTS WHEN SLIDER PLATE COVER IS REMOVED.

TEMPERATURE CHART									
TEMPERATURE °C	0°	5°	10°	15°	20°	25°	30°	MIN.	MAX.
DIMENSION "J" mm	175	168	161	154	147	140	133	133	265

LOCATION APPROVED UNDERGROUND STRUCTURES
N/A
SUPV U/G STRUCTURES DATE COMMITTEE
NOTE: LOCATION OF UNDERGROUND STRUCTURES AS SHOWN ARE BASED ON THE BEST INFORMATION AVAILABLE BUT NO GUARANTEE IS GIVEN THAT ALL EXISTING UTILITIES ARE SHOWN OR THAT THE GIVEN LOCATIONS ARE EXACT CONFIRMATION OF EXISTENCE AND EXACT LOCATION OF ALL SERVICES MUST BE OBTAINED FROM THE INDIVIDUAL UTILITIES BEFORE PROCEEDING WITH CONSTRUCTION

NO	REVISIONS	DATE	BY

DILLON
Consulting Engineers • Planners
Environmental Scientists

DESIGNED BY: M.C.	CHECKED BY: M.C.
DRAWN BY: B.A.S./C.R.B.	APPROVED BY: <i>[Signature]</i>
HOR. SCALE: AS SHOWN	DATE: 94-08-16
VERTICAL: AS SHOWN	ACCEPTED BY: <i>[Signature]</i>
DATE: AUG. 1994	DATE:

ENGINEER'S SEAL
PROVINCE OF MANITOBA
[Signature]
M. B. CHISLETT
REGISTERED PROFESSIONAL ENGINEER
CONSULTANT DRAWING NO.

THE CITY OF WINNIPEG
WORKS AND OPERATIONS DIVISION
STREETS AND TRANSPORTATION DEPARTMENT

1994 BRIDGE MAINTENANCE - SLAW REBCHUK BRIDGE
APPROACH PAVEMENT RECONSTRUCTION
PHASE 1
SHOULDER BARRIER EXPANSION JOINT SLIDER PLATE MODIFICATIONS

CITY DRAWING NUMBER: B115-94-03
SHEET 3 OF 5
B-5958-3
MMD 94-1909-01