


P25 WWD CELL TOWER SITE

DECEMBER 31, 2016

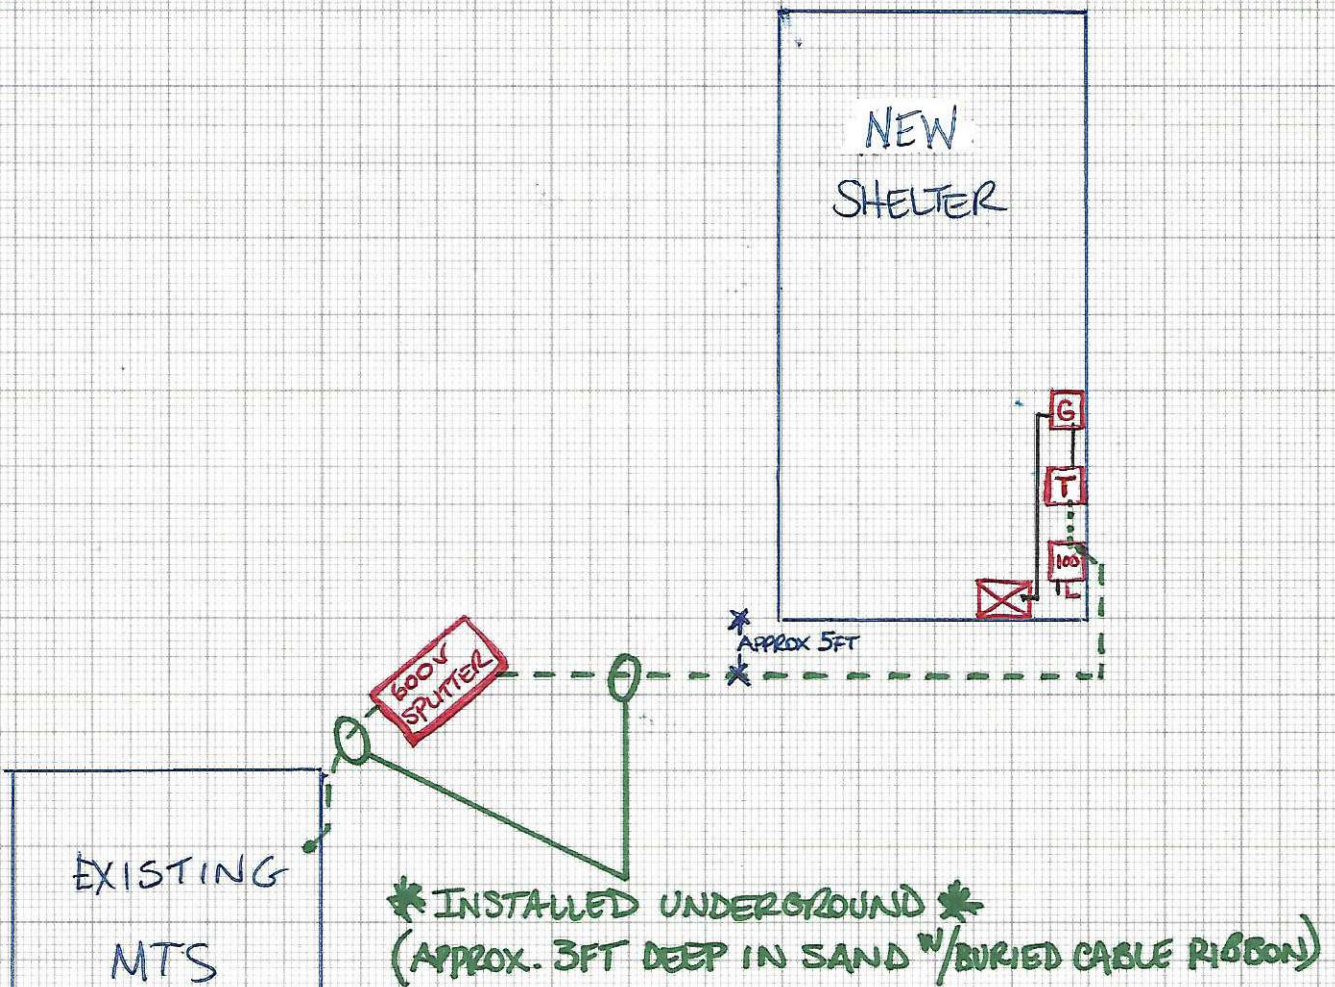

* INSTALLED UNDERGROUND *
 (APPROX. 3FT DEEP IN SAND w/ BURIED CABLE RIBBON)

G = TRANSFER SWITCH

———— = 3c/#3/0 TECK CABLE

- - - - = 3c/#3 TECK CABLE

X = EXISTING 200A PANEL

100 = 100A FUSIBLE DISCONNECT (FUSED @ 80A)

T = 37.5KVA TRANSFORMER 600V/120-240V 1φ

ACON ELECTRIC LTD.
 171 WAVERLEY ST
 WINNIPEG MANITOBA
 DECEMBER 31, 2016
[Signature]