



**BILL OF MATERIALS**

QTY	MARK	DESCRIPTION	LENGTH	WEIGHT	REMARKS
ONE	024	HANDRAIL	9'-0 11/16"	-	-
ONE	a	1 1/2"Ø STD. PIPE	24'-2" LINEAL	-	A53 GRADE B
26	b	1/2" Ø BAR	2'-1"	-	-
ONE	P029	PL 1/4x2 1/2"	0'-8"	-	-
FIELD BOLTS					
2		1/2"Ø A316 SS	0'-1 1/2"	-	-

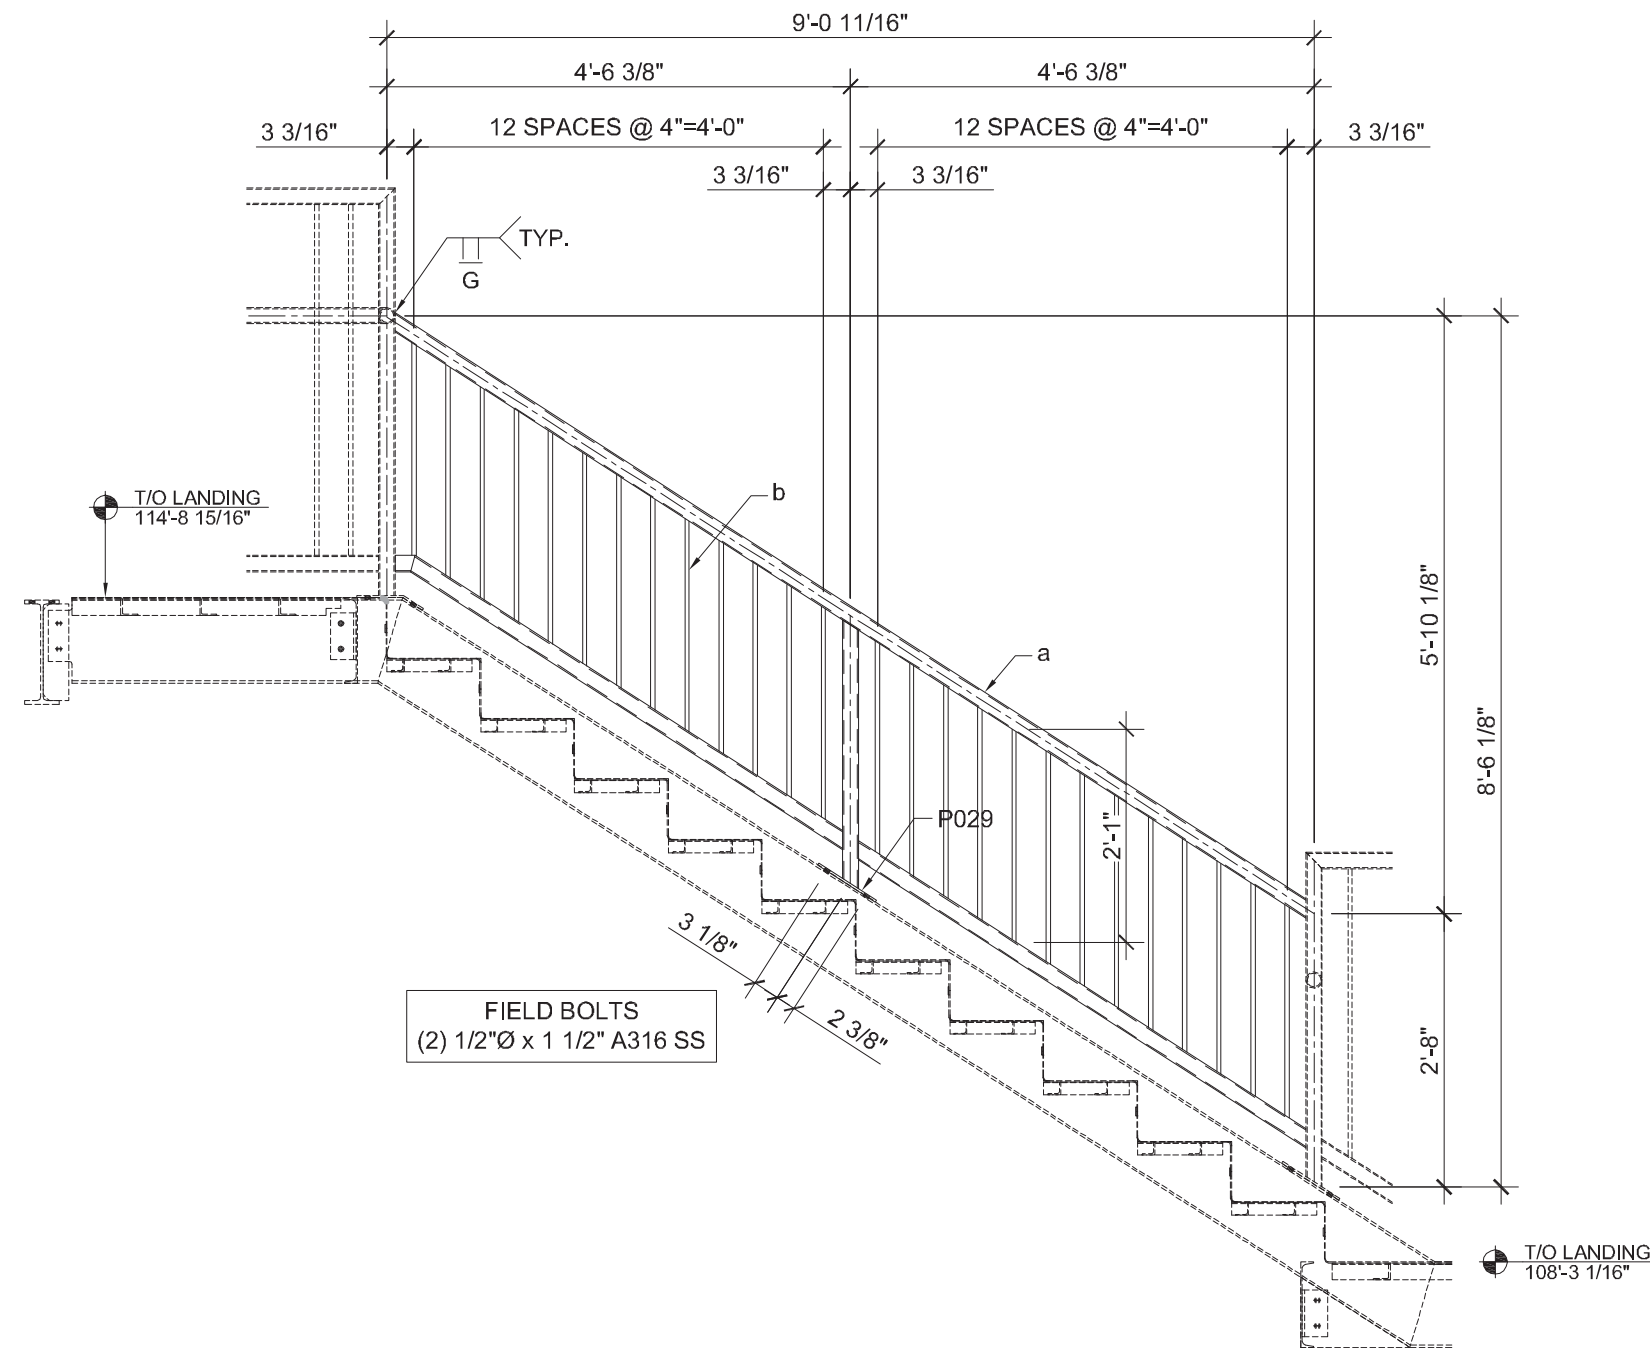

FIELD BOLTS  
(2) 1/2"Ø x 1 1/2" A316 SS

**MK 024 - HANDRAIL x 9'-0 11/16"**  
(ONE REQUIRED AS SHOWN)

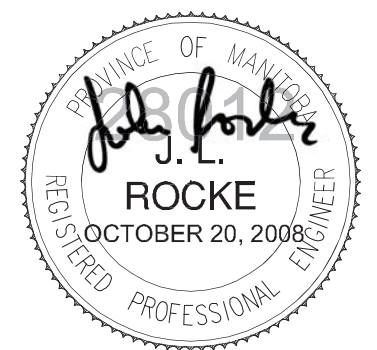

**DRAWING NOTES:**  
NOTE

LIABILITY FOR THESE DRAWINGS IS LIMITED TO DRAFTING SERVICES ONLY. NO ENGINEERING RESPONSIBILITY INCLUDED.

FABRICATOR/ERECTOR IS RESPONSIBLE FOR VERIFYING ALL DIMENSIONS & ELEVATIONS AND CHECKING ALL SITE CONDITIONS THAT COULD AFFECT STEEL ERECTION & PLACEMENT TO DIMENSIONS INDICATED ON ERECTION DRAWINGS.

TOTAL WEIGHT  
0.0 LBS

STEEL GRADE  
ALL STRUCT. STEEL TO CSA G40.21  
W SECT, LIGHT GA STL: 350W U.N.O.  
HSS SECT: 350W CLASS C U.N.O.  
CHNLS, L'S, PL, ETC.: 300W U.N.O.

WELD  
MIN. 3/16" FILLET U.N.O.

HOLES  
13/16"Ø U.N.O.

FINISH  
GALVANIZED + EPOXY PAINT

REF DWG & MEMBER LOCATION (S)  
E01 & E02  
GRID C2  
GRID 1.1 & 1.2

1	AS-BUILT	OCT/20/2008	JMH	RLA
0	FOR APPROVAL	JULY/17/2008	JMH	RLA
REV	DESCRIPTION	DATE	BY	CHK'D

Tractus Group Incorporated  
70 Arthur Street, Studio 100  
Winnipeg, Manitoba, R3B 1G7

P (204) 942-6035  
F (204) 942-6034  
E Info@tractusgroup.com

PROJECT/CLIENT <b>WESTERN RECREATION ELMWOOD KILDONAN POOL WATERSLIDE STAIR 909 CONCORDIA AVENUE, WINNIPEG, MANITOBA</b>					
MEMBER DESCRIPTION <b>HANDRAIL</b>					
DRAWN BY JC	DRAWN DATE JULY/07/2008	SCALE NTS	SIZE B	DRAWING NUMBER 024	REV 1
CHK'D BY RLA	CHECKED DATE JULY/14/2008	JOB No. 28012			