




## **APPENDIX B – ARCHIBALD STREET OUTFALL GENERAL LOCATION MAP AND SITE SPECIFIC SUPPORTING DOCUMENTATION**

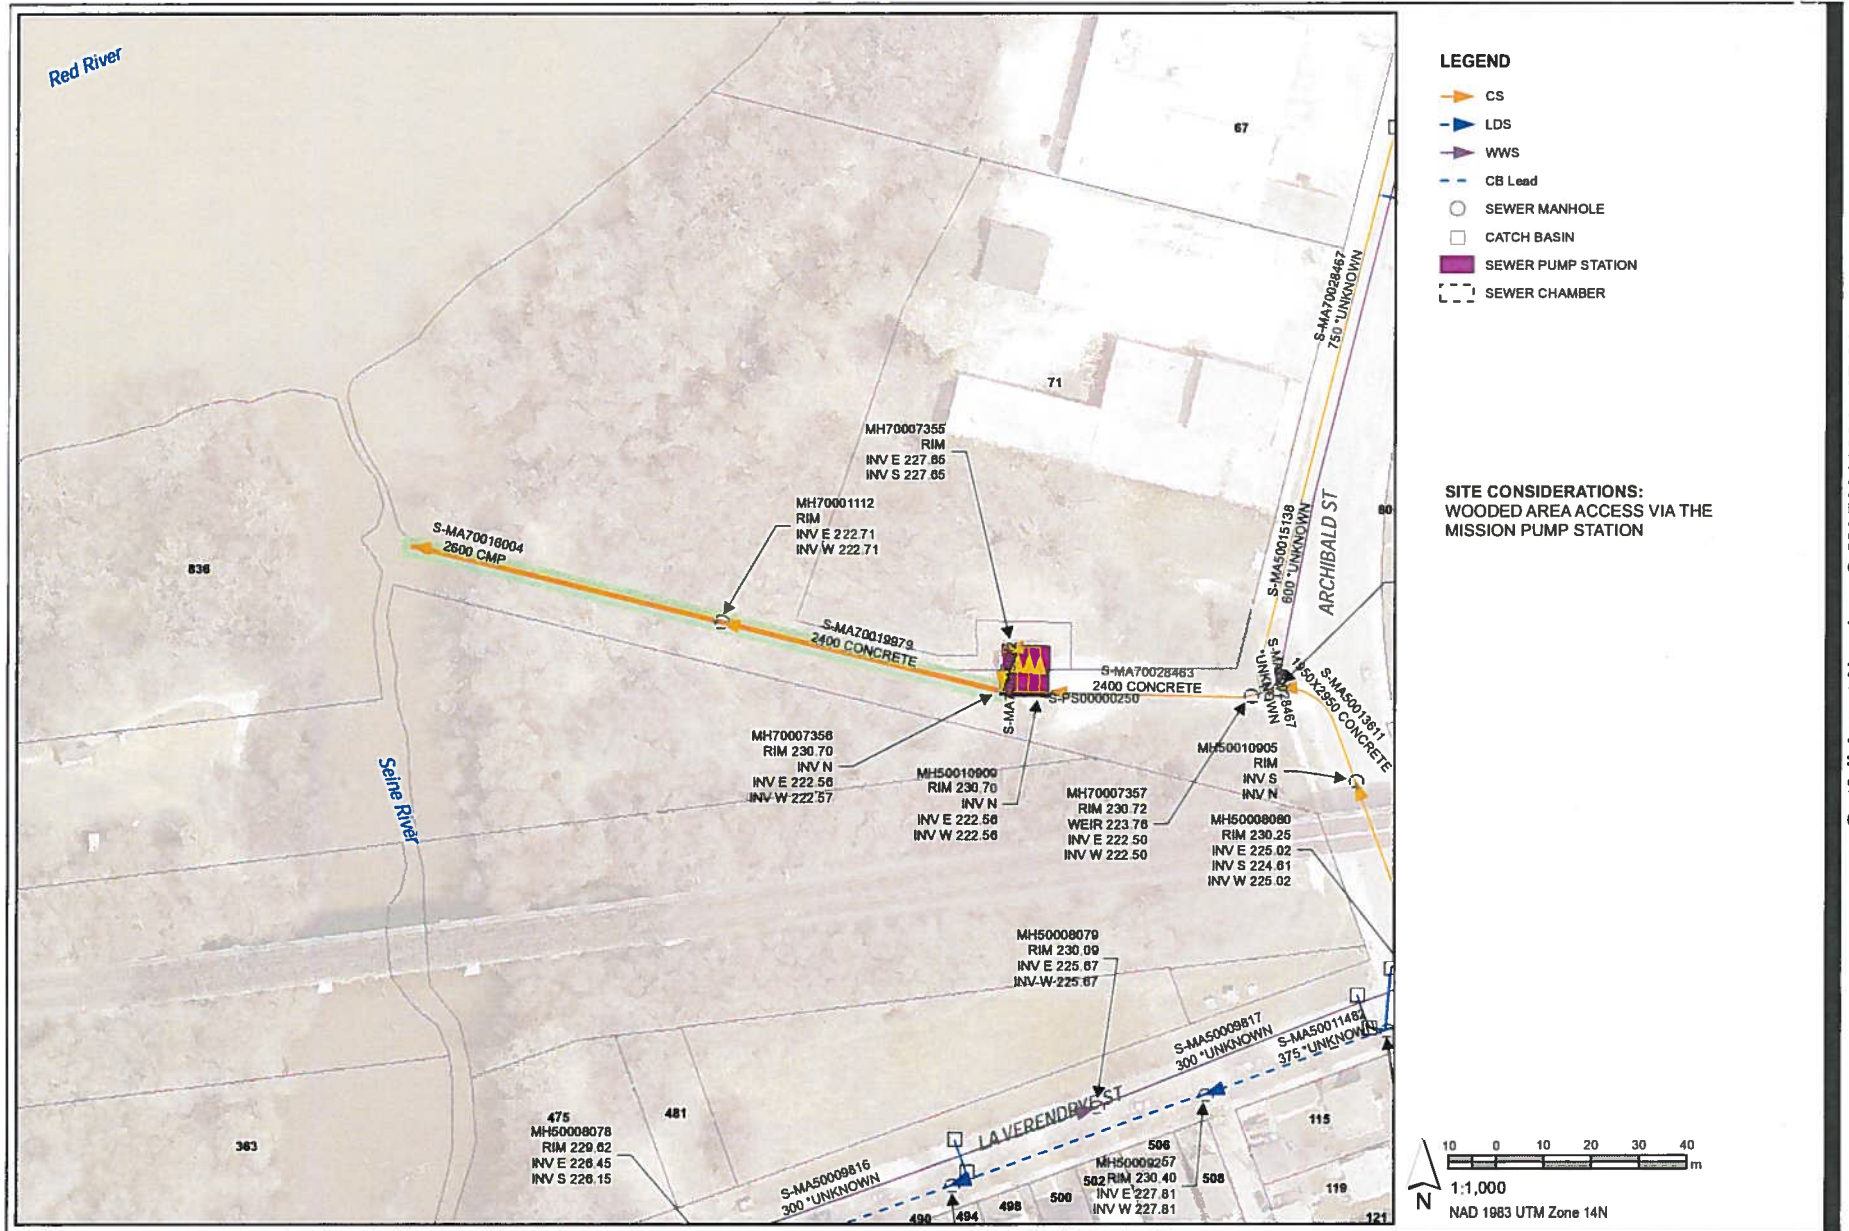

**Outfall Asset Number: S-MA70016004 - 67.01m**  
**Upstream Sewer Asset Number: MA70019979 - 60.25m**  
**Upstream Manhole Coordinates: 635792.6134E, 5529187.0763N**  
**Location: 75 ARCHIBALD ST**

ENGINE DRAWING  
 TITLE  
 DATE

ENTRIED IN R 27

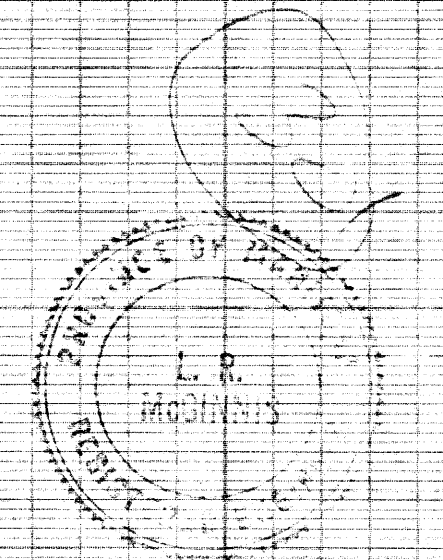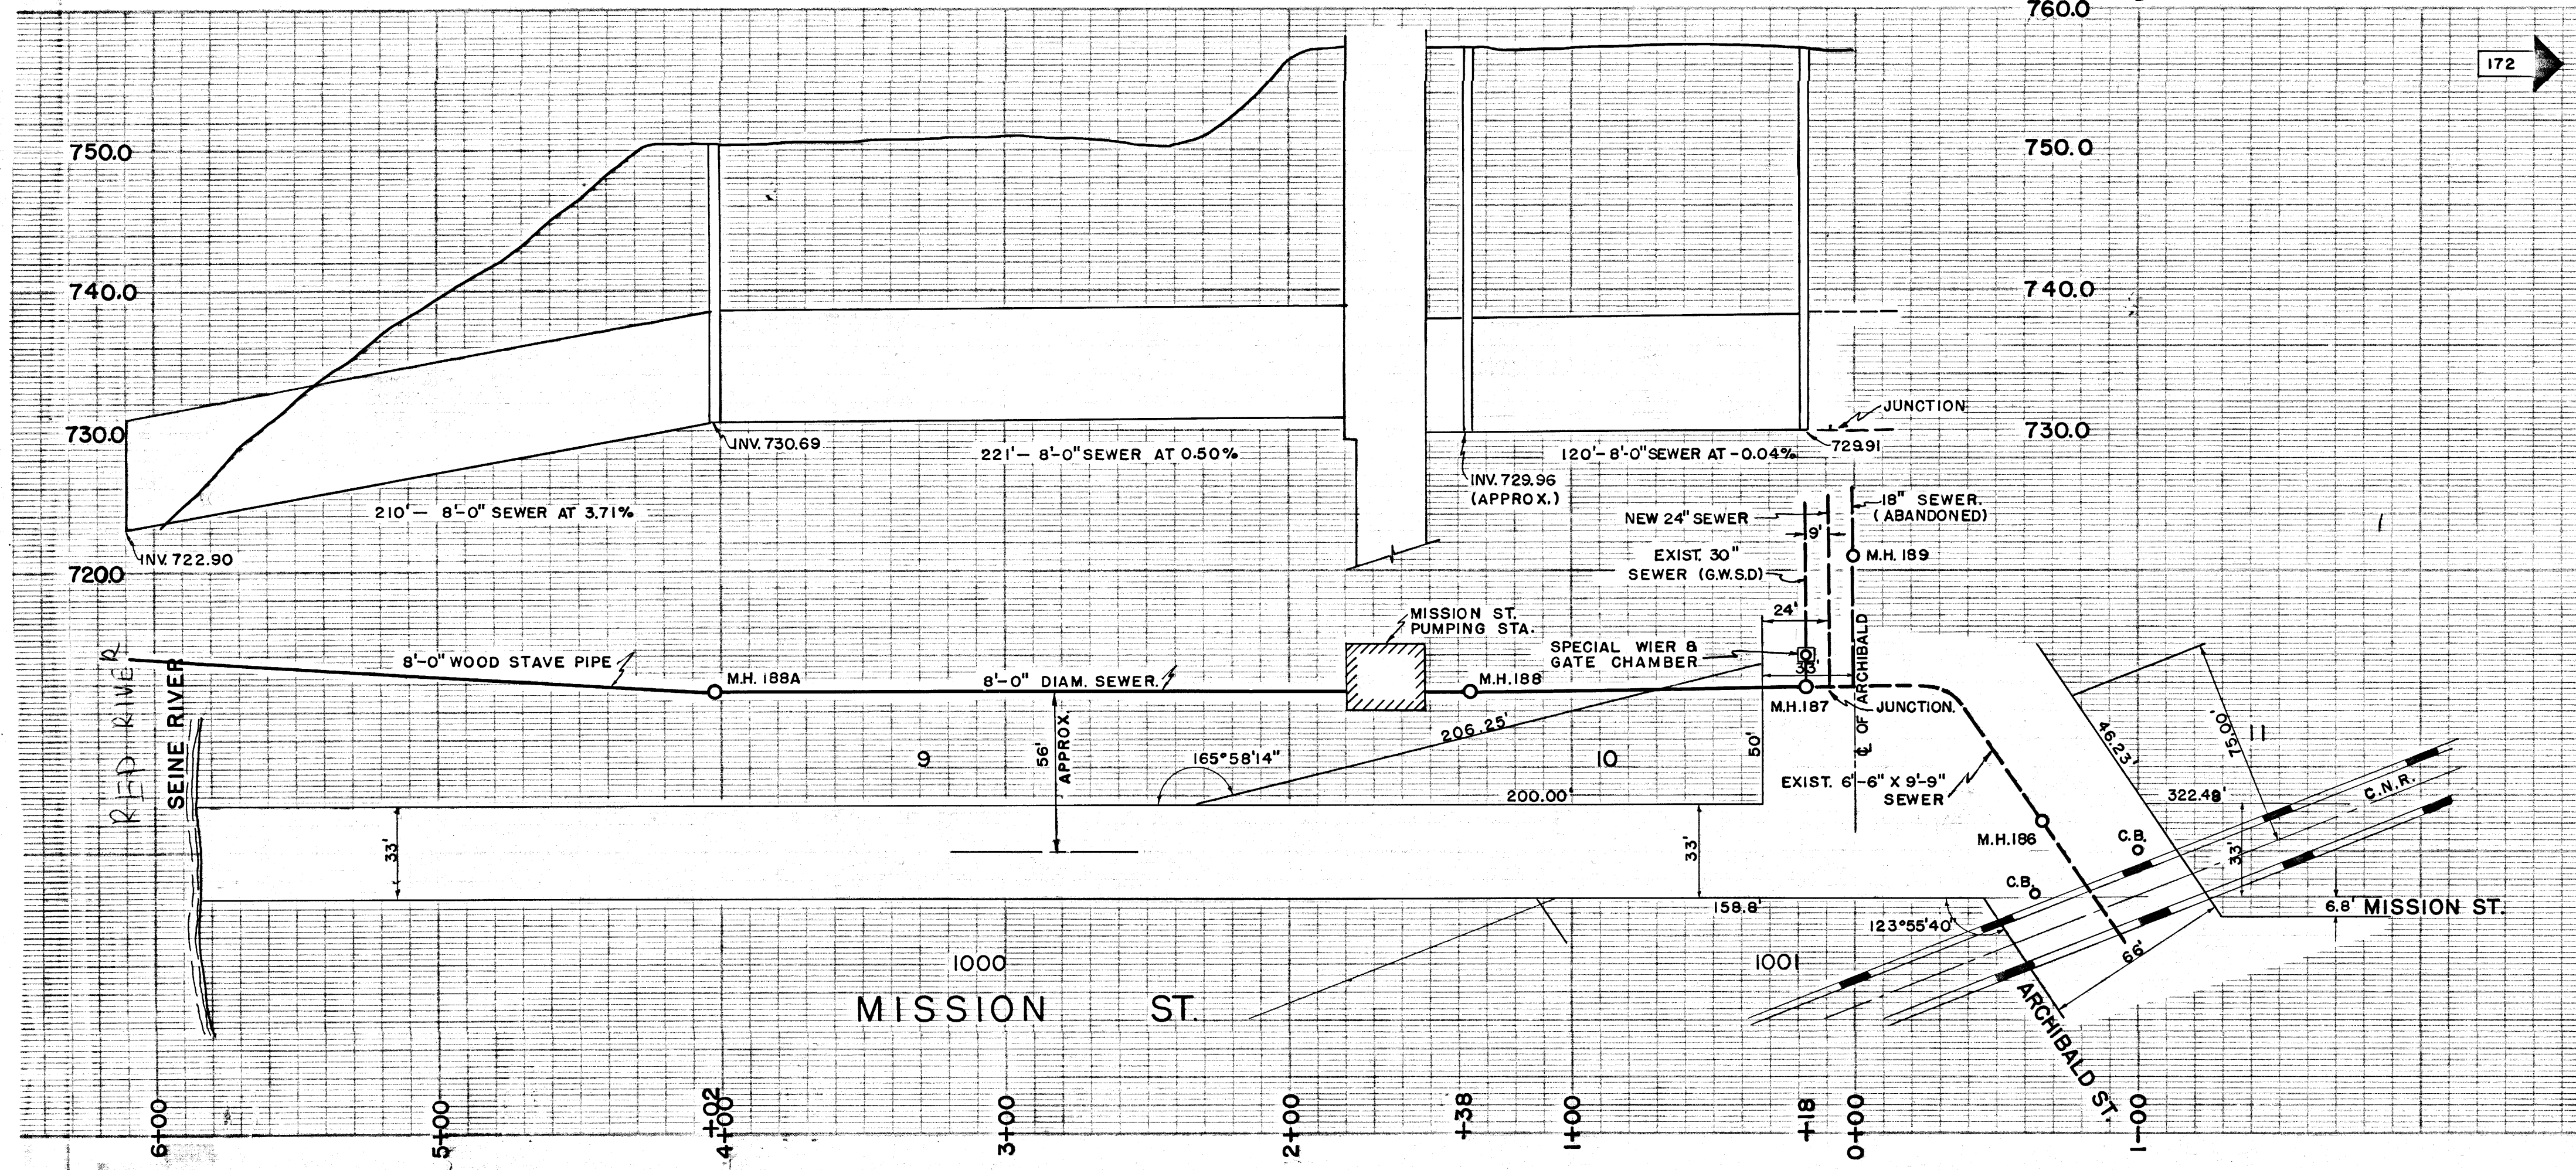

<b>CITY OF ST. BONIFACE</b>	
PUBLIC WORKS DEPARTMENT	
AS BUILT SERVICES PLAN & PROFILE OF MISSION ST. PUMPING STATION.	
W. L. WARDROP & ASSOCIATES ENGINEERING CONSULTANTS WINNIPEG CANADA	
Scale: HORIZ. 1"=40' VERT. 1"=8' Date: DECEMBER 1958.	
Drawn By:	Drawing No.
Checked By:	S-149
Project No. 5823	

102330