


NOTES:

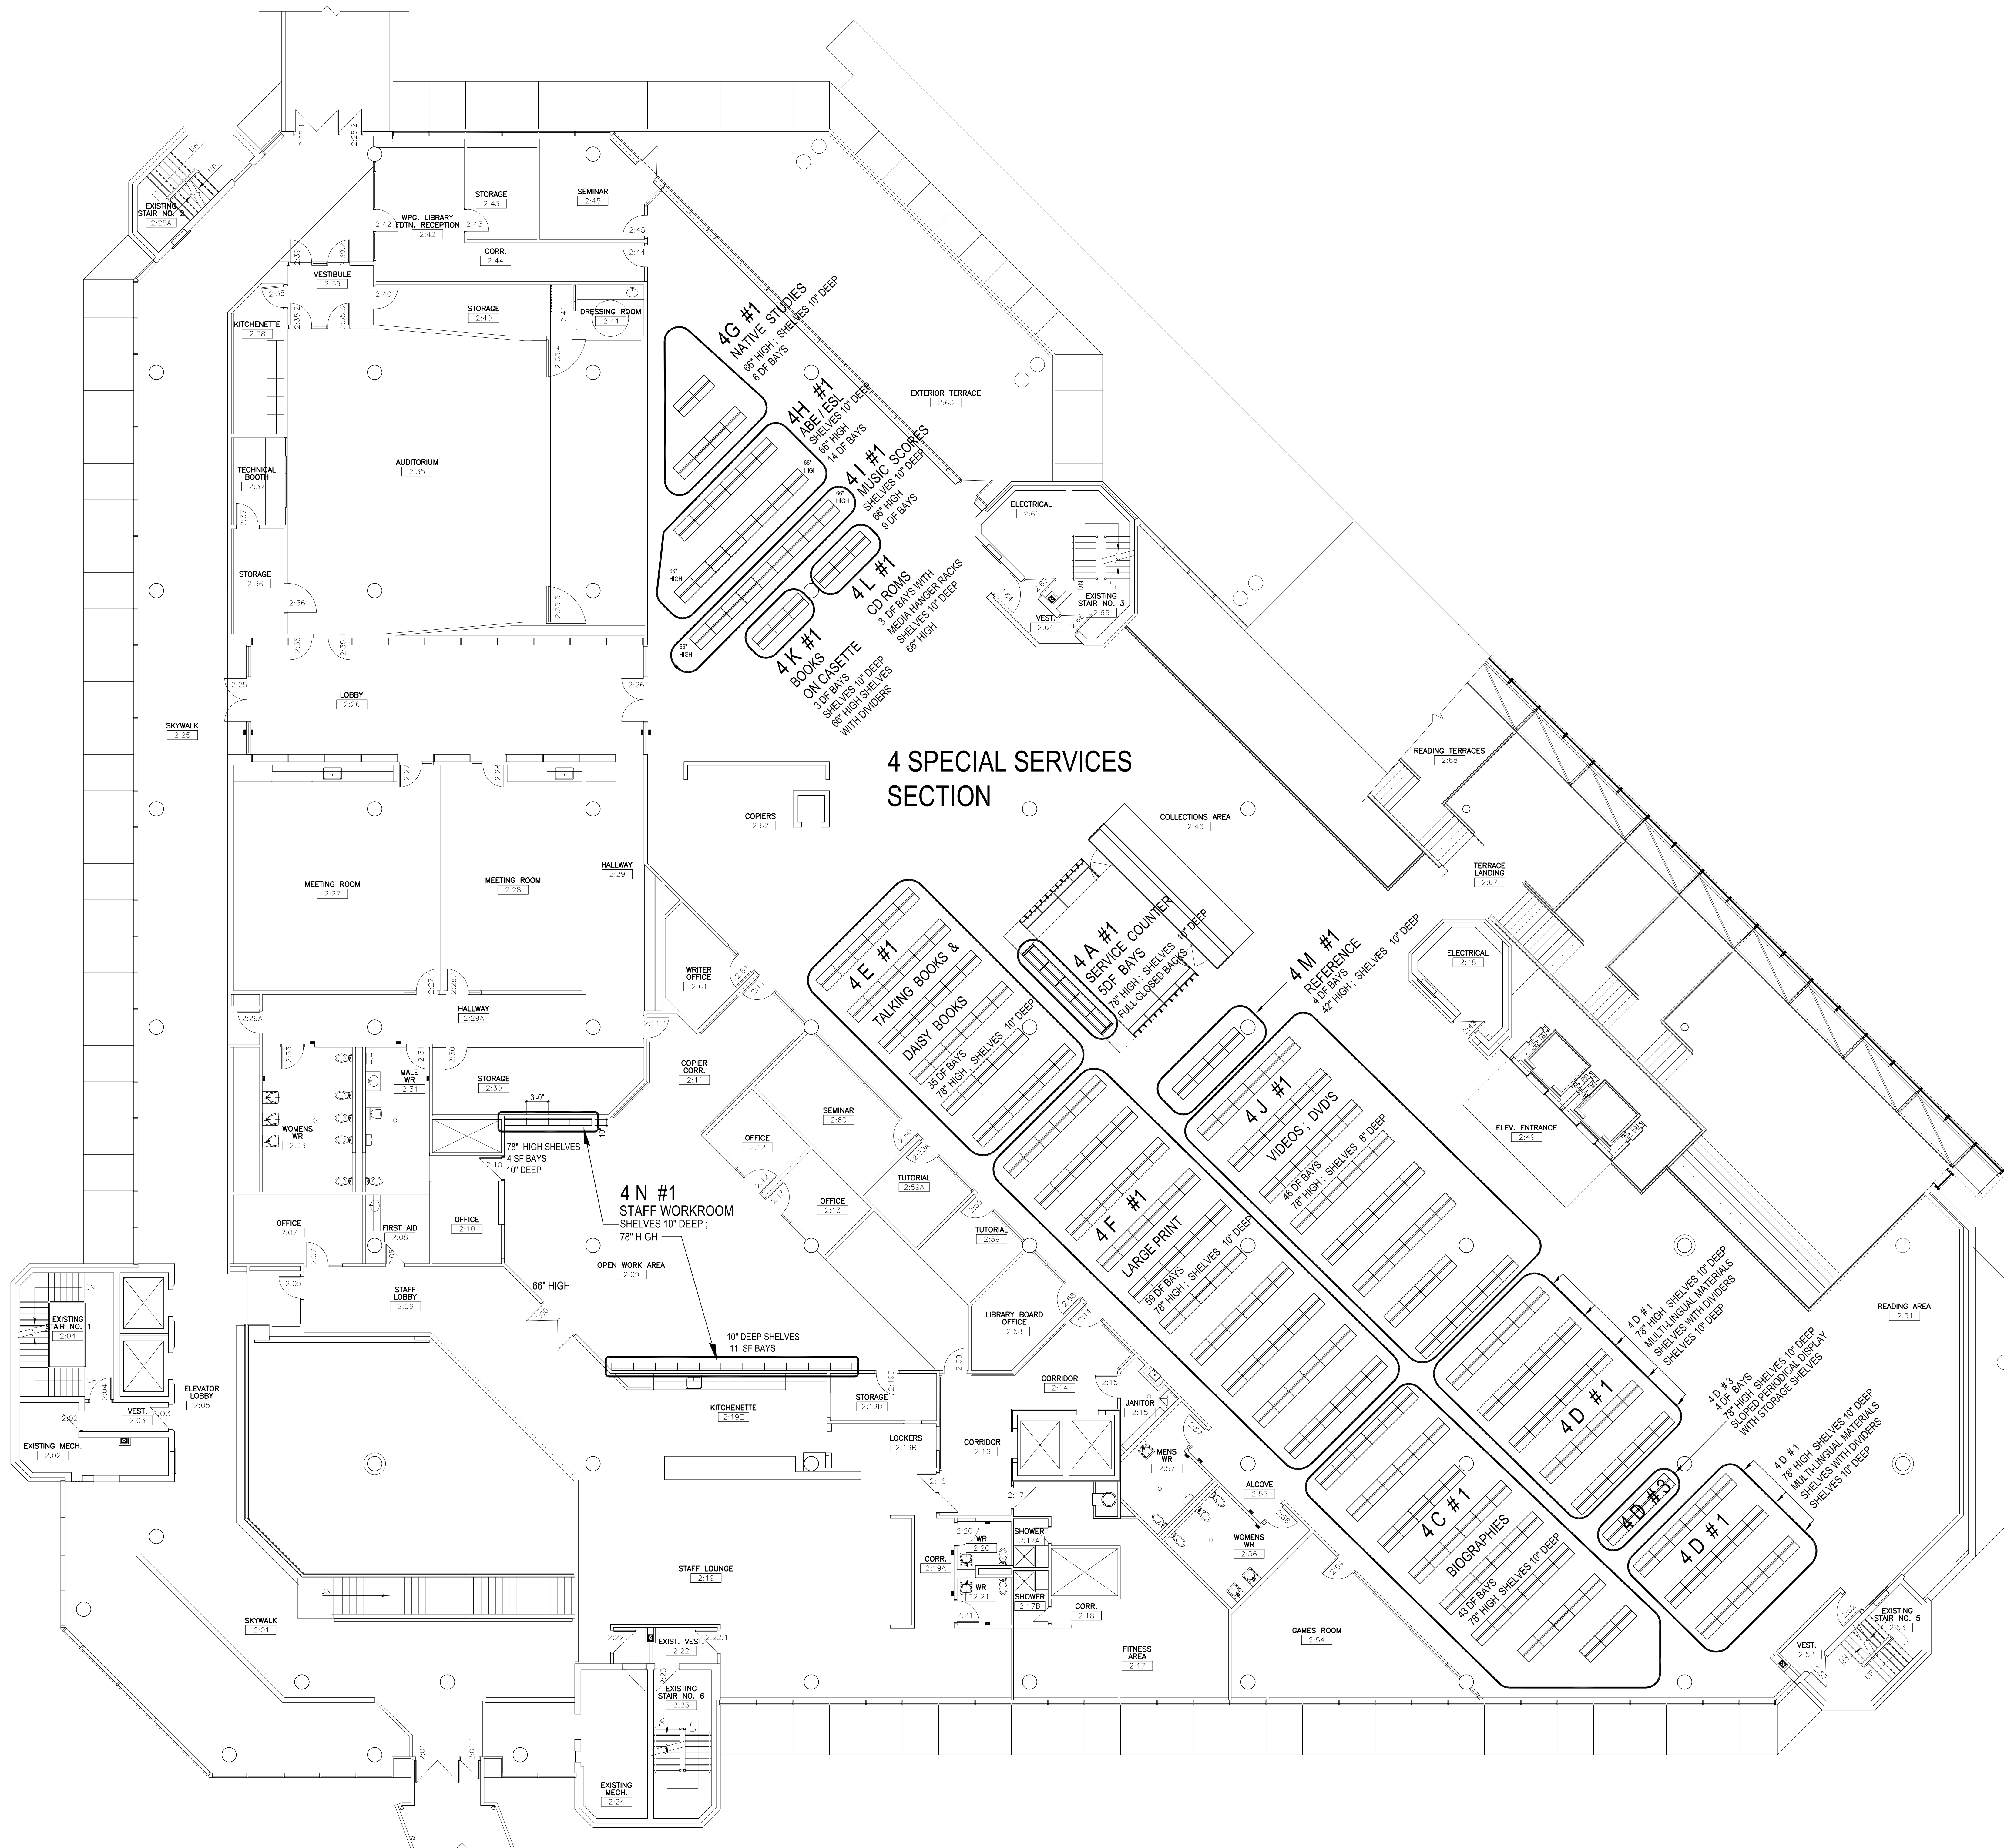

NO.	REVISION/DESCRIPTION	BY	DATE
1	REVISION TO SECTION 4J#1	TC	2005.04.22

SEALS		
DRAWN BY	CHECKED BY	APPROVED
TC	USER APPROVAL	

CITY OF WINNIPEG
 PLANNING, PROPERTY &
 DEVELOPMENT DEPARTMENT
 CIVIC ACCOMMODATIONS DIVISION
 300 - 65 GARRY ST. R3C 4K4

MILLENNIUM LIBRARY
 NEW SHELVING LAYOUT

SHEET TITLE
 SECOND FLOOR
 BID OPPORTUNITY # 117-2005

SCALE 1/8"=1'-0" PROJECT NO SHEET NO F-2