




PLAN OF OUTLET COVERS  
1:100

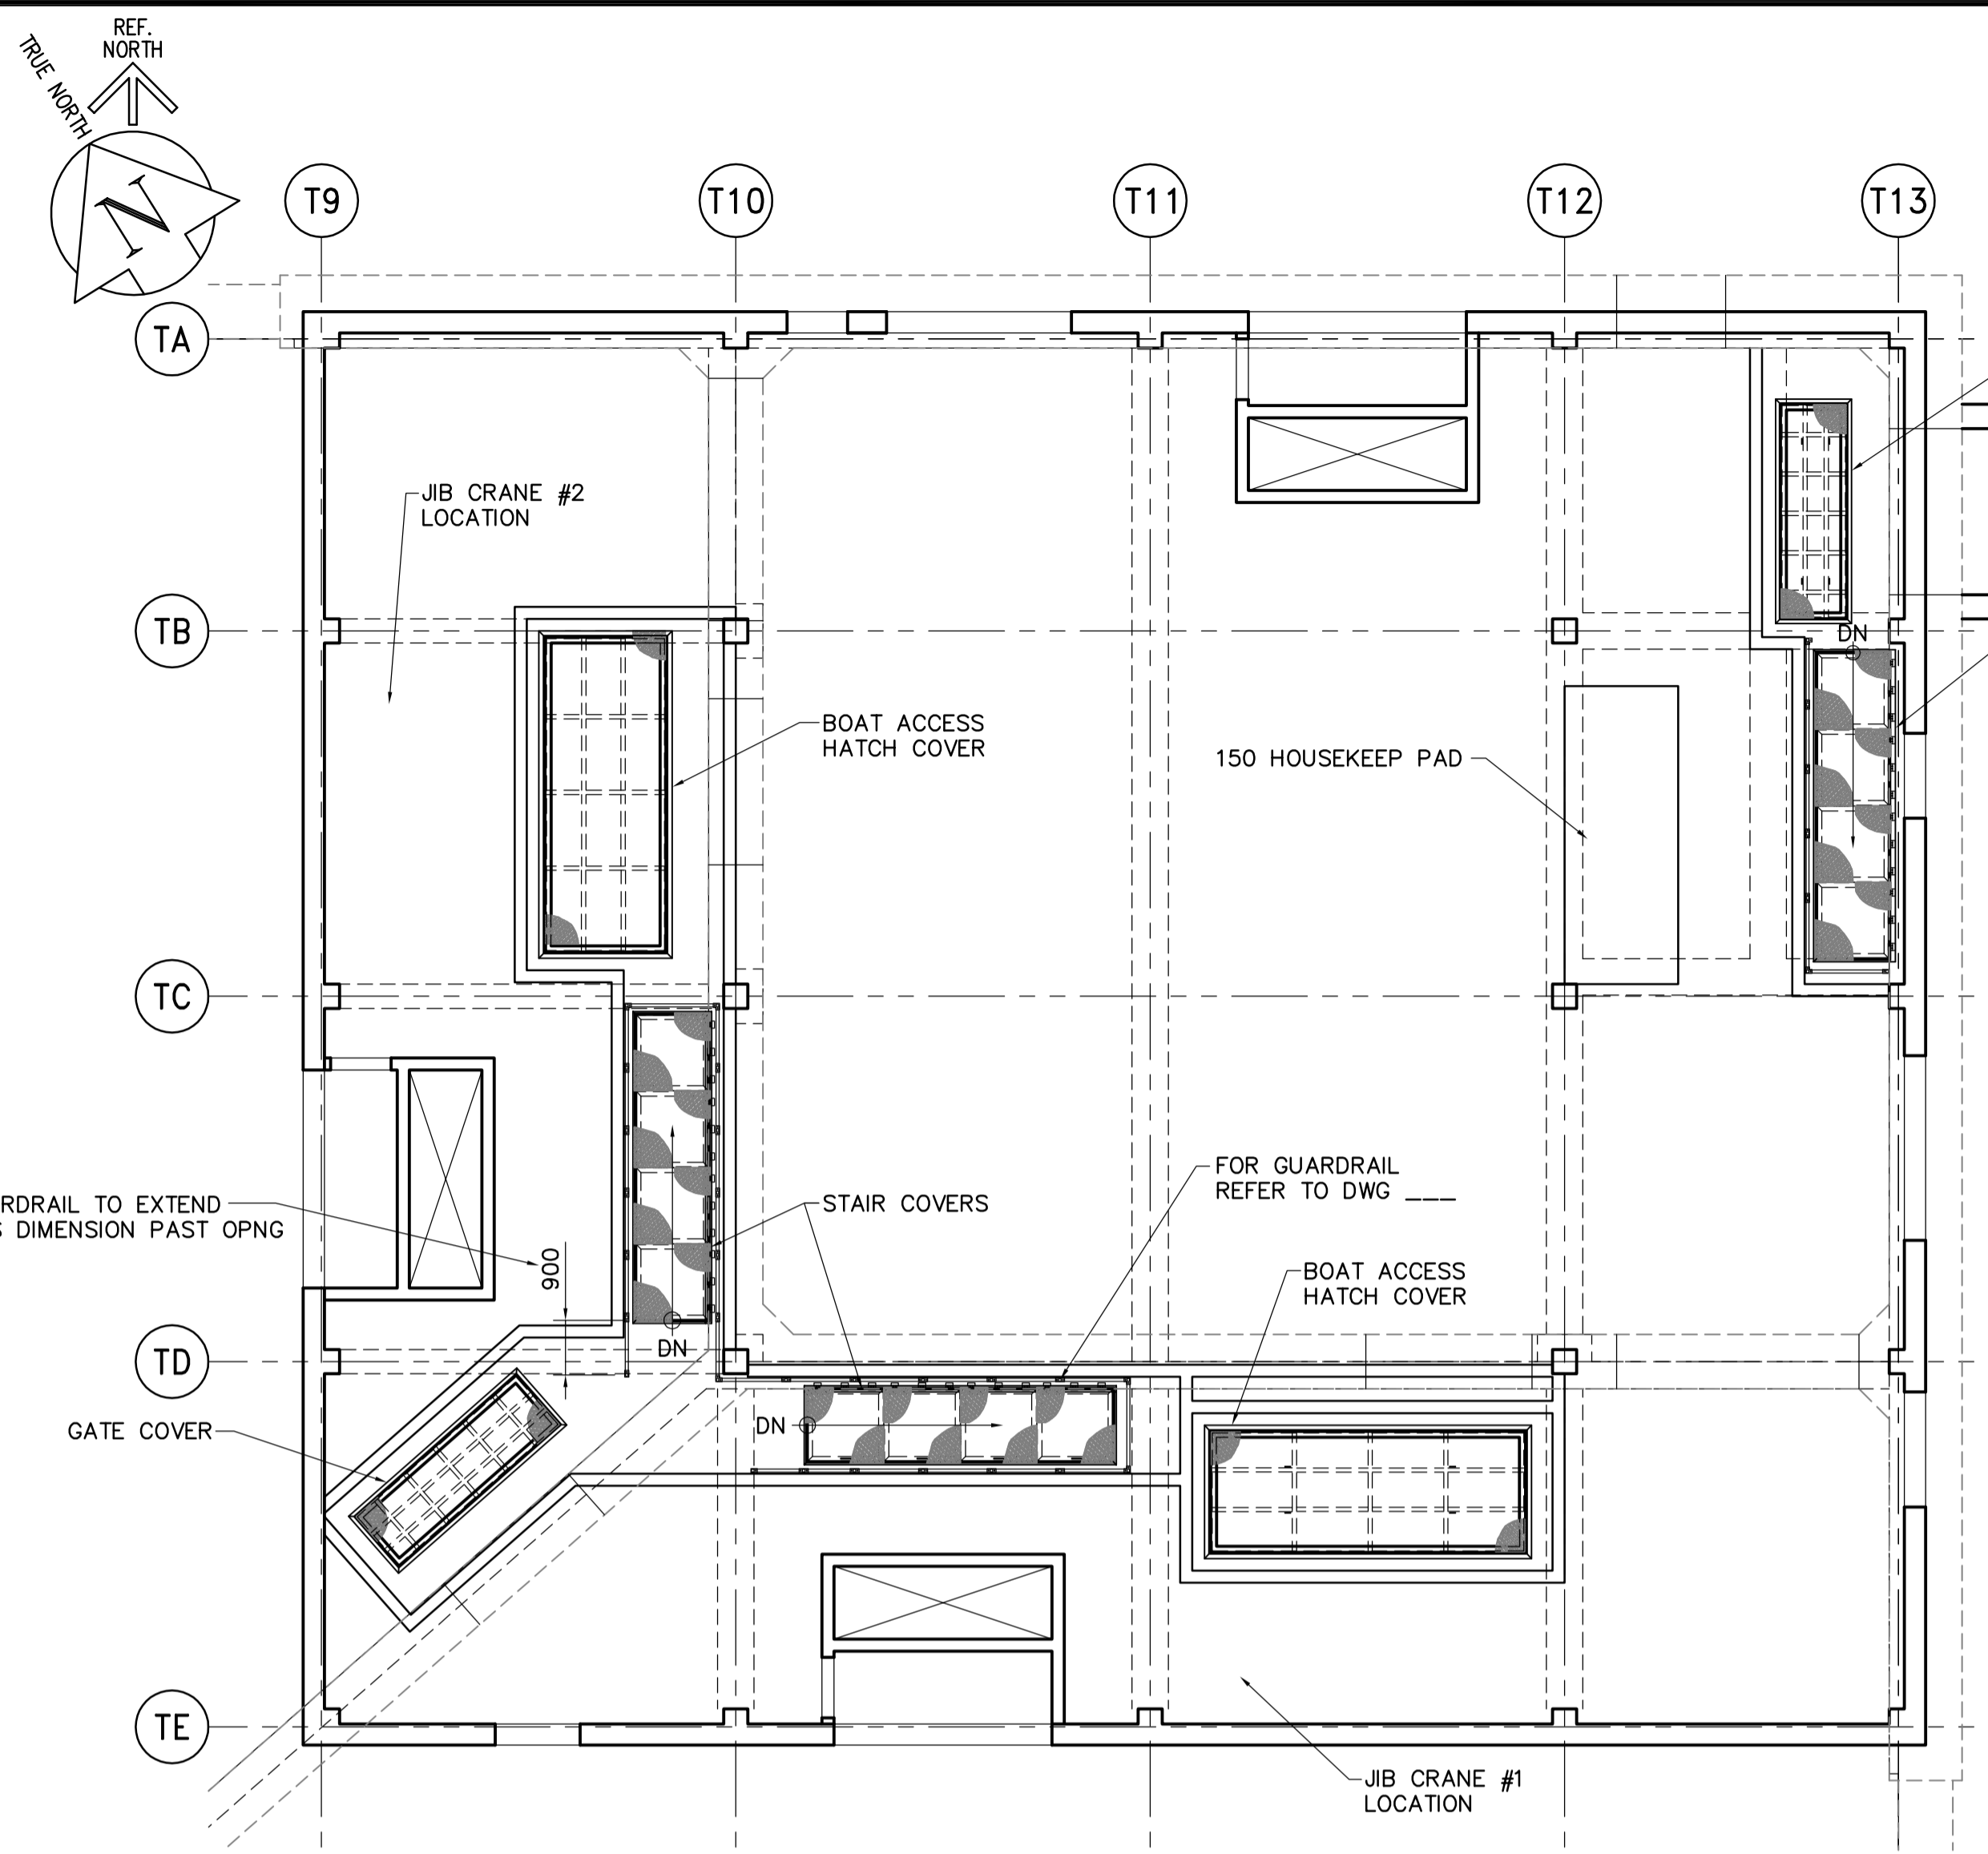


PLAN OF INLET COVERS  
1:100

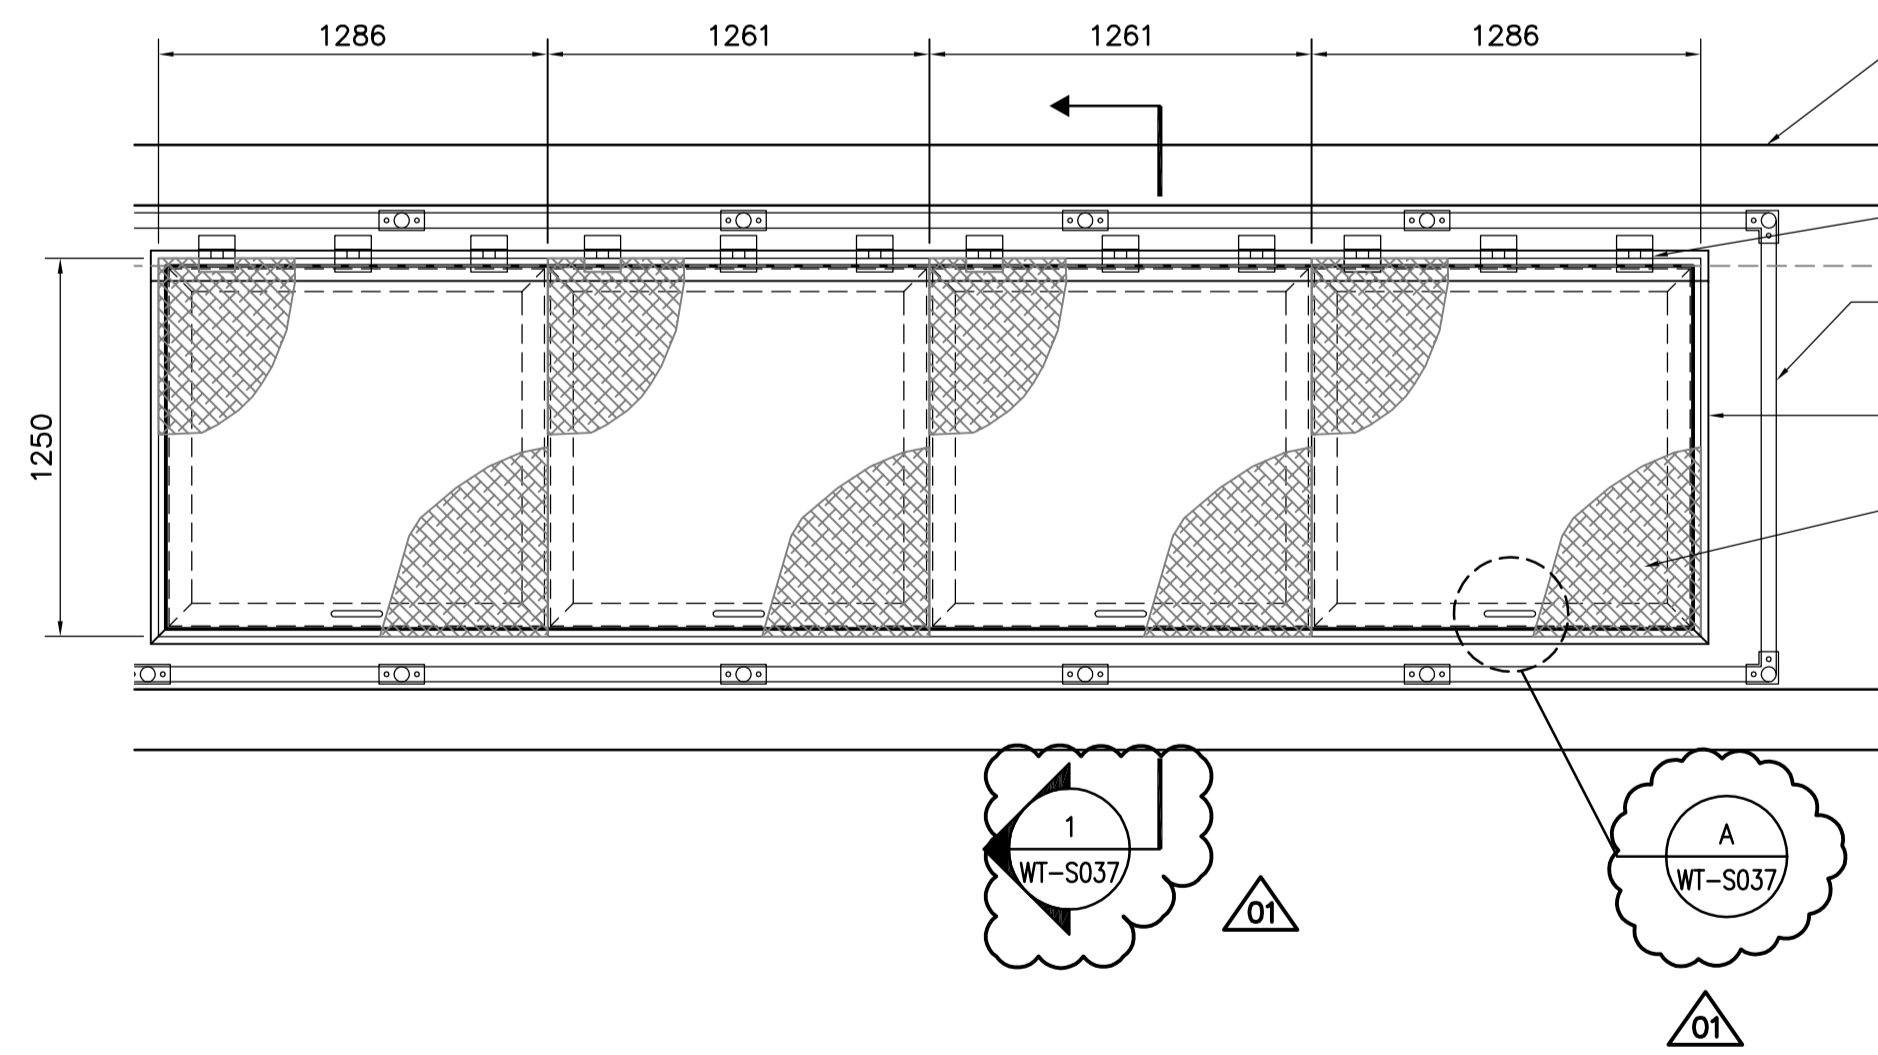

TYPICAL PLAN OF STAIR COVERS  
1:25

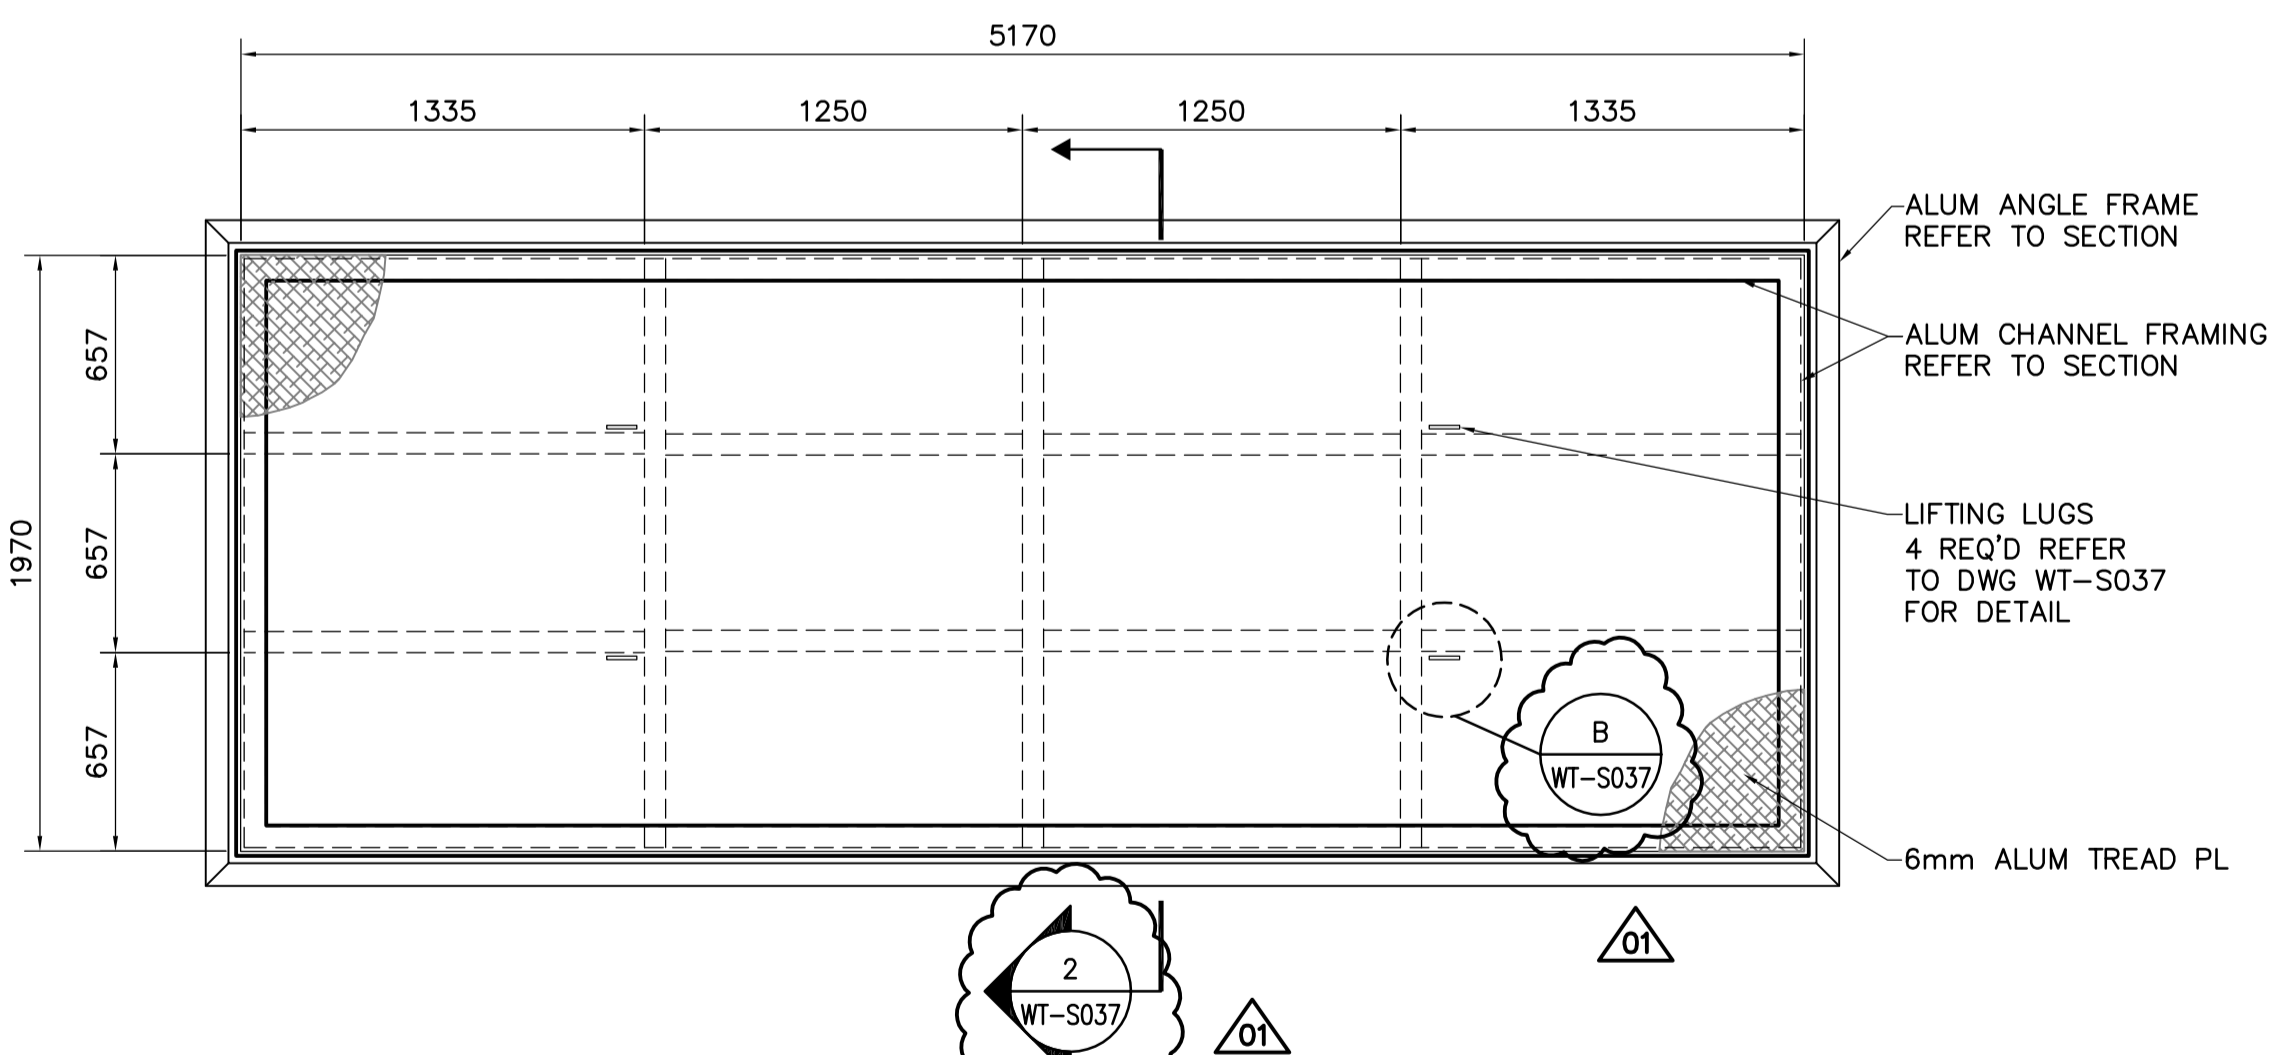

TYPICAL PLAN OF BOAT ACCESS HATCH COVERS  
1:25

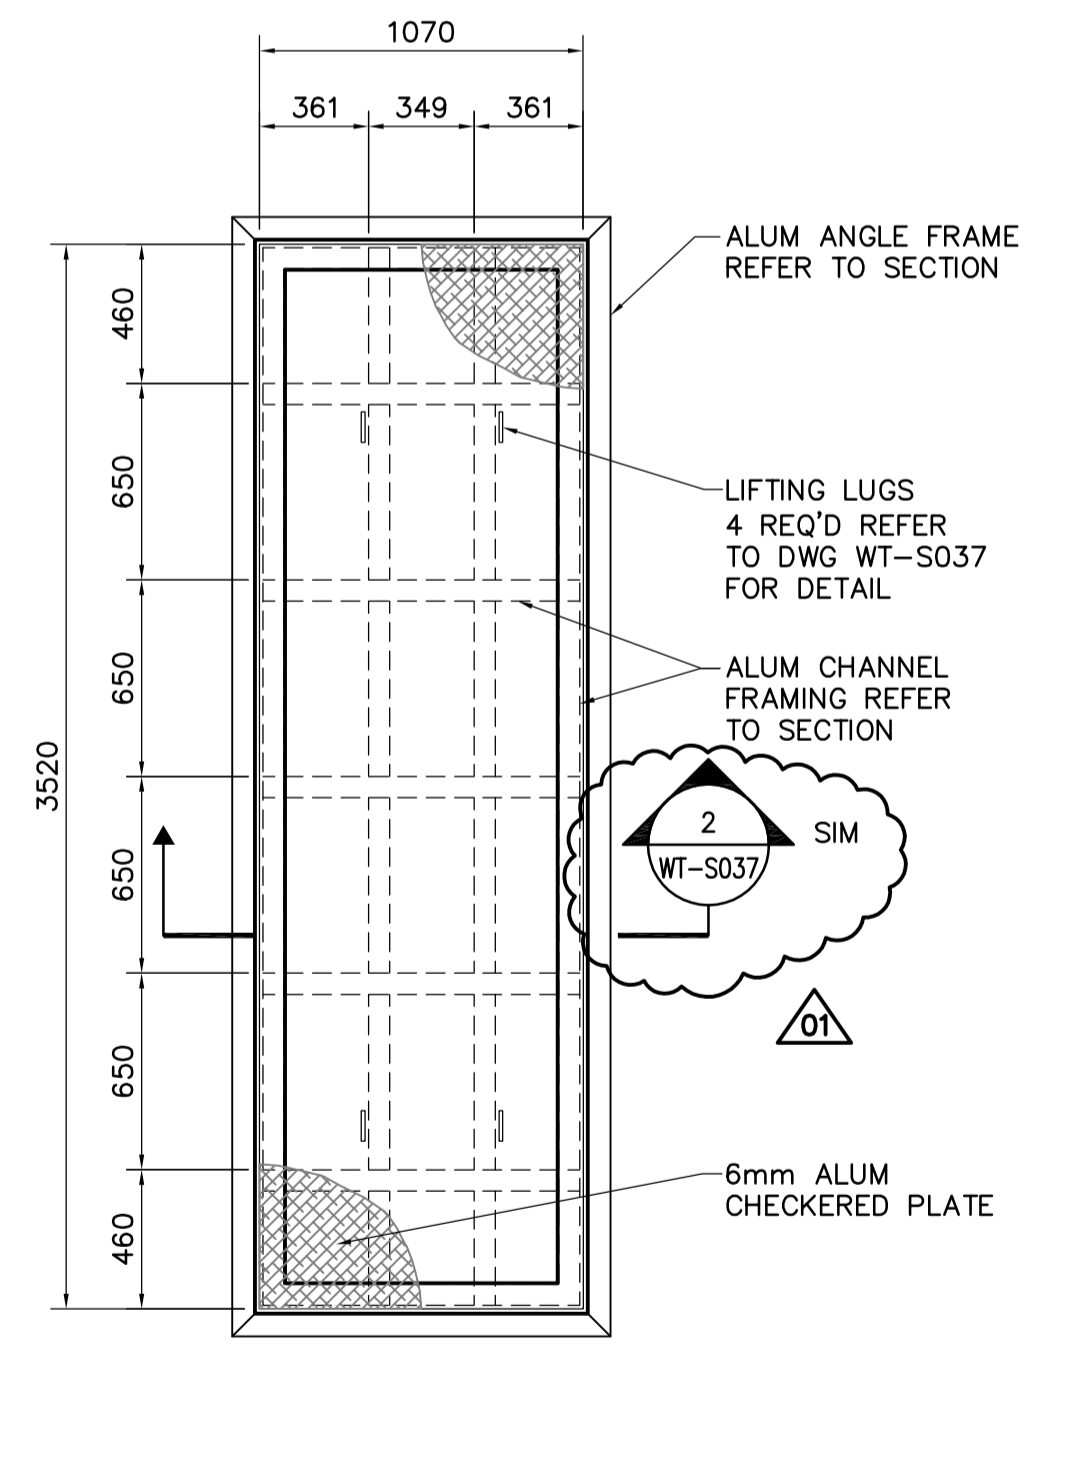

TYPICAL PLAN OF GATE COVERS  
1:25

**FOR INFORMATION ONLY - NOT IN CONTRACT**  
(EXCEPT AS NOTED)

**APECM**  
Certificate of Authorization  
Earth Tech Canada Inc.  
No. 730 Expiry: April 30, 2006

B.M. ELEV.			
DESIGNED BY	GGP	CHECKED BY	MK
DRAWN BY	C.T.	APPROVED BY	AHL
HOR. SCALE:		RELEASED FOR CONSTRUCTION BY:	R. SOROKOWSKI
VERTICAL SCALE:		DATE	2005-04-17
NO.	REVISIONS	DATE	BY
01	166-2005 ADDENDUM 1	05/05/06	C.T.
00	ISSUED FOR TENDER	05/04/17	GGP

**CH2MHILL**  
Frederickson Cooper  
ARCHITECTS

**EarthTech**  
A Technet International Ltd. Company

ENGINEER'S SEAL  
ORIGINAL SIGNED BY  
R.B. ERIC  
2005/04/17  
CONSULTANT DRAWING NO.  
WT-S036

**THE CITY OF WINNIPEG**  
WATER AND WASTE DEPARTMENT  
ENGINEERING DIVISION

**WATER TREATMENT PLANT  
CLEARWELL CONSTRUCTION**

STRUCTURAL  
INLET AND OUTLET BUILDINGS  
COVERS PLANS

CITY FILE NUMBER  
SHEET OF  
CITY DRAWING NUMBER  
1-060T-A-S0036-001-01D