




GEOTEXTILE A
 2 METERS INTO ROOF AT PERIMETER
 2 LAYERS 6 MIL POLY SLIP SHEET
 2 METERS INTO ROOF AT PERIMETER
 GEOTEXTILE 'B'

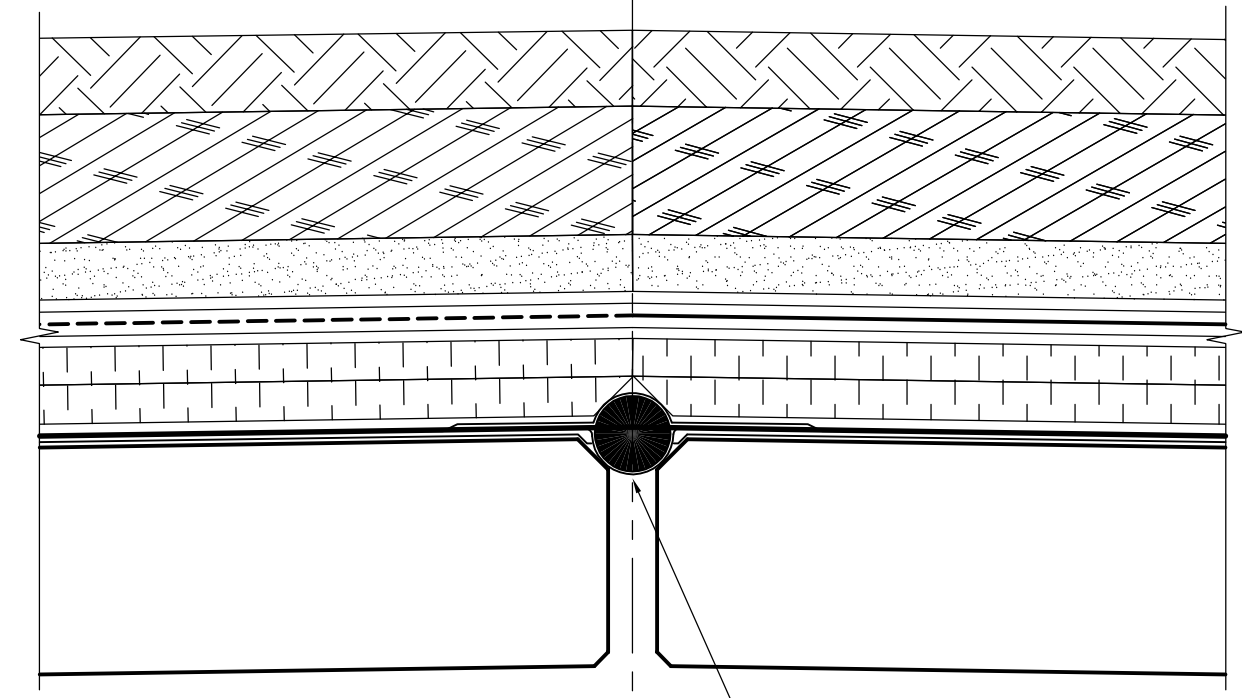

2 SECTION
 WT-S038 1:10

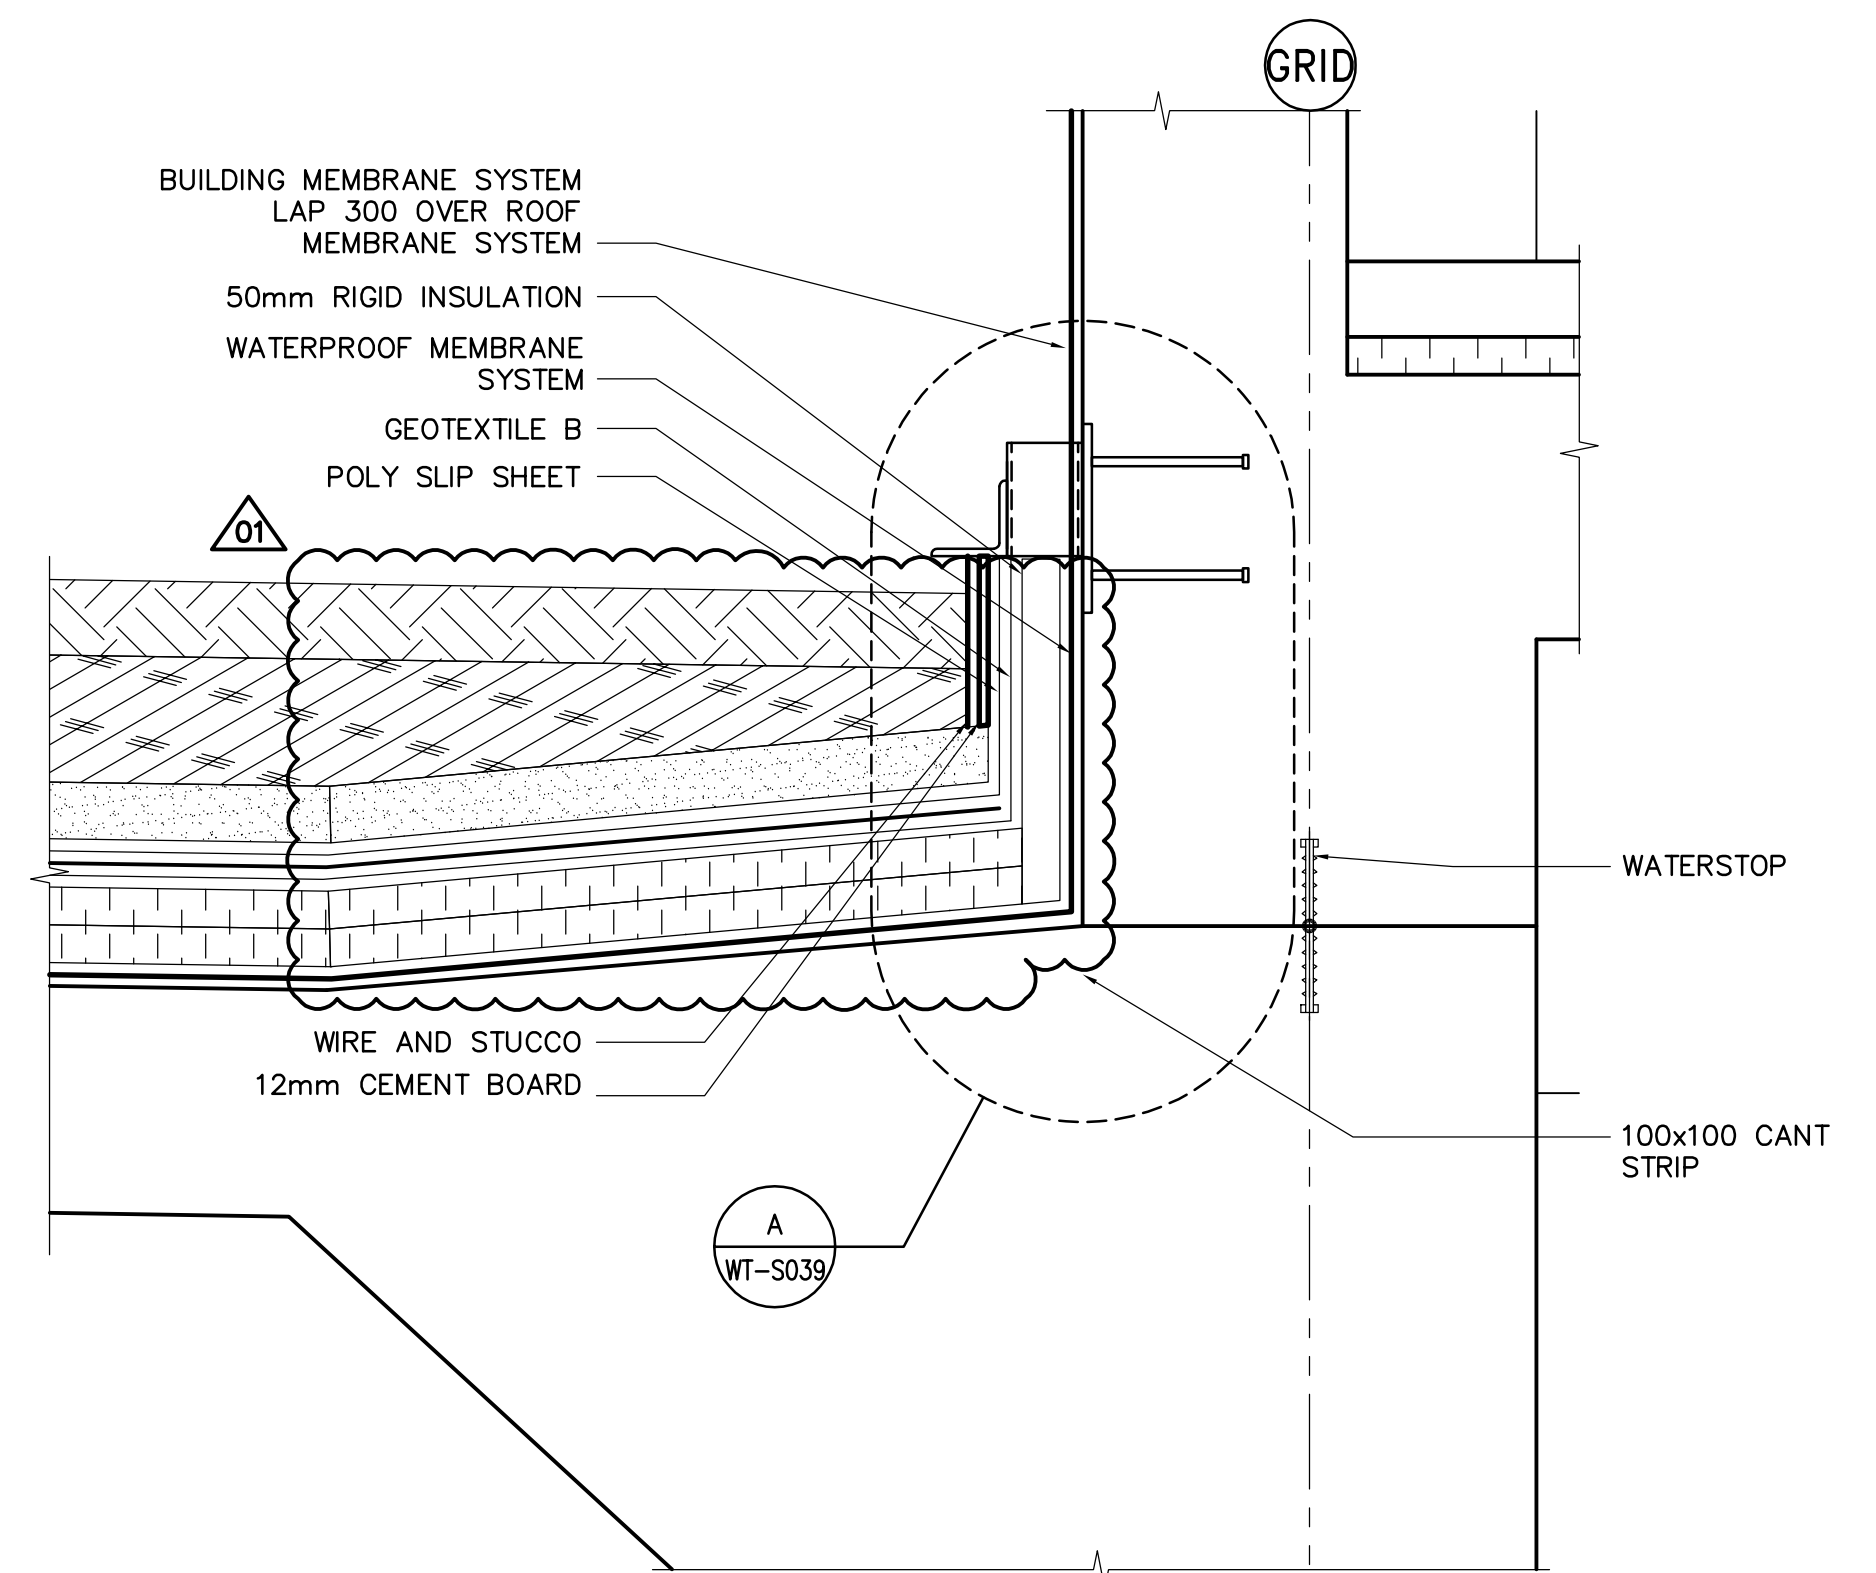

3 SECTION
 WT-S038 1:10

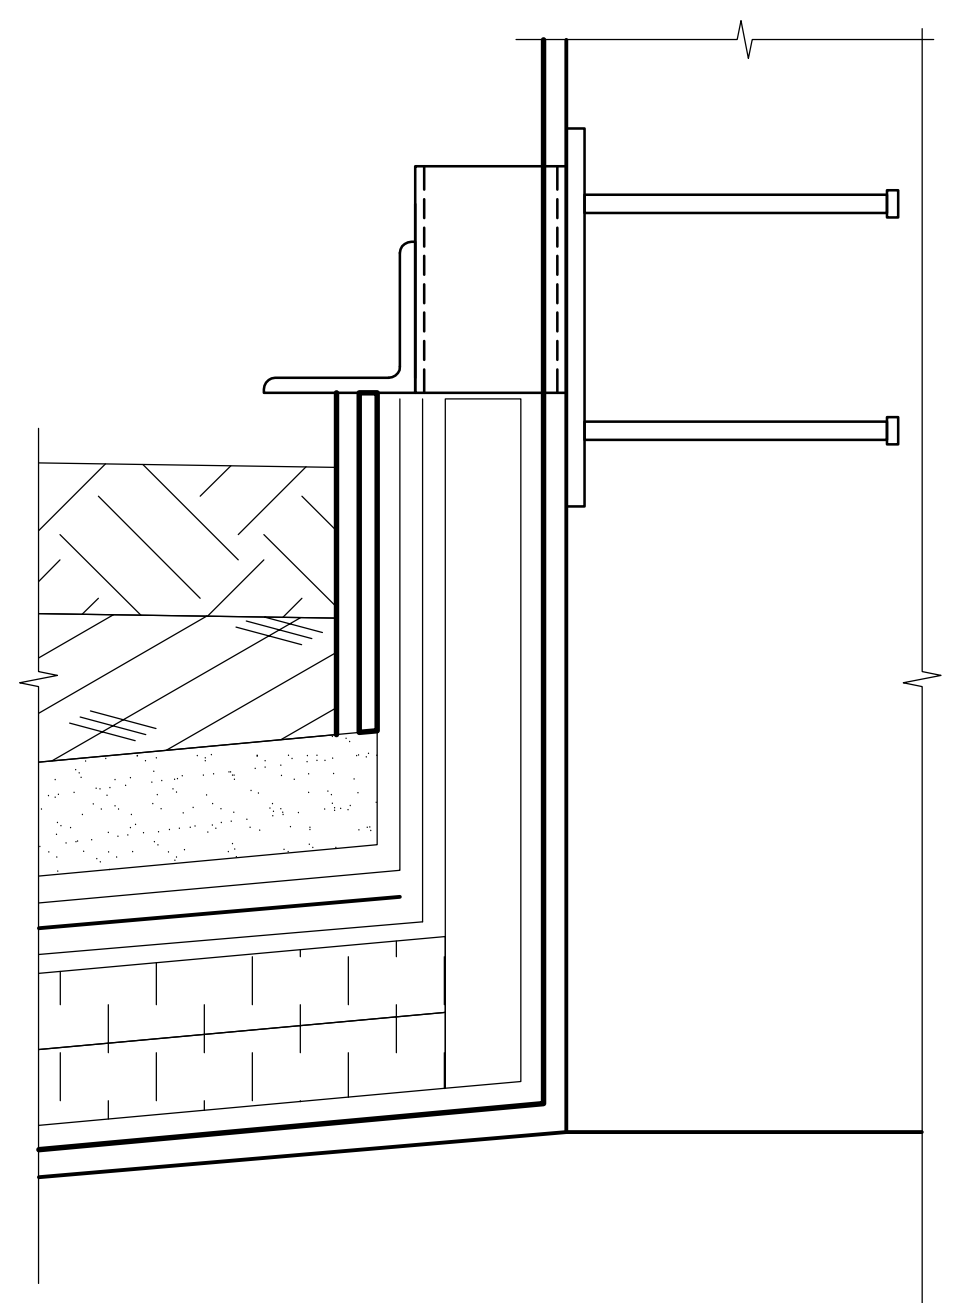

A DETAIL
 WT-S038 1:5

A DETAIL
 WT-S038 1:10

APEGM
 Certificate of Authorization
 Earth Tech Canada Inc.
 No. 730 Expiry: April 30, 2006

B.M. ELEV.			
01	166-2005 ADDENDUM 1	05/05/06	C.T.
00	ISSUED FOR TENDER	05/04/17	C.T.
NO.	REVISIONS	DATE	BY

CH2MHILL Frederickson Cooper ARCHITECTS	EarthTech A Tech International Ltd. Company
DESIGNED BY: FK	CHECKED BY: MK
DRAWN BY: C.T. / WDB	APPROVED BY: AHL
HOR. SCALE: AS NOTED	RELEASED FOR CONSTRUCTION BY: R. SOROKOWSKI
VERTICAL SCALE:	DATE: 2005-04-17
DATE: 2005/03/09	DATE: 2005-04-17

ENGINEER'S SEAL
 ORIGINAL SIGNED BY: F.A. KEMP
 2005/04/17
 CONSULTANT DRAWING NO. WT-S039

THE CITY OF WINNIPEG
 WATER AND WASTE DEPARTMENT
 ENGINEERING DIVISION

WATER TREATMENT PLANT CLEARWELL CONSTRUCTION

STRUCTURAL ROOF DRAINAGE SECTIONS AND DETAILS

CITY FILE NUMBER
 SHEET OF
 CITY DRAWING NUMBER
 1-060T-A-S0039-001-01D