SHEET: COW-A1 (03/2005)

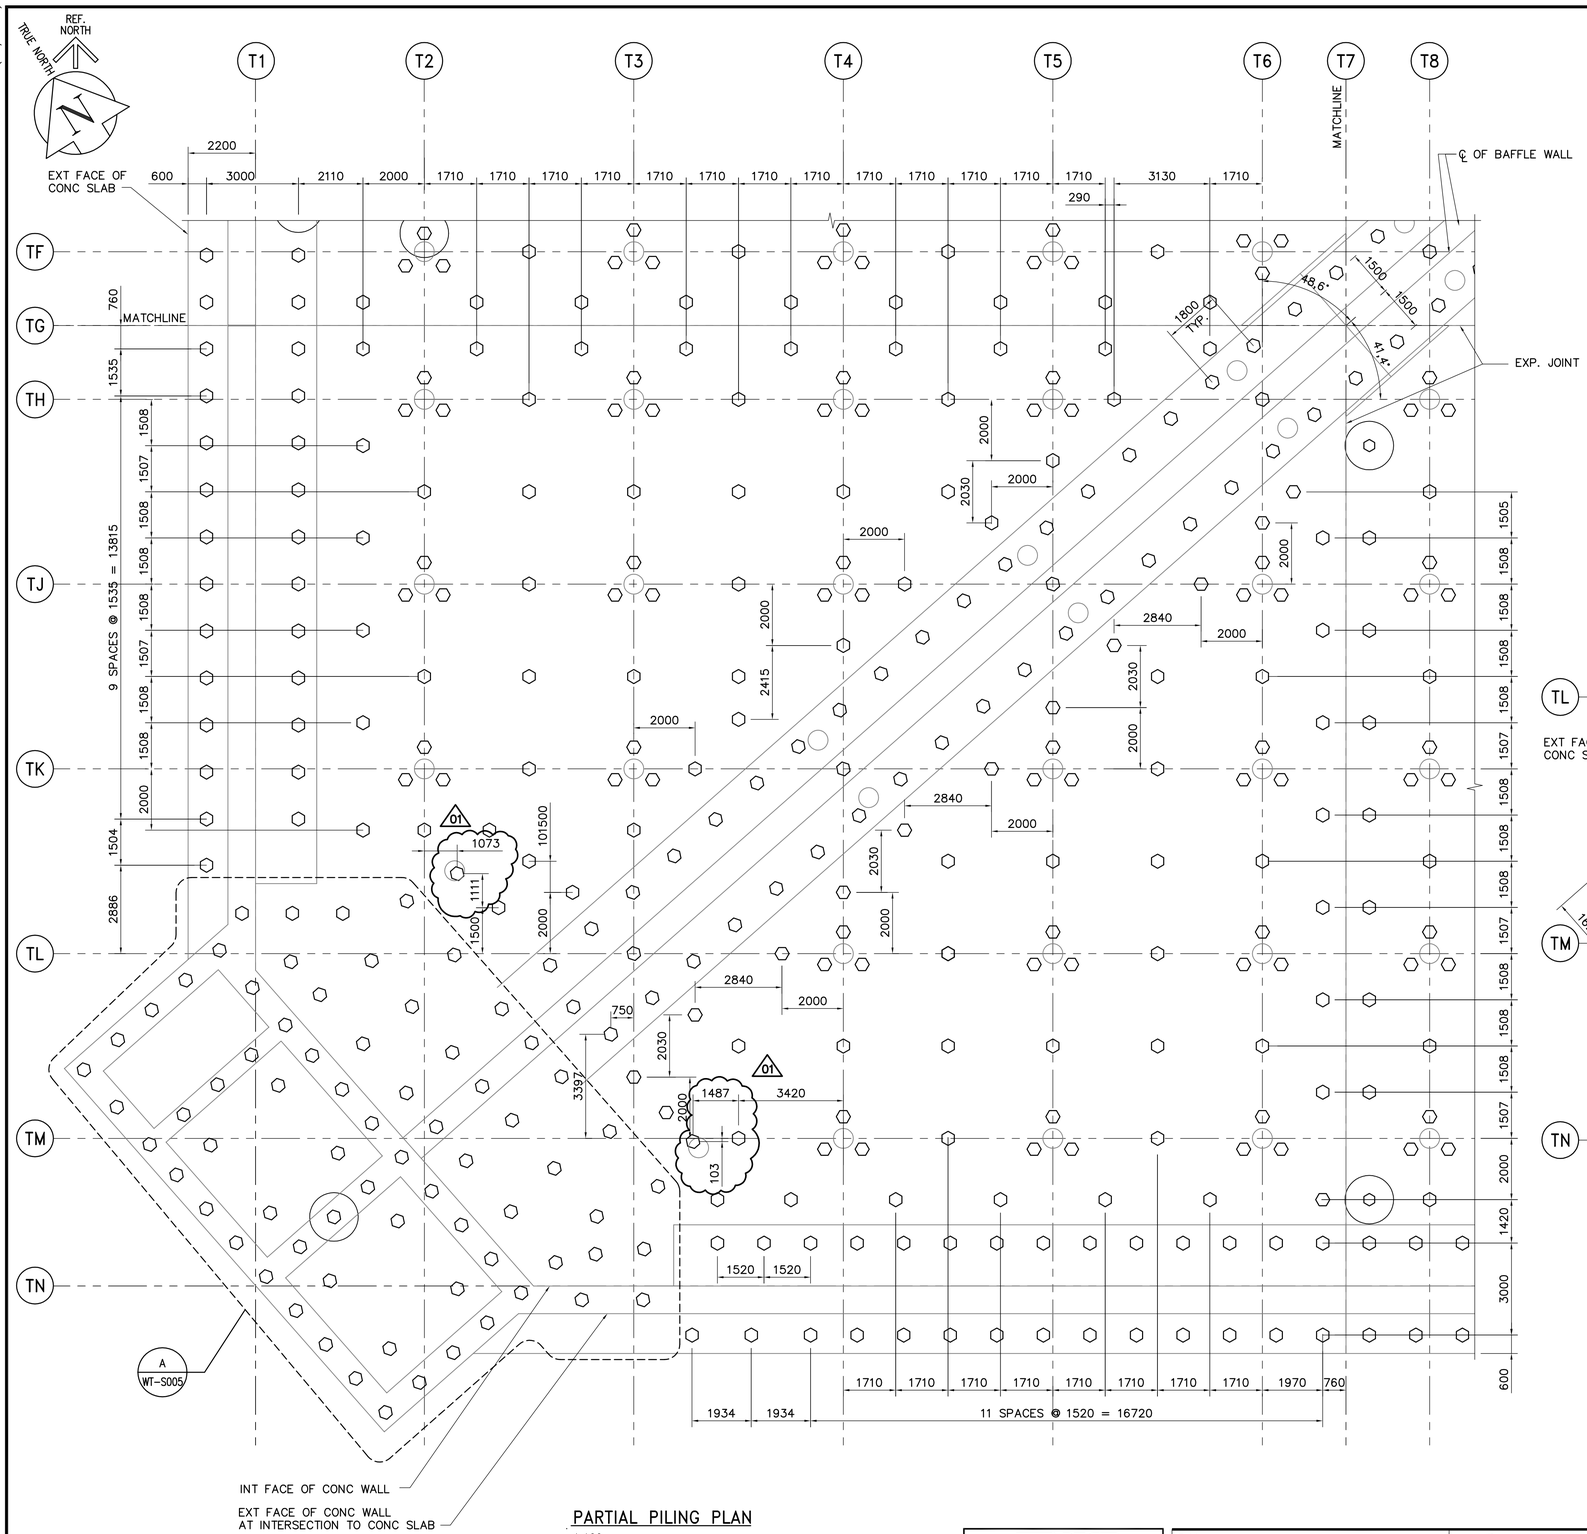

PARTIAL PILING PLAN
1:100

LEGEND

⬡ – EXISTING TEST PRECAST PILES

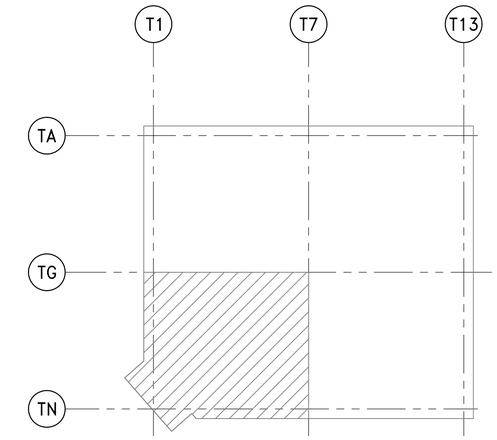

KEY PLAN
N.T.S.

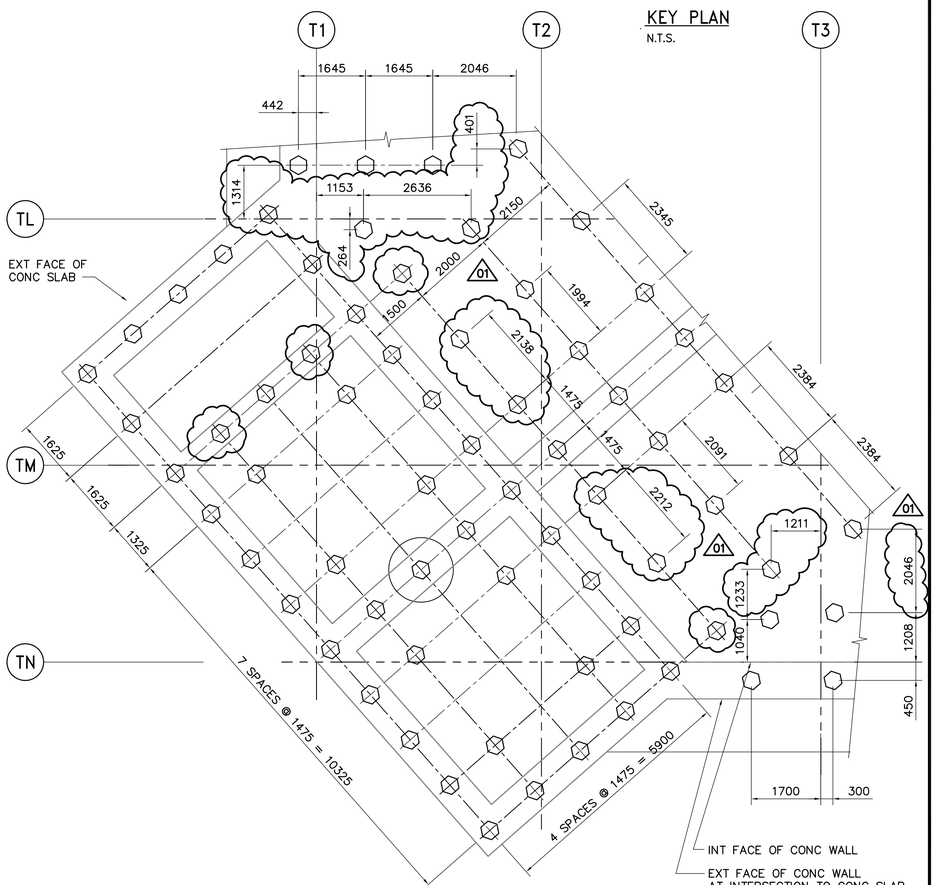

A WT-S005 DETAIL
1:75

DRAWING NOTES:
1. ALL PILES ARE 400 DIAMETER PRECAST UNLESS NOTED OTHERWISE.
2. REFER TO DRAWING WT-S002 FOR GRID LINE DIMENSIONS.
3. REFER TO DRAWING WT-S003 FOR 3 PILE DETAIL.
4. PILE CUT OFF ELEVATIONS VARY 300±.

APEGM
Certificate of Authorization
Earth Tech Canada Inc.
No. 730 Expiry: April 30, 2006

NO.	REVISIONS	DATE	BY
01	166-2005 ADDENDUM 1	05/05/06	C.T.
00	ISSUED FOR TENDER	05/04/17	C.T.

B.M. ELEV.

CH2MHILL / Fredericksen Cooper ARCHITECTS / EarthTech (A Tyco International Ltd. Company)

DESIGNED BY	FK	CHECKED BY	MK
DRAWN BY	C.T.	APPROVED BY	AHL
HOR. SCALE:	AS NOTED	RELEASED FOR CONSTRUCTION BY:	R. SOROKOWSKI
VERTICAL SCALE:			
DATE	2005/02/08	DATE	2005-04-17

ENGINEER'S SEAL
ORIGINAL SIGNED BY
F.A. KEMP
2005/04/17

CONSULTANT DRAWING NO.
WT-S005

THE CITY OF WINNIPEG
Winnipeg
WATER AND WASTE DEPARTMENT
ENGINEERING DIVISION

WATER TREATMENT PLANT
CLEARWELL CONSTRUCTION

CITY FILE NUMBER
SHEET OF

STRUCTURAL
PARTIAL PILING PLAN

CITY DRAWING NUMBER
1-0601T-B-S0005-001-01D

05/06/05 09:38am corey.thiessen L:\work\79000\79538\02a-CAD\IND\CONTR\WT-S005.dwg Layout:Layout1