



**FOUNDATION SLAB REINFORCING PLAN**  
1:150

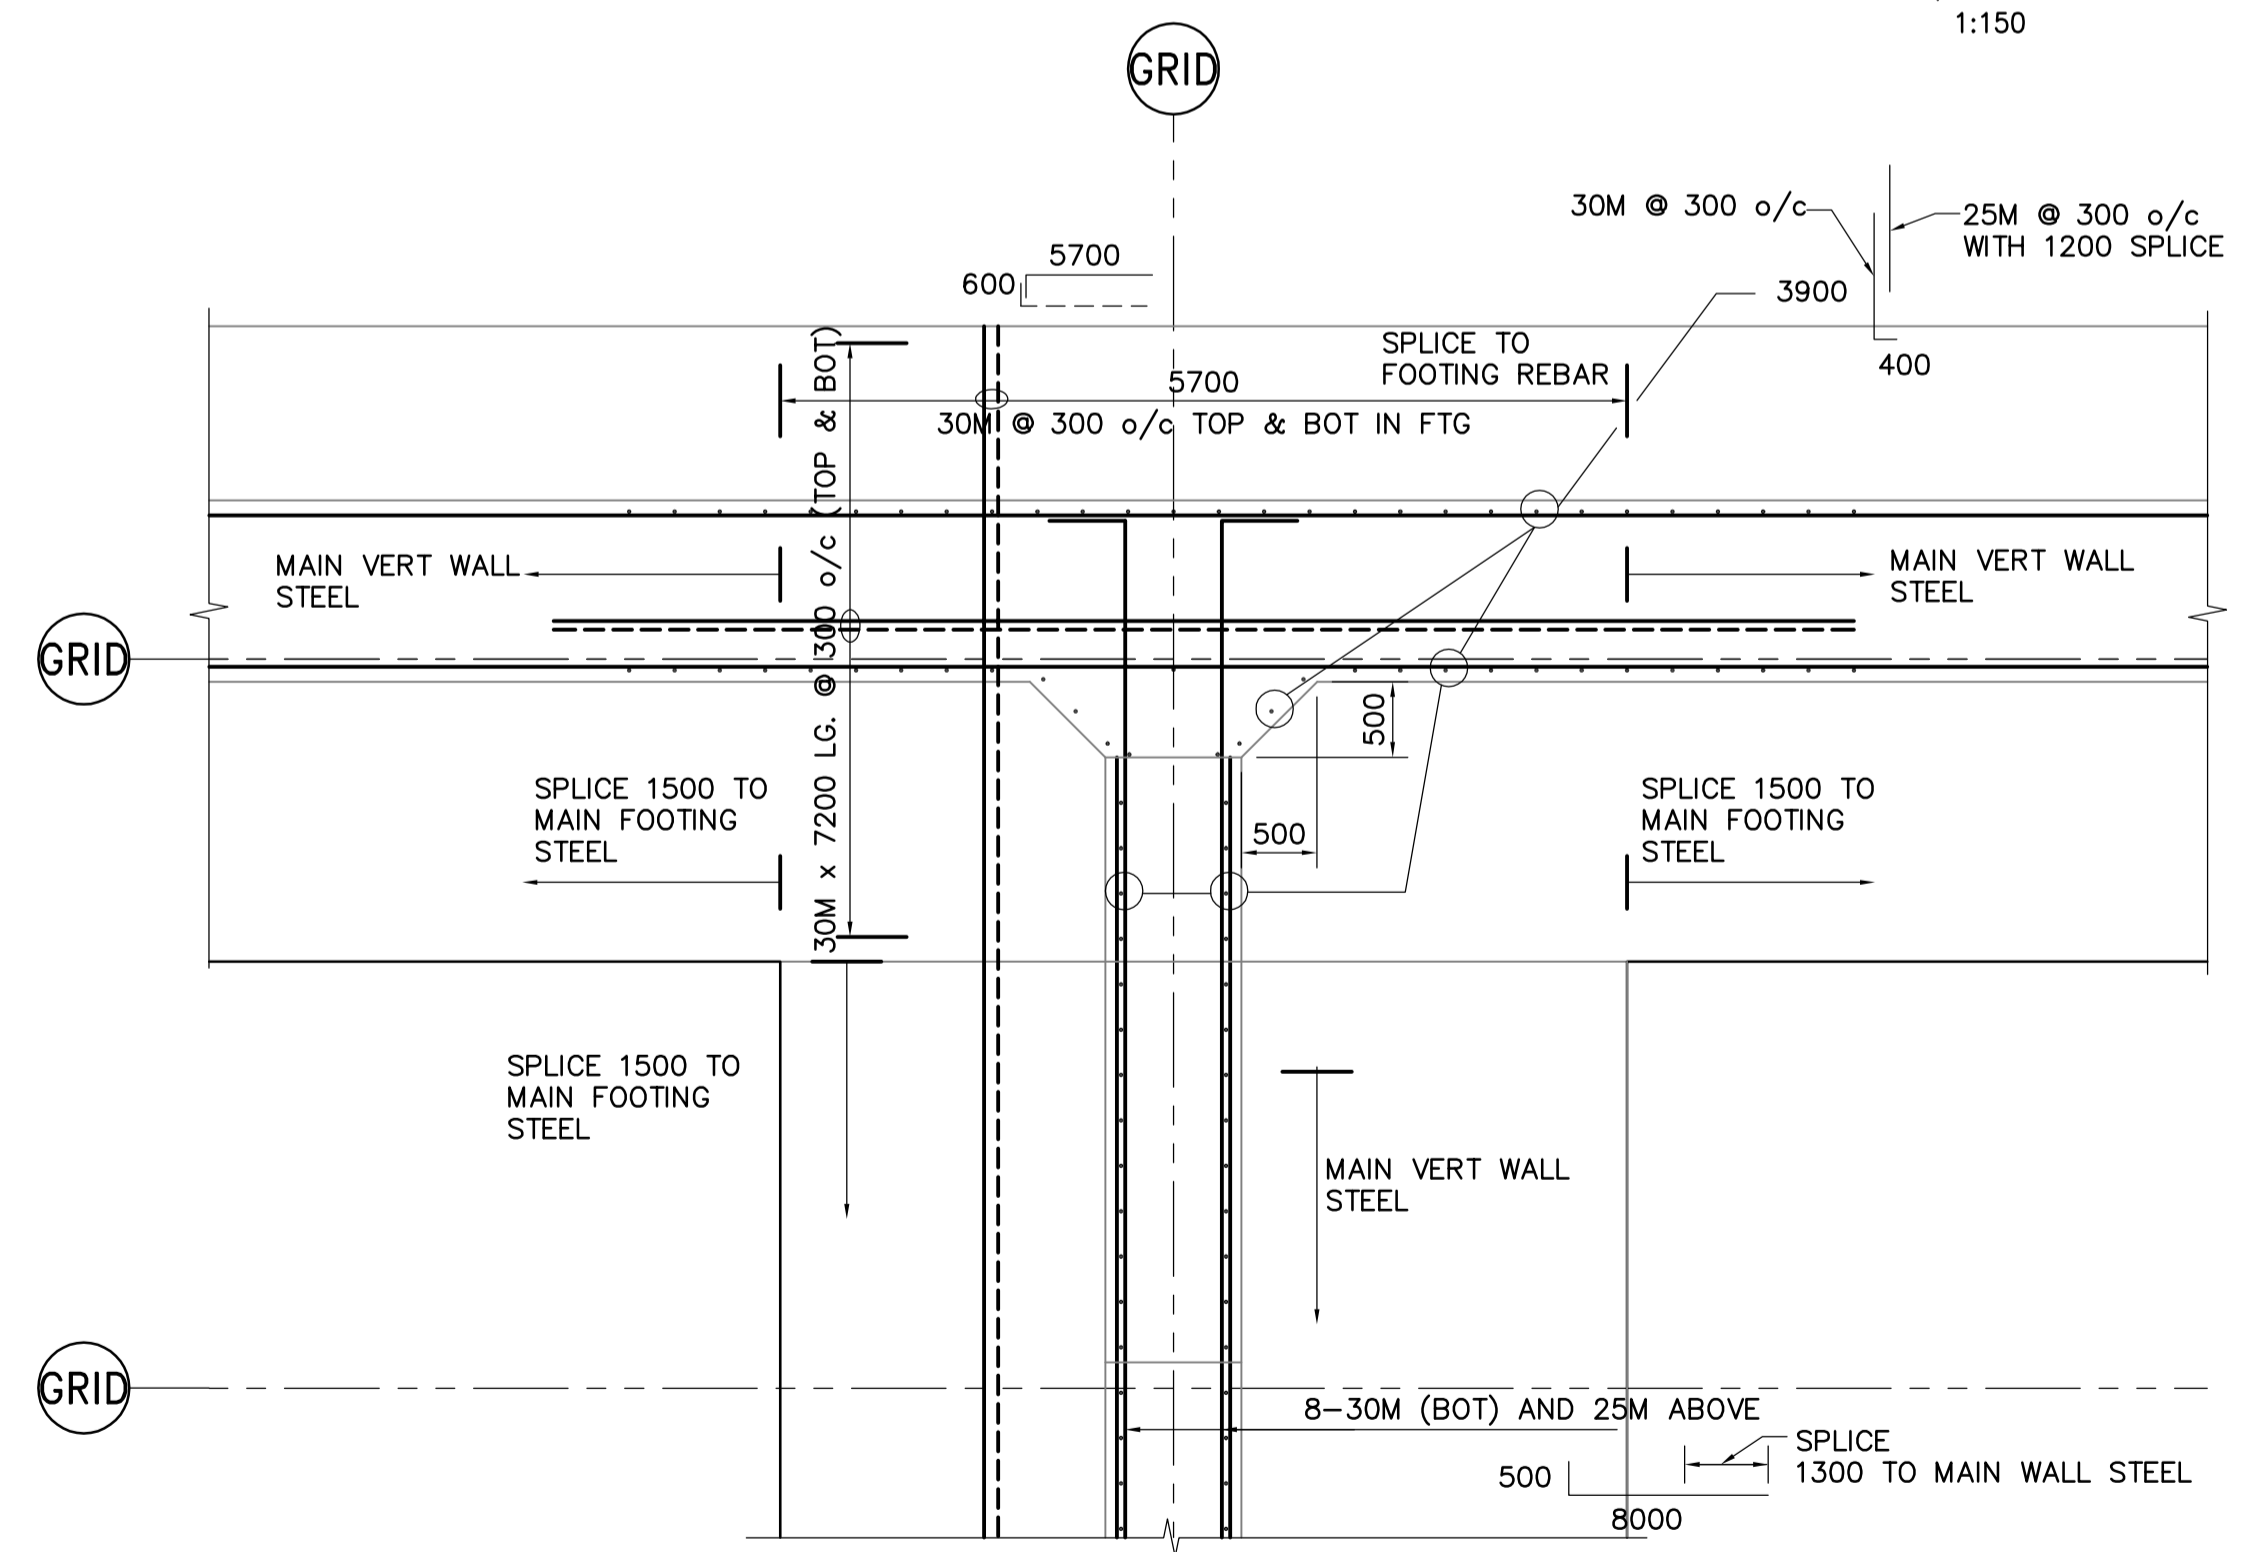

**A TYPICAL FOOTING REINFORCING AT INTERSECTION**  
WT-S010 1:20  
- AT GRID LINES TA & T10, TD & T13.

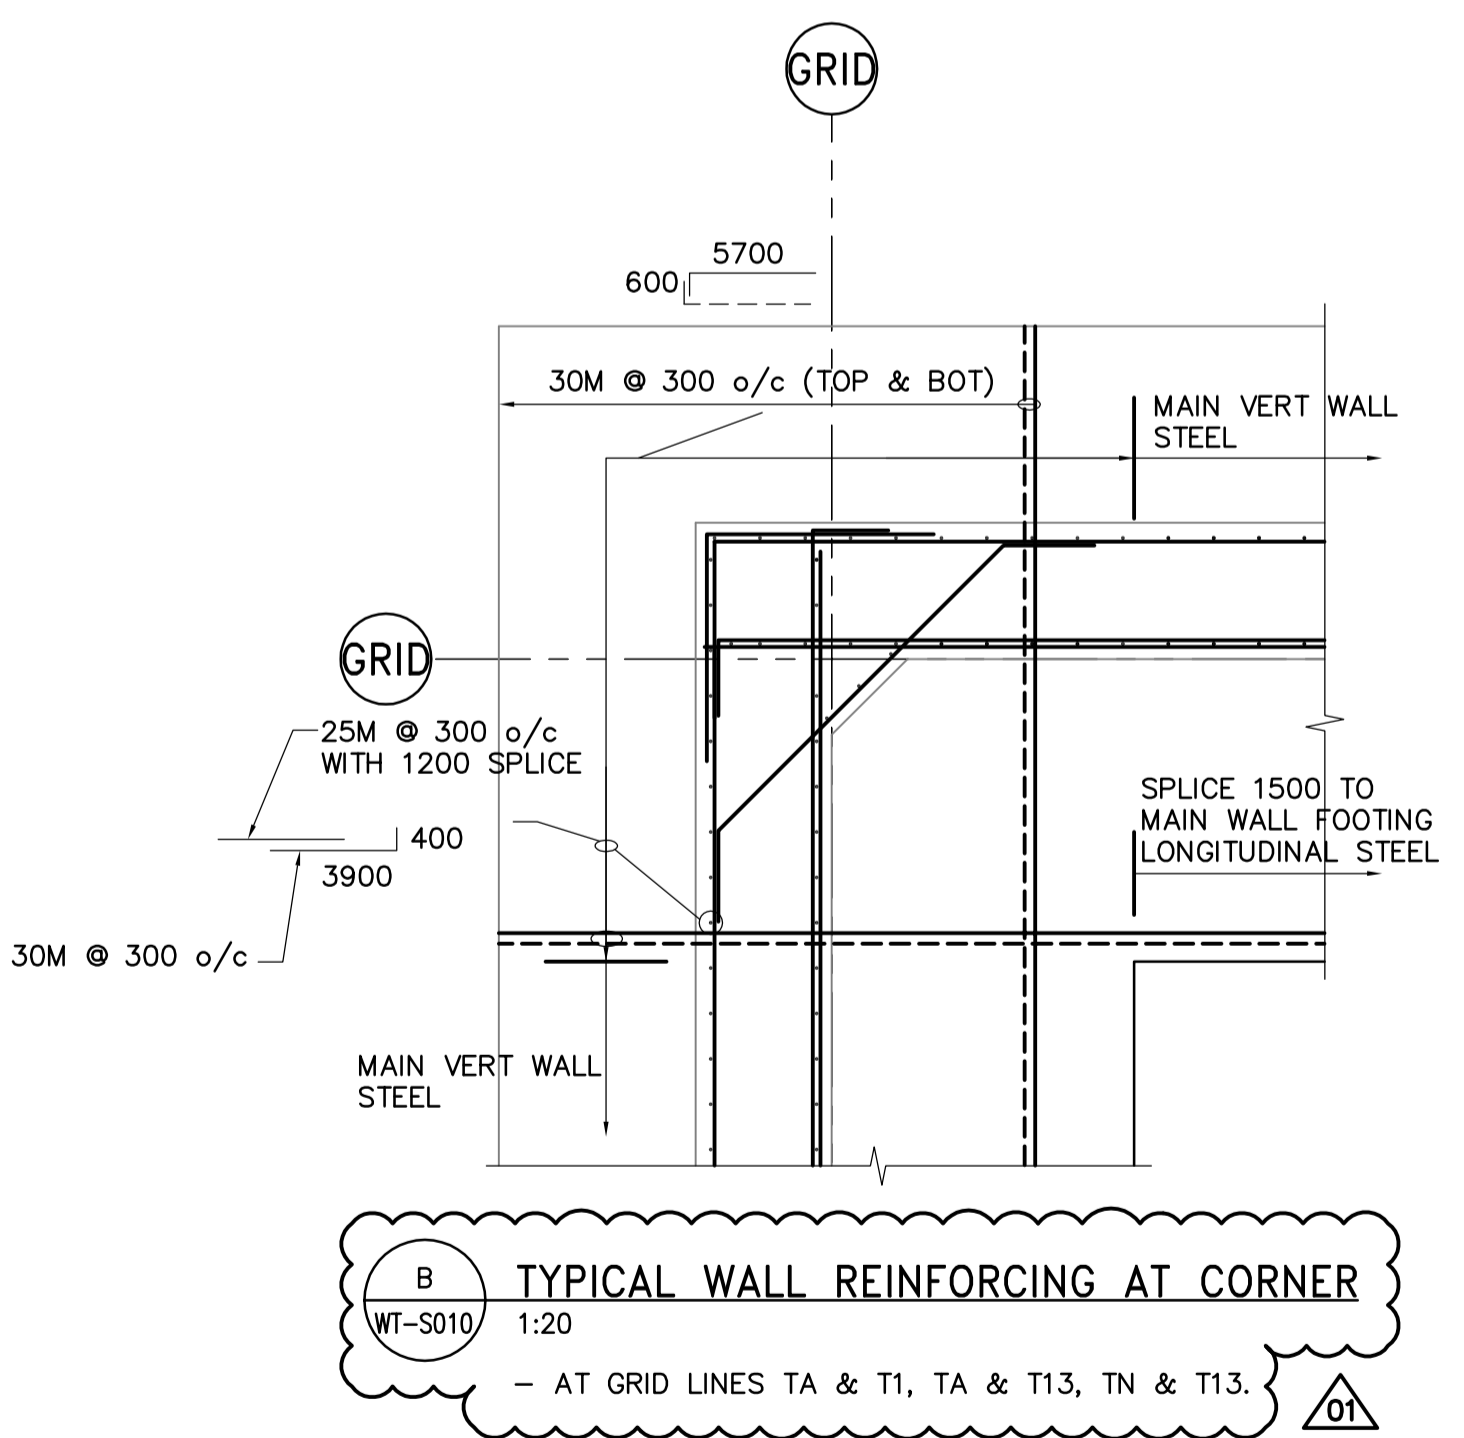

**B TYPICAL WALL REINFORCING AT CORNER**  
WT-S010 1:20  
- AT GRID LINES TA & T1, TA & T13, TN & T13.

- DRAWING NOTES:
1. REFER TO DRAWING WT-S001 FOR GENERAL NOTES.
  2. REFER TO DRAWING WT-S002 FOR GRID LINE DIMENSIONS.
  3. REFER TO DRAWING WT-S020 FOR EXPANSION AND CONSTRUCTION JOINT DETAILS.

**APEGM**  
Certificate of Authorization  
Earth Tech Canada Inc.  
No. 730 Expiry: April 30, 2006

B.M. ELEV.			
DESIGNED BY	FK	CHECKED BY	MK
DRAWN BY	C.T.	APPROVED BY	AHL
HOR. SCALE:	AS NOTED	RELEASED FOR CONSTRUCTION BY:	R. SOROKOWSKI
VERTICAL SCALE:		DATE	2005-04-17
DATE	2005/02/23	DATE	2005-04-17

**CH2MHILL**  
Frederickson Cooper ARCHITECTS

**EarthTech**  
A Tech International U.S. Company

ENGINEER'S SEAL  
ORIGINAL SIGNED BY  
F.A. KEMP & ERIC  
2005/04/17

CONSULTANT DRAWING NO.  
WT-S008

**THE CITY OF WINNIPEG**  
WATER AND WASTE DEPARTMENT  
ENGINEERING DIVISION

**WATER TREATMENT PLANT CLEARWELL CONSTRUCTION**

STRUCTURAL  
FOUNDATION SLAB REINFORCING PLAN

CITY FILE NUMBER  
SHEET OF  
CITY DRAWING NUMBER  
1-060T-B-S0008-001-01D