
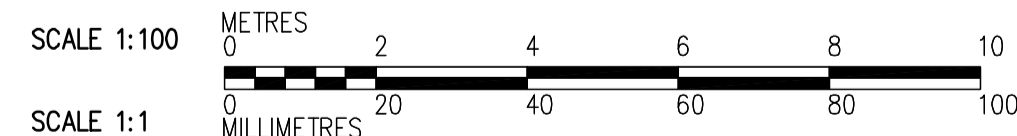


LOWER LEVEL PLAN
1:100

- NOTES:**
- DESIGN LIVE LOAD IS 14.4 kPa. CONSTRUCTION LIVE PLUS SHORING LOADS MAY NOT EXCEED DESIGN LIVE LOAD.
 - FOR COLUMN AND BEAM SCHEDULE SEE DWG WA-S0515.
 - FOR WALL CORNERS REINF, SEE (4) UNO. WB-S0452
 - BACK FILL BOTH SIDES OF WALL SIMULTANEOUSLY.
 - ENCASE ALL PIPING UNDER BUILDING IN CONCRETE. SEE (1), (2), (4) WB-S0458, WB-S0458, WB-S0458
 - THRUST RESTRAINT AND PIPING INSTALLED UNDER SEPARATE CONTRACT. APPROXIMATE LOCATION SHOWN. TOTAL CONCRETE FOR TENDER: 3m² x 200 HIGH.
 - APPROXIMATE LOCATION OF EQUIPMENT PADS SHOWN. TOTAL CONCRETE FOR TENDER: 6m² x 200mm HIGH.

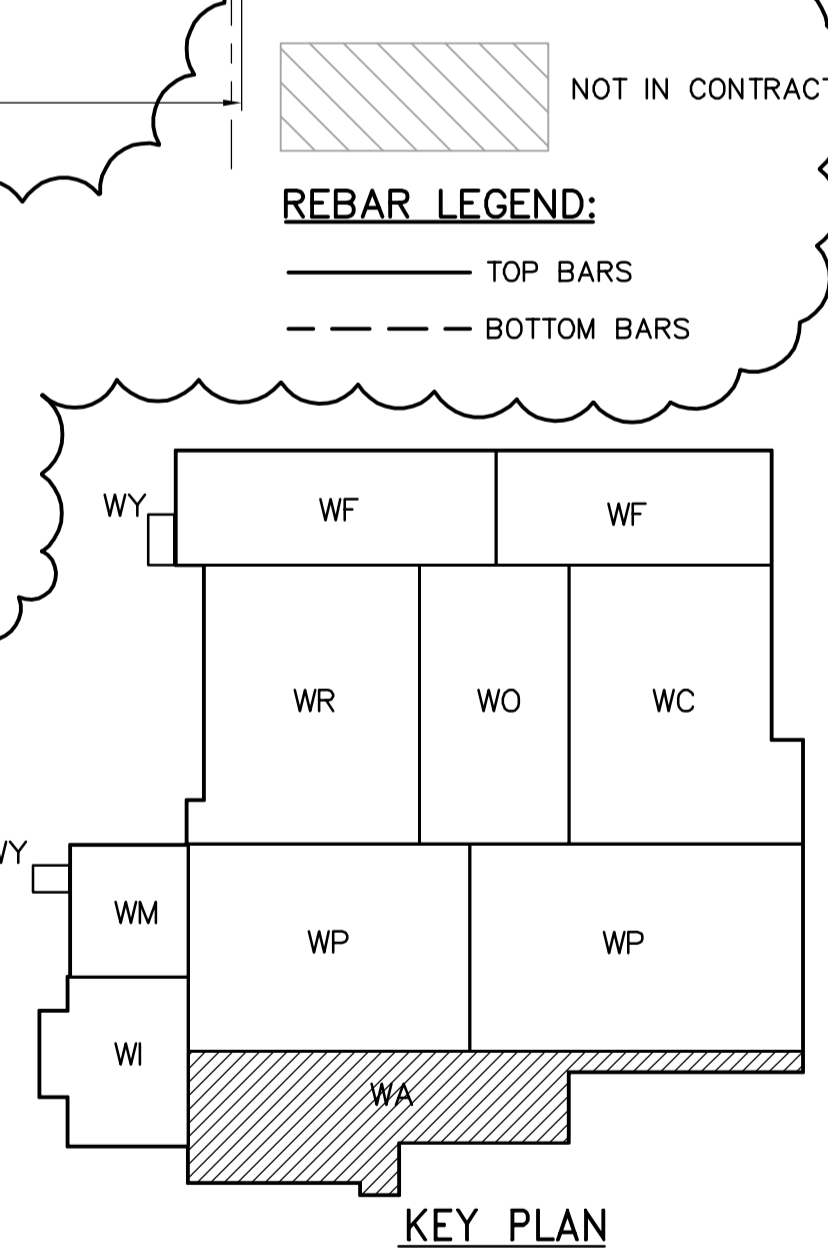

 Certificate of Authorization CH2M HILL Canada Ltd. No. 1441 Expiry: April 30, 2006	B.M. ELEV.	 Frederickson Cooper ARCHITECTS	 A Tyco International Ltd. Company	ENGINEER'S SEAL ORIGINAL SIGNED BY D. KRUGER 2006/02/06	 THE CITY OF WINNIPEG WATER AND WASTE DEPARTMENT ENGINEERING DIVISION WATER TREATMENT PLANT ADMINISTRATION FOUNDATIONS AND CONCRETE STRUCTURES STRUCTURAL ADMINISTRATION AREA LOWER LEVEL PLAN	CITY FILE NUMBER SHEET OF																									
	<table border="1"> <tr> <td>01</td> <td>583-2005 ADDENDUM 3</td> <td>06/03/10</td> <td>EL</td> </tr> <tr> <td>00</td> <td>ISSUED FOR TENDER</td> <td>2006/02/03</td> <td>MC</td> </tr> <tr> <td>NO.</td> <td>REVISIONS</td> <td>DATE</td> <td>BY</td> </tr> </table>	01	583-2005 ADDENDUM 3	06/03/10		EL	00	ISSUED FOR TENDER	2006/02/03	MC	NO.	REVISIONS	DATE	BY	<table border="1"> <tr> <td>DESIGNED BY</td> <td>MC</td> <td>CHECKED BY</td> <td>AP</td> </tr> <tr> <td>DRAWN BY</td> <td>RL</td> <td>APPROVED BY</td> <td>DJT</td> </tr> <tr> <td>SCALE:</td> <td>1:100</td> <td>RELEASED FOR CONSTRUCTION BY:</td> <td>R. SOROKOWSKI</td> </tr> <tr> <td>DATE</td> <td>2005/10/11</td> <td>DATE</td> <td>2006/02/08</td> </tr> </table>	DESIGNED BY	MC	CHECKED BY	AP	DRAWN BY	RL	APPROVED BY	DJT	SCALE:	1:100	RELEASED FOR CONSTRUCTION BY:	R. SOROKOWSKI	DATE	2005/10/11	DATE	2006/02/08
01	583-2005 ADDENDUM 3	06/03/10	EL																												
00	ISSUED FOR TENDER	2006/02/03	MC																												
NO.	REVISIONS	DATE	BY																												
DESIGNED BY	MC	CHECKED BY	AP																												
DRAWN BY	RL	APPROVED BY	DJT																												
SCALE:	1:100	RELEASED FOR CONSTRUCTION BY:	R. SOROKOWSKI																												
DATE	2005/10/11	DATE	2006/02/08																												