


SECTION H
WA-S0101 1:50


WA-S0101, WA-S0111, WA-S0121,
WA-S0131, WA-S0141, A-S0146

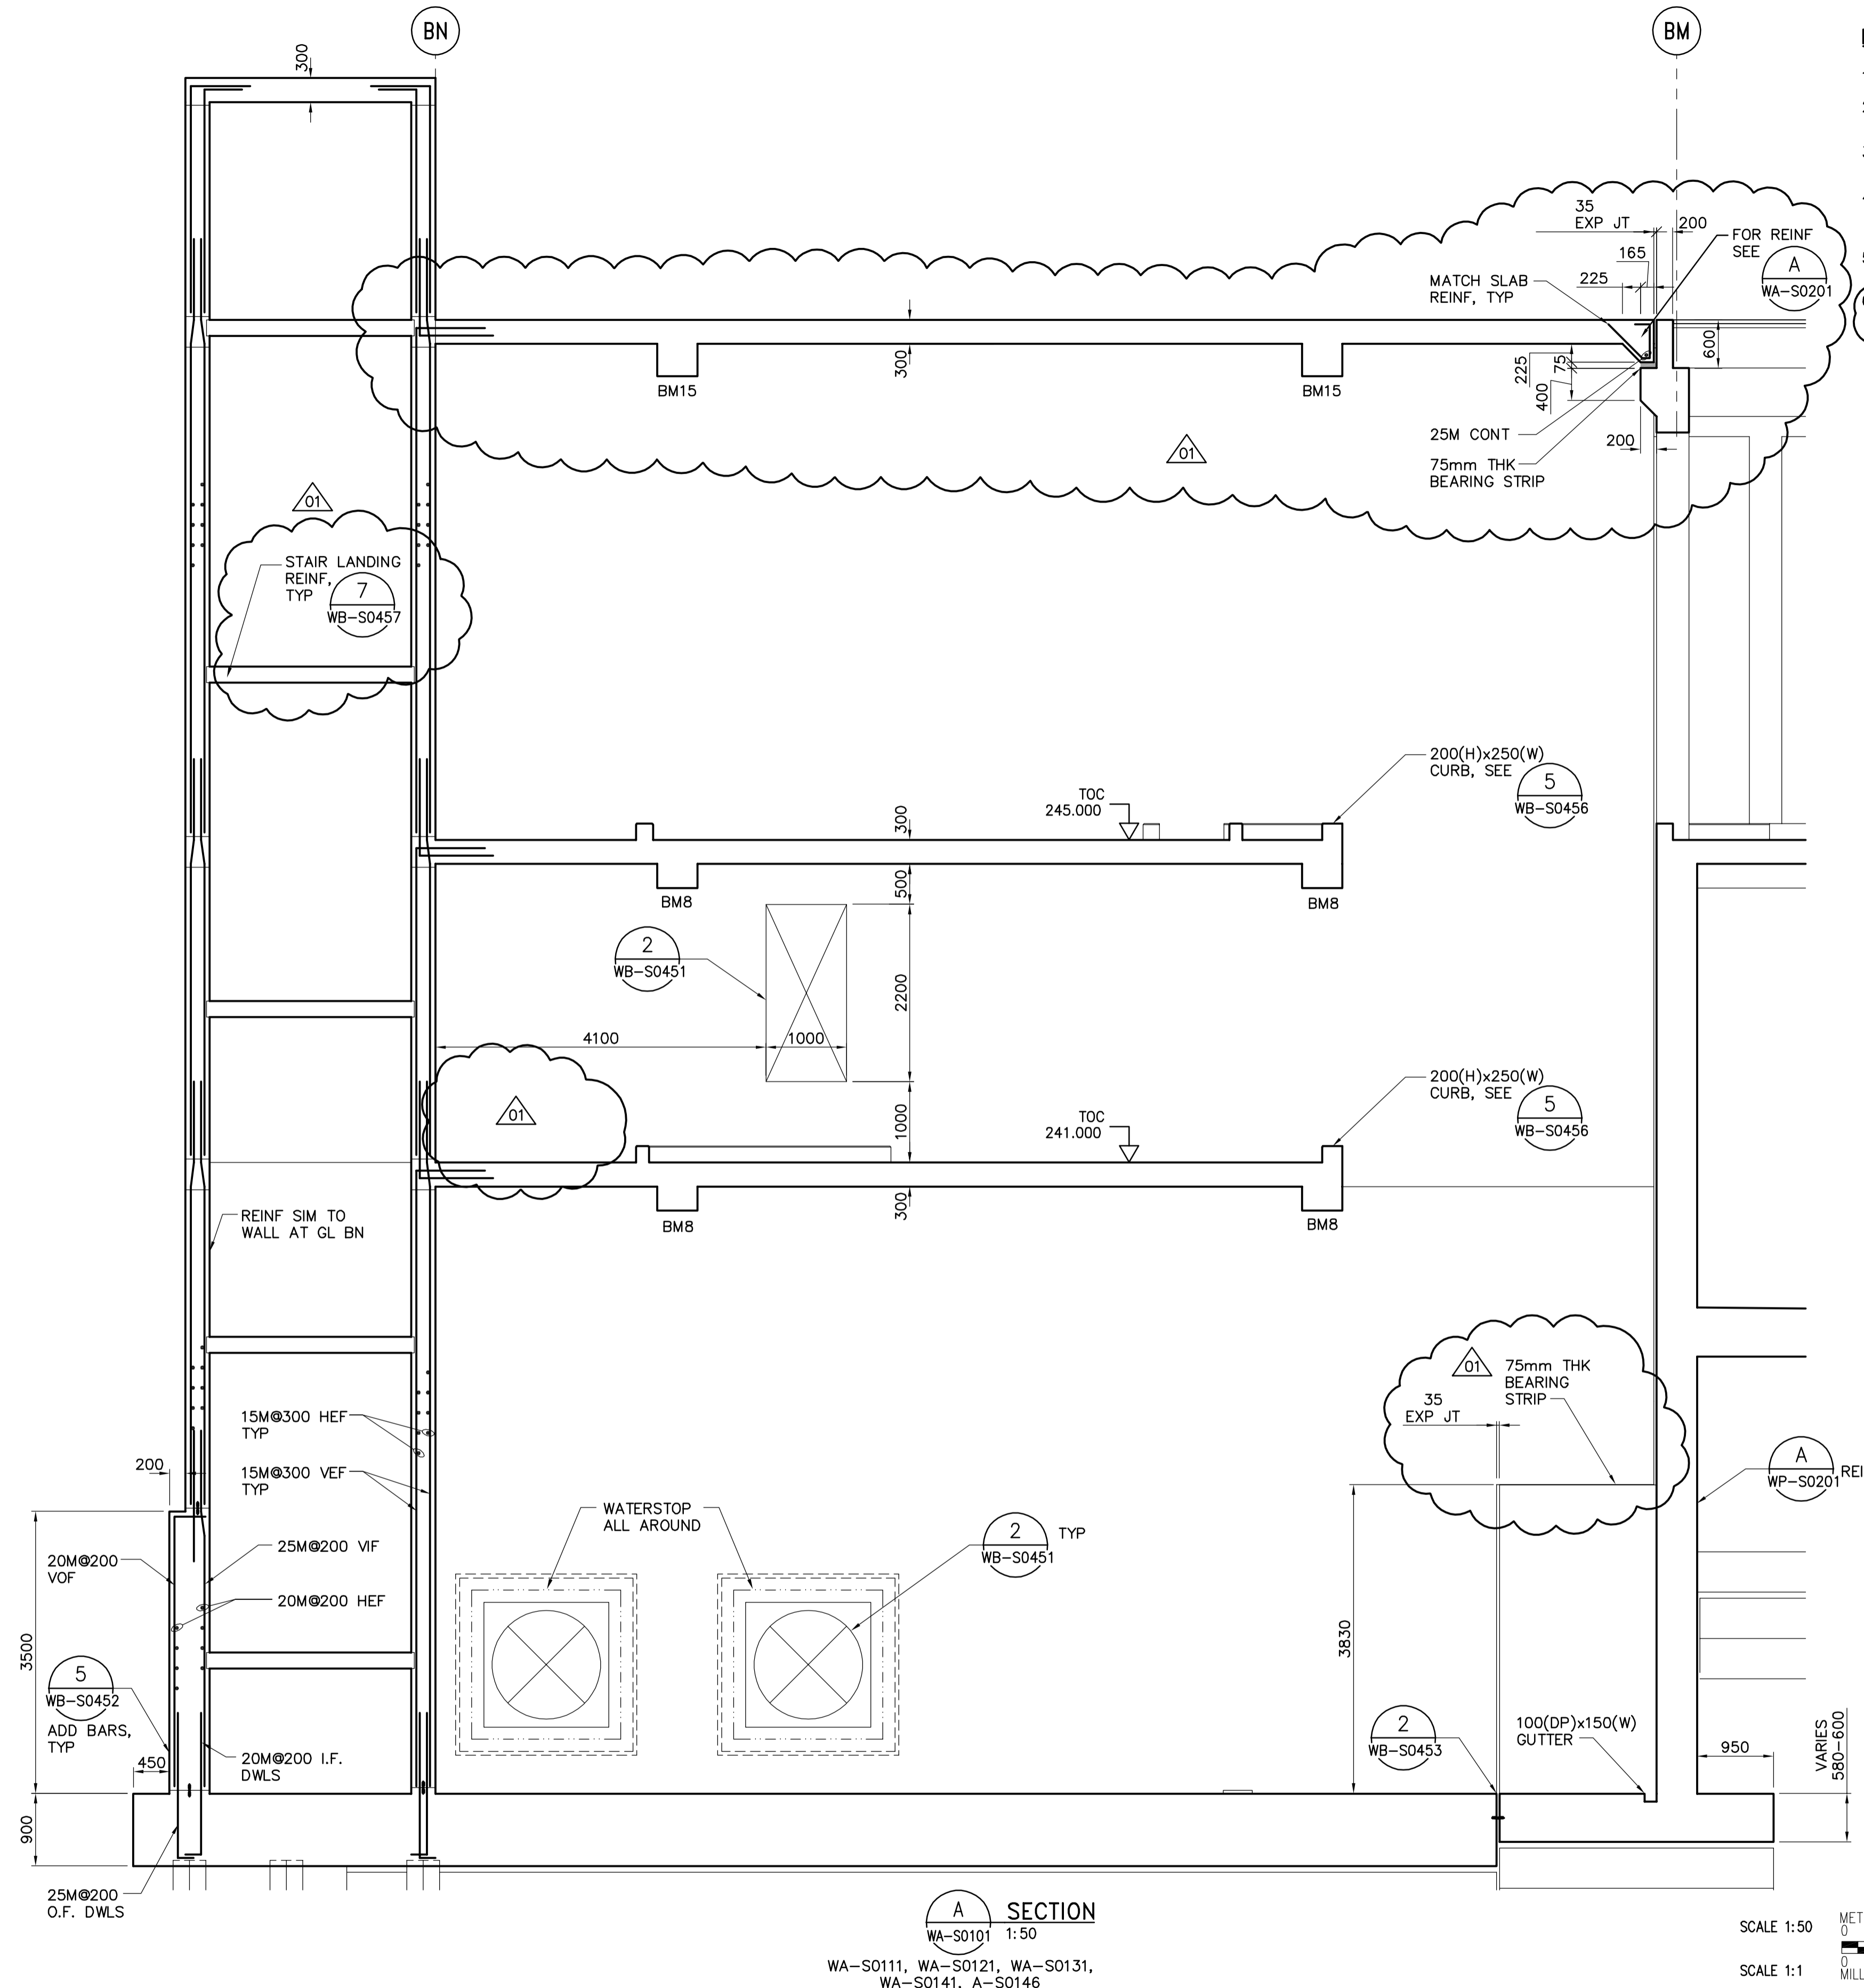

SECTION A
WA-S0101 1:50

WA-S0111, WA-S0121, WA-S0131,
WA-S0141, A-S0146

- NOTES:**
- SEE PLANS FOR SLAB REINFORCEMENT.
 - SEE DWG WA-S0515 FOR BEAM AND COLUMN SCHEDULES.
 - WATERPROOFING FROM EL. 233.170 TO 236.170 ALL AROUND.
 - SLIP SHEET AND PROTECTION BOARD FROM EL. 233.170 TO 236.170 ON NORTH WALL, EAST WALL, AND SOUTH WALL.
 - INSULATION FROM EL. 236.670 TO 232.270 ON SOUTH WALL AND EAST WALL.
 - FOR FOUNDATION WALL WATERPROOFING AND INSULATION REFER TO 3 WB-S0461

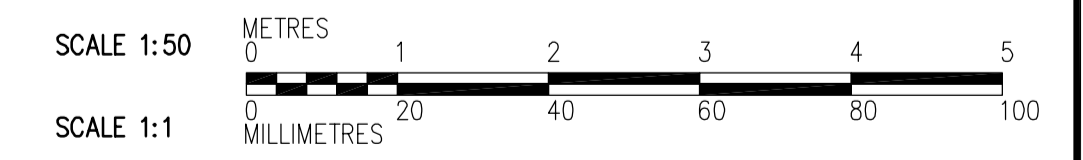

| NO. | REVISIONS | DATE | BY |
|-----|---------------------|------------|----|
| 01 | 583-2005 ADDENDUM 3 | 06/03/10 | EL |
| 00 | ISSUED FOR TENDER | 2006/02/03 | MC |

| DESIGNED BY | CHECKED BY |
|-------------|-------------------------------|
| MC | AP |
| DRAWN BY | APPROVED BY |
| RL | DJT |
| SCALE: | RELEASED FOR CONSTRUCTION BY: |
| 1:50 | R. SOROKOWSKI |
| DATE | DATE |
| 2005/08/04 | 2006/02/08 |

ENGINEER'S SEAL
ORIGINAL SIGNED BY
D. KRUGER
2006/02/06
CONSULTANT DRAWING NO.
WA-S0201

THE CITY OF WINNIPEG
WATER AND WASTE DEPARTMENT
ENGINEERING DIVISION

WATER TREATMENT PLANT
ADMINISTRATION
FOUNDATIONS AND CONCRETE STRUCTURES

STRUCTURAL
ADMINISTRATION AREA
SECTIONS

CITY FILE NUMBER
SHEET OF
CITY DRAWING NUMBER
1-0601A-A-0201-001-01D