


NOTES:
 1. BACKGROUND HIDDEN LINES REVISED OR SHOWN FOR CLARITY.

PLAN AT ELEVATION 240.740
 1:100

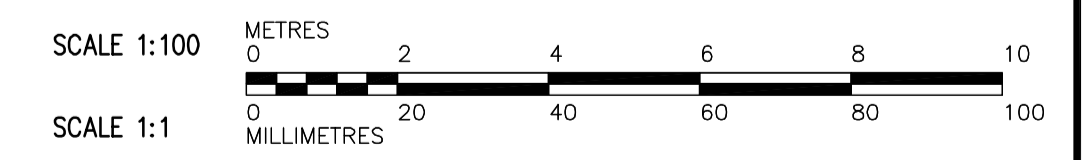

 APEGN Certificate of Authorization CH2M HILL Canada Ltd. No. 1441 Expiry: April 30, 2006	 Frederickson Cooper ARCHITECTS	 A Terra International Ltd. Company	ENGINEER'S SEAL ORIGINAL SIGNED BY P. WOBMA 2006/02/06	 THE CITY OF WINNIPEG WATER AND WASTE DEPARTMENT ENGINEERING DIVISION WATER TREATMENT PLANT FILTRATION FOUNDATION AND CONCRETE STRUCTURES PROCESS MECHANICAL PIPE EMBEDS FILTRATION AREA 1 UPPER CHANNEL LEVEL PLAN	CITY FILE NUMBER
	DESIGNED BY TB/PW CHECKED BY LS	APPROVED BY DJT	SHEET OF		
	DRAWN BY TAR/EK SCALE: 1:100	RELEASED FOR CONSTRUCTION BY: R. SOROKOWSKI	CITY DRAWING NUMBER 1-060F-A-M9121-001-0D		
	NO. REVISIONS DATE BY DATE 2005/07/08 DATE 2006/02/08	CONSULTANT DRAWING NO. WF-M9121			